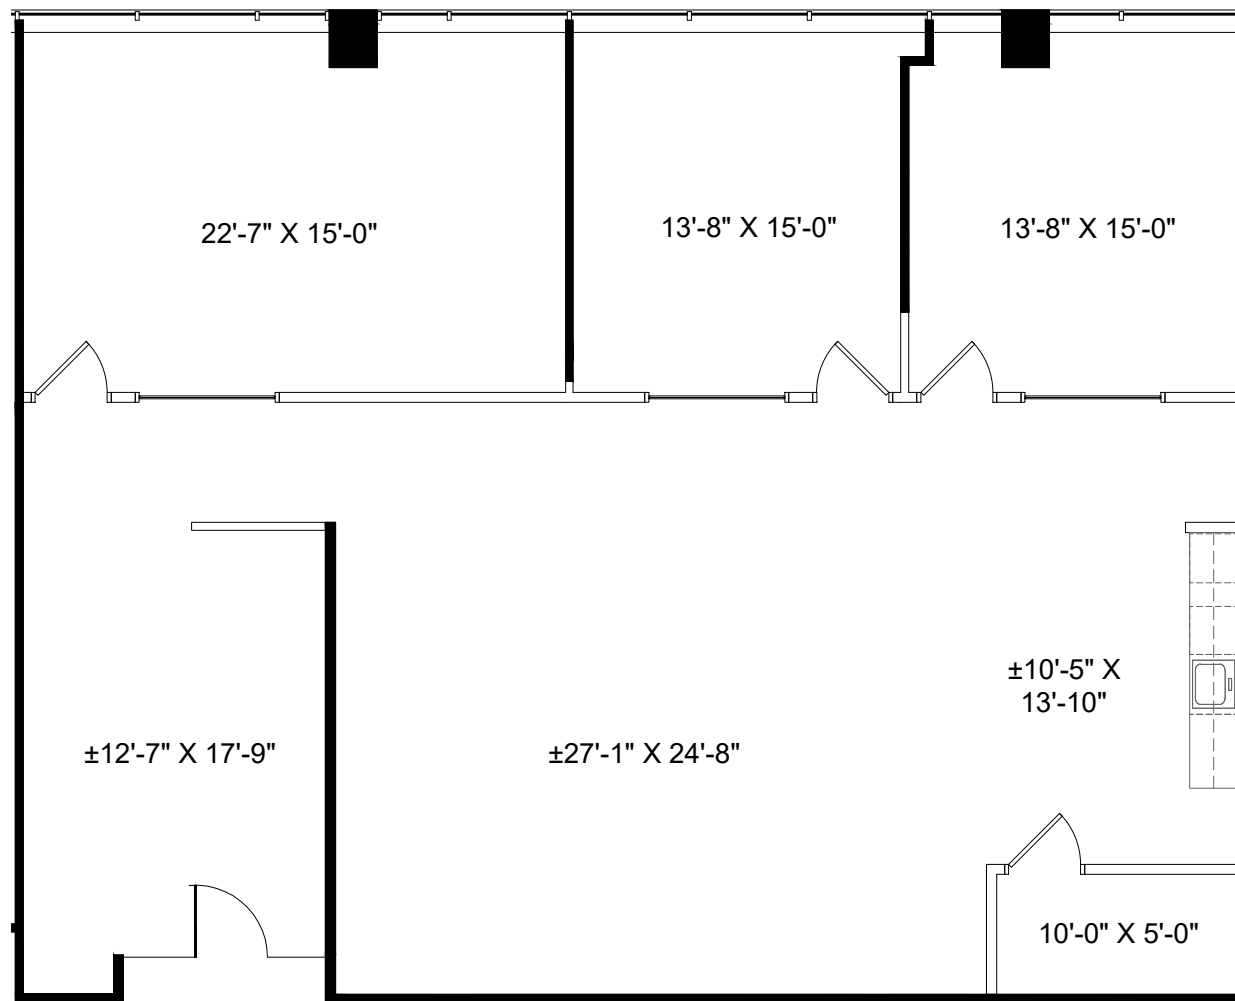


ALL DIMENSIONS ARE APPROXIMATE AND SUBJECT TO NOMINAL VARIANCE.

WESTERN SECURITIES
ESTABLISHED · 1932

Uptown Center

2626 HOWELL STREET
DALLAS, TEXAS 75204

AS-BUILT PLAN SUITE 950

rsf: 2,433

scale: 1/8" = 1'-0"

date: 12.23.2025



1201 main street
suite 1370
dallas, texas 75202
214.420.4646