

REVISIONS

DATE	NO.	DESCRIPTION
6/10/2019	1	REVIEW COMMENTS
8/7/2019	2	FIELD CONDITIONS
10/2/2019	3	CHIEF'S COUNTER
10/22/2019	4	CHIEF'S COUNTER POWER

ATOMIC
4144 Pennsylvania Ave
KC, MO 64111
NEW KITCHEN DESIGN


PROJECT NUMBER:	902412
DATE:	5/13/2019
SCALE:	1/4" = 1'-0"
DRAWN BY:	RBR
APPROVED BY:	--

SHEET TITLE
FOODSERVICE EQUIPMENT
PLAN

SHEET NUMBER

QF100

THIS DOCUMENT WAS ORIGINALLY PRINTED ON A 37" X 47" AEE SHEET.

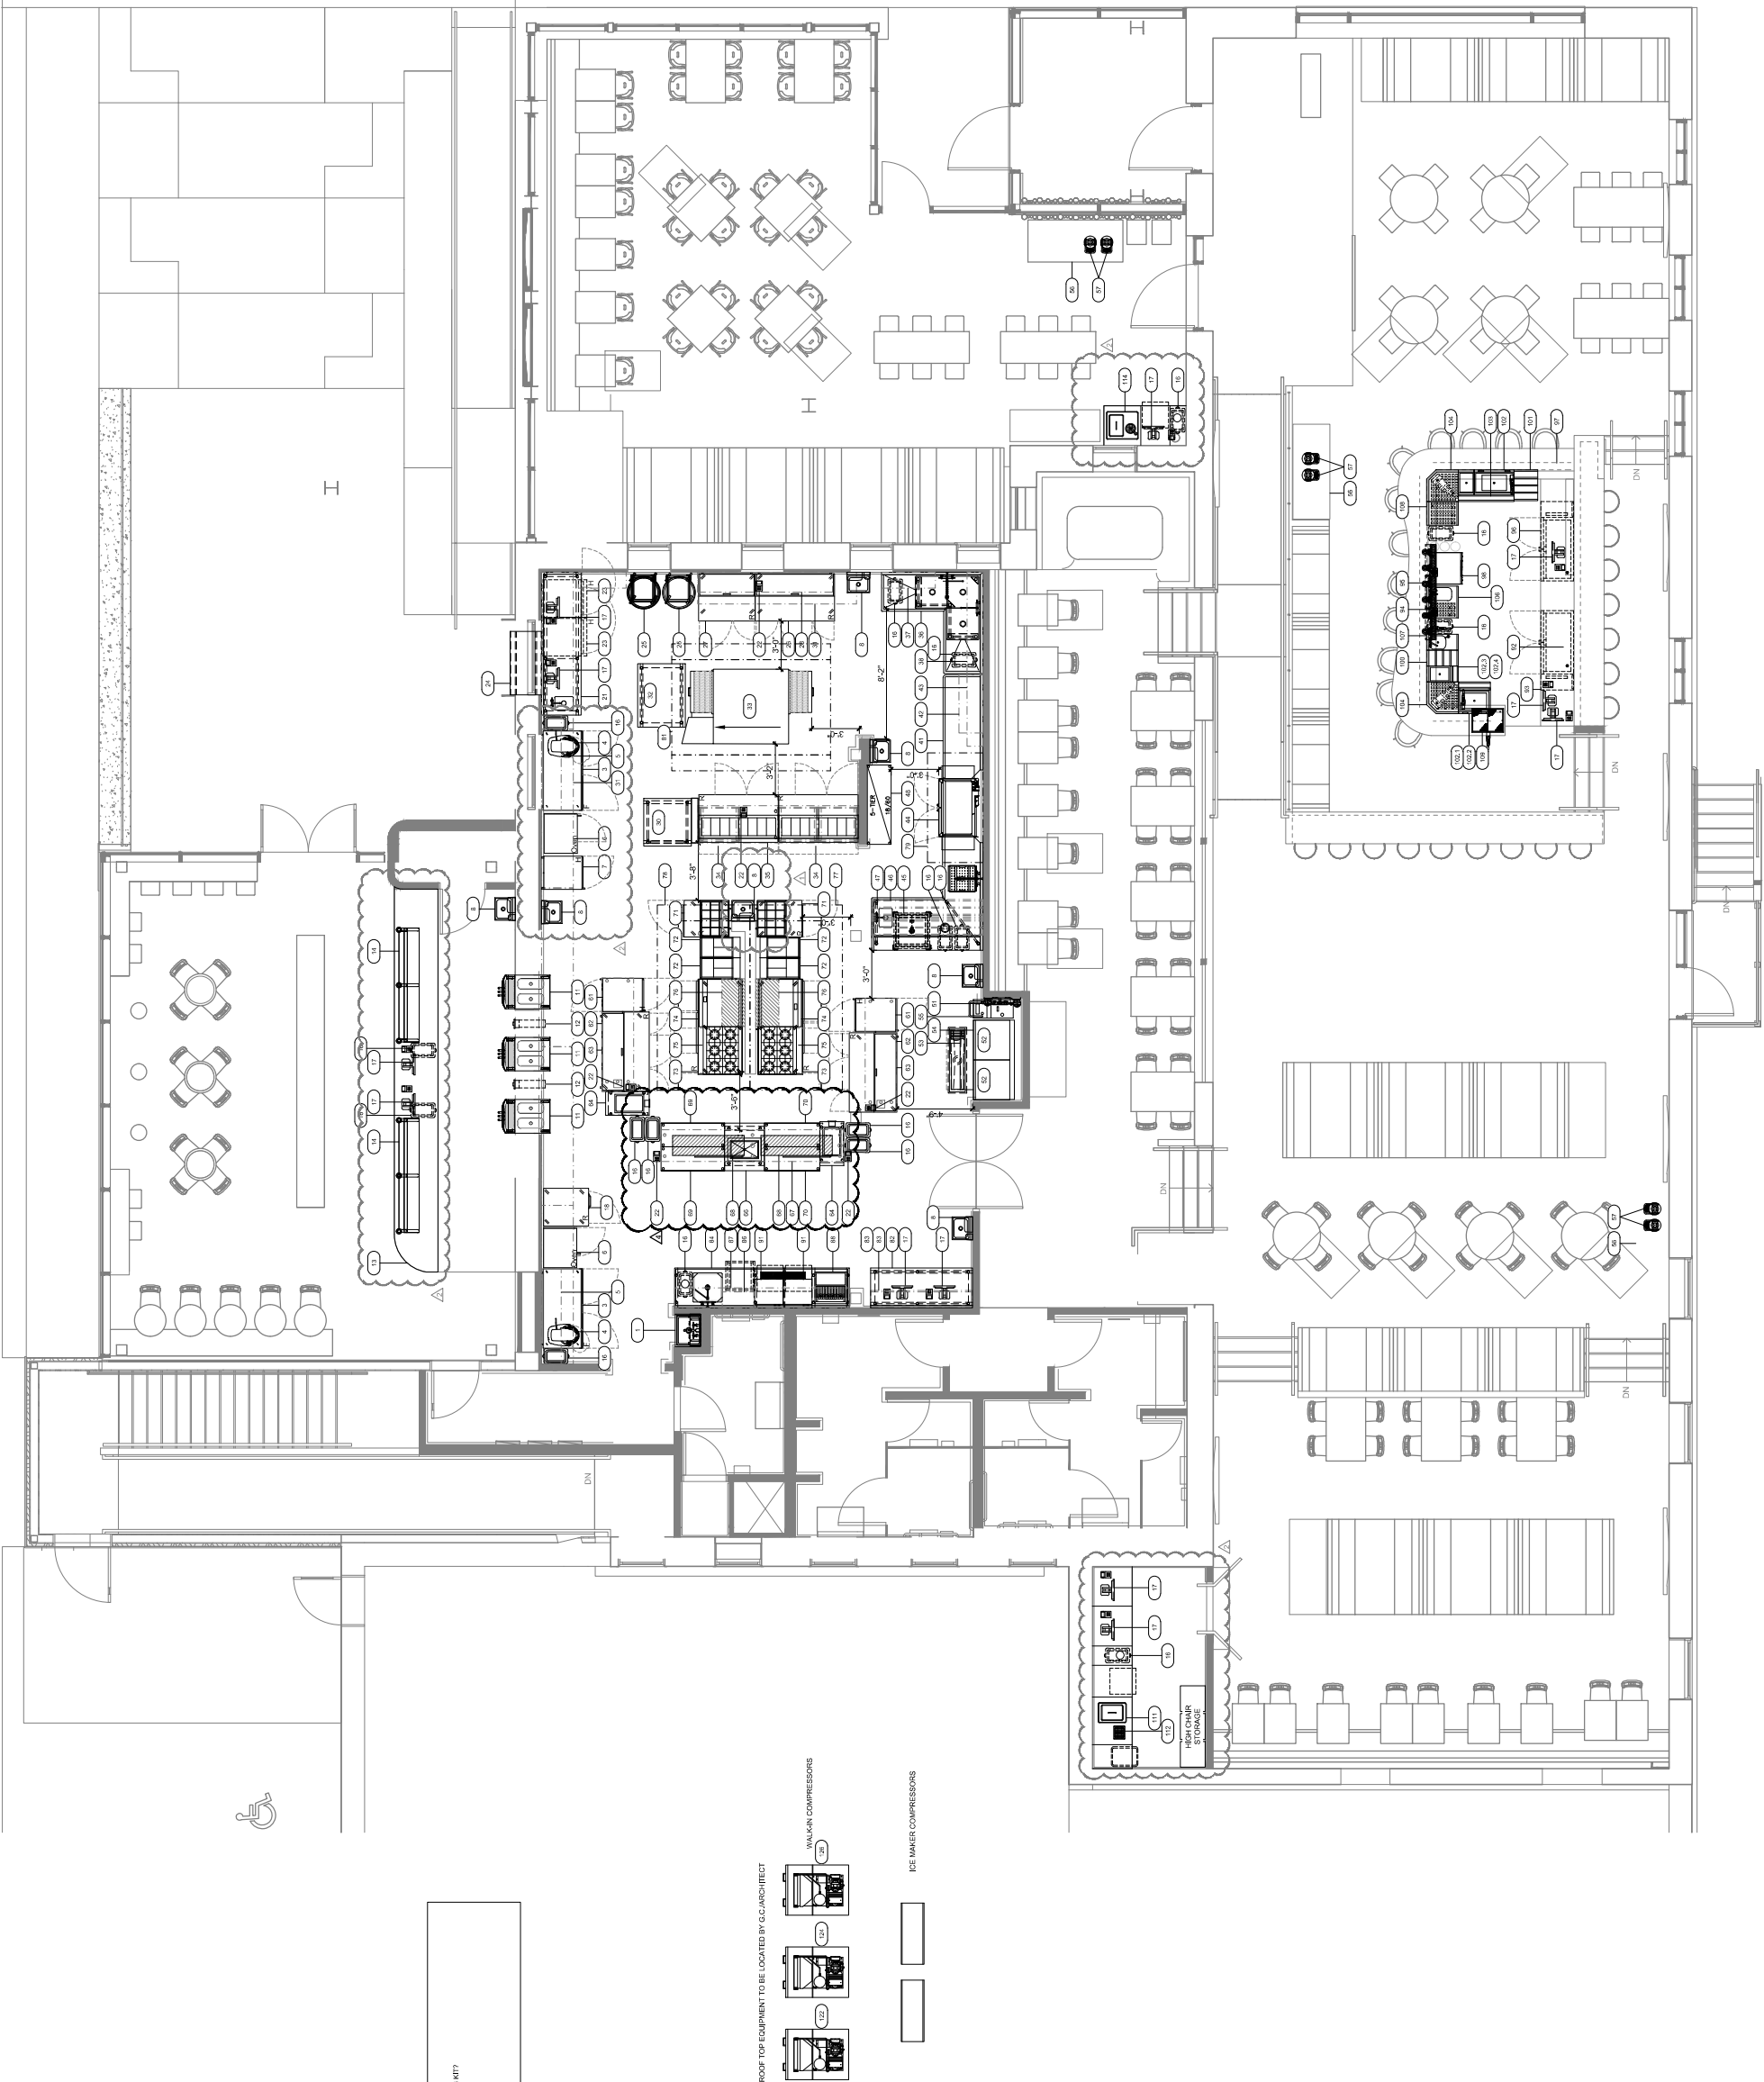

ISSUES PENDING:
- DRAIN WATER TEMPERING #177

ROOF TOP EQUIPMENT TO BE LOCATED BY GC CARD-DIRECT

WALK-IN COMPRESSORS

ICE MAKER COMPRESSORS