


OLD BUS BARN BUILDING

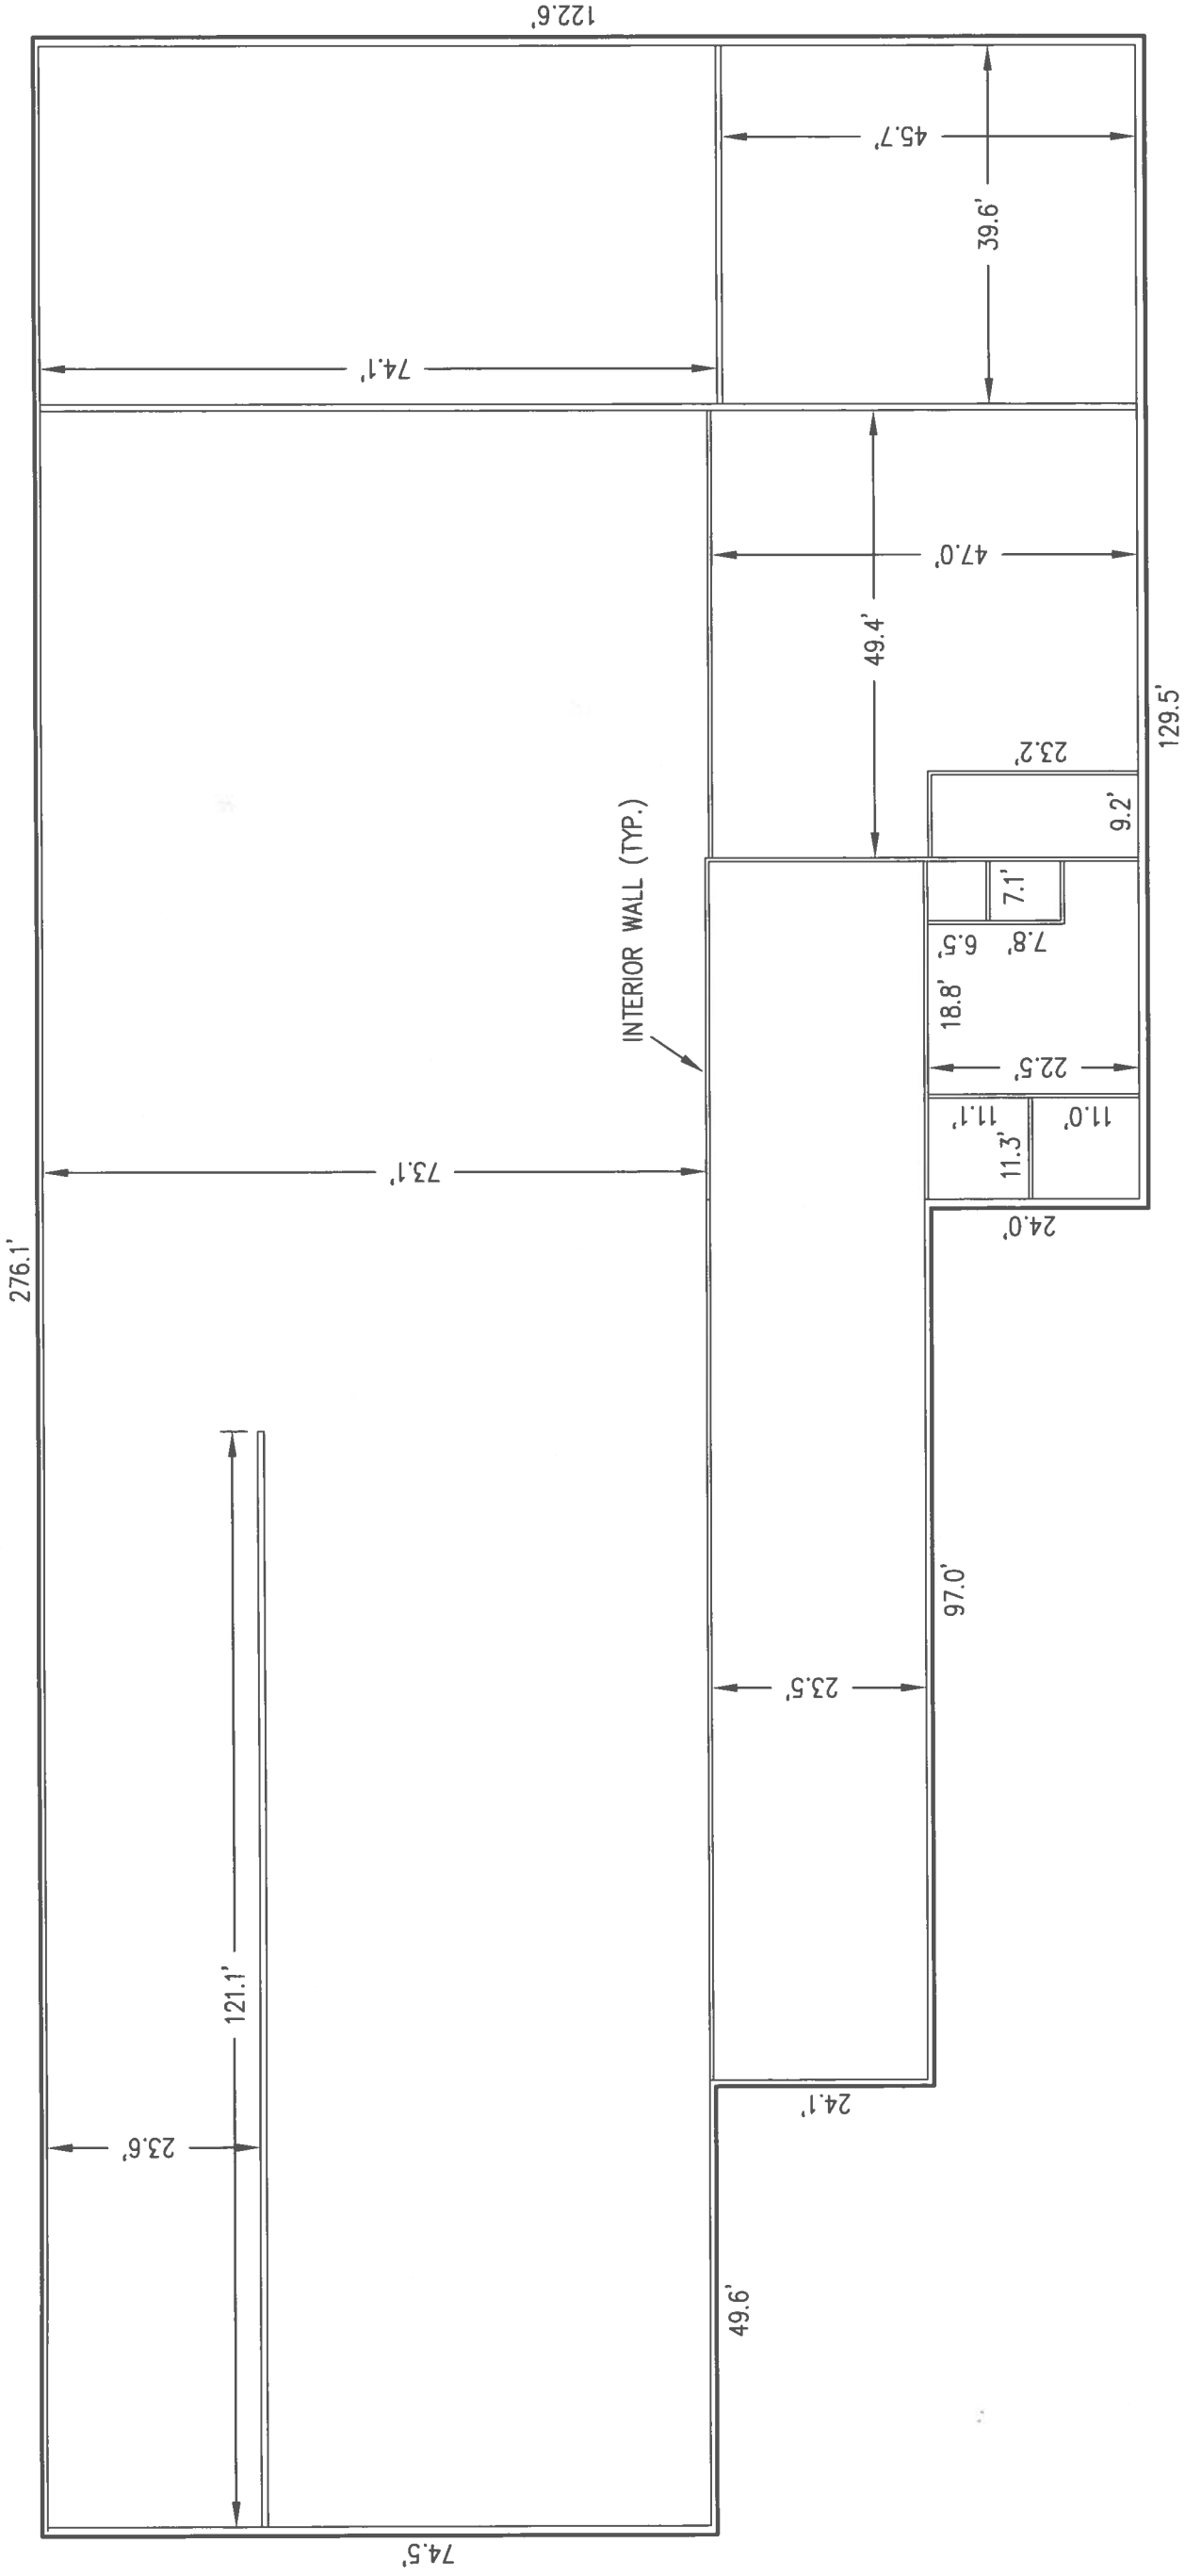

ARCHITECT/CONTRACTOR SHOULD FIELD VERIFY FLOOR PLAN
PRIOR TO REMODEL/INTERIOR DESIGN

V1

DATE: 8/9/2024

CHECKED:

DRAWN: JS

MOOSE CREEK BUS BARN
ASBUILT FLOOR PLAN
FOR: AK COMMERCIAL PROPERTIES

SALCHA, ALASKA

LOCATION:

STUTZMANN
ENGINEERING
ASSOCIATES, INC.
P.O. BOX 71429, FAIRBANKS, AK 99701
9 ADAK AVENUE, FAIRBANKS, AK 99701
(907) 452-4094 (C 627)