


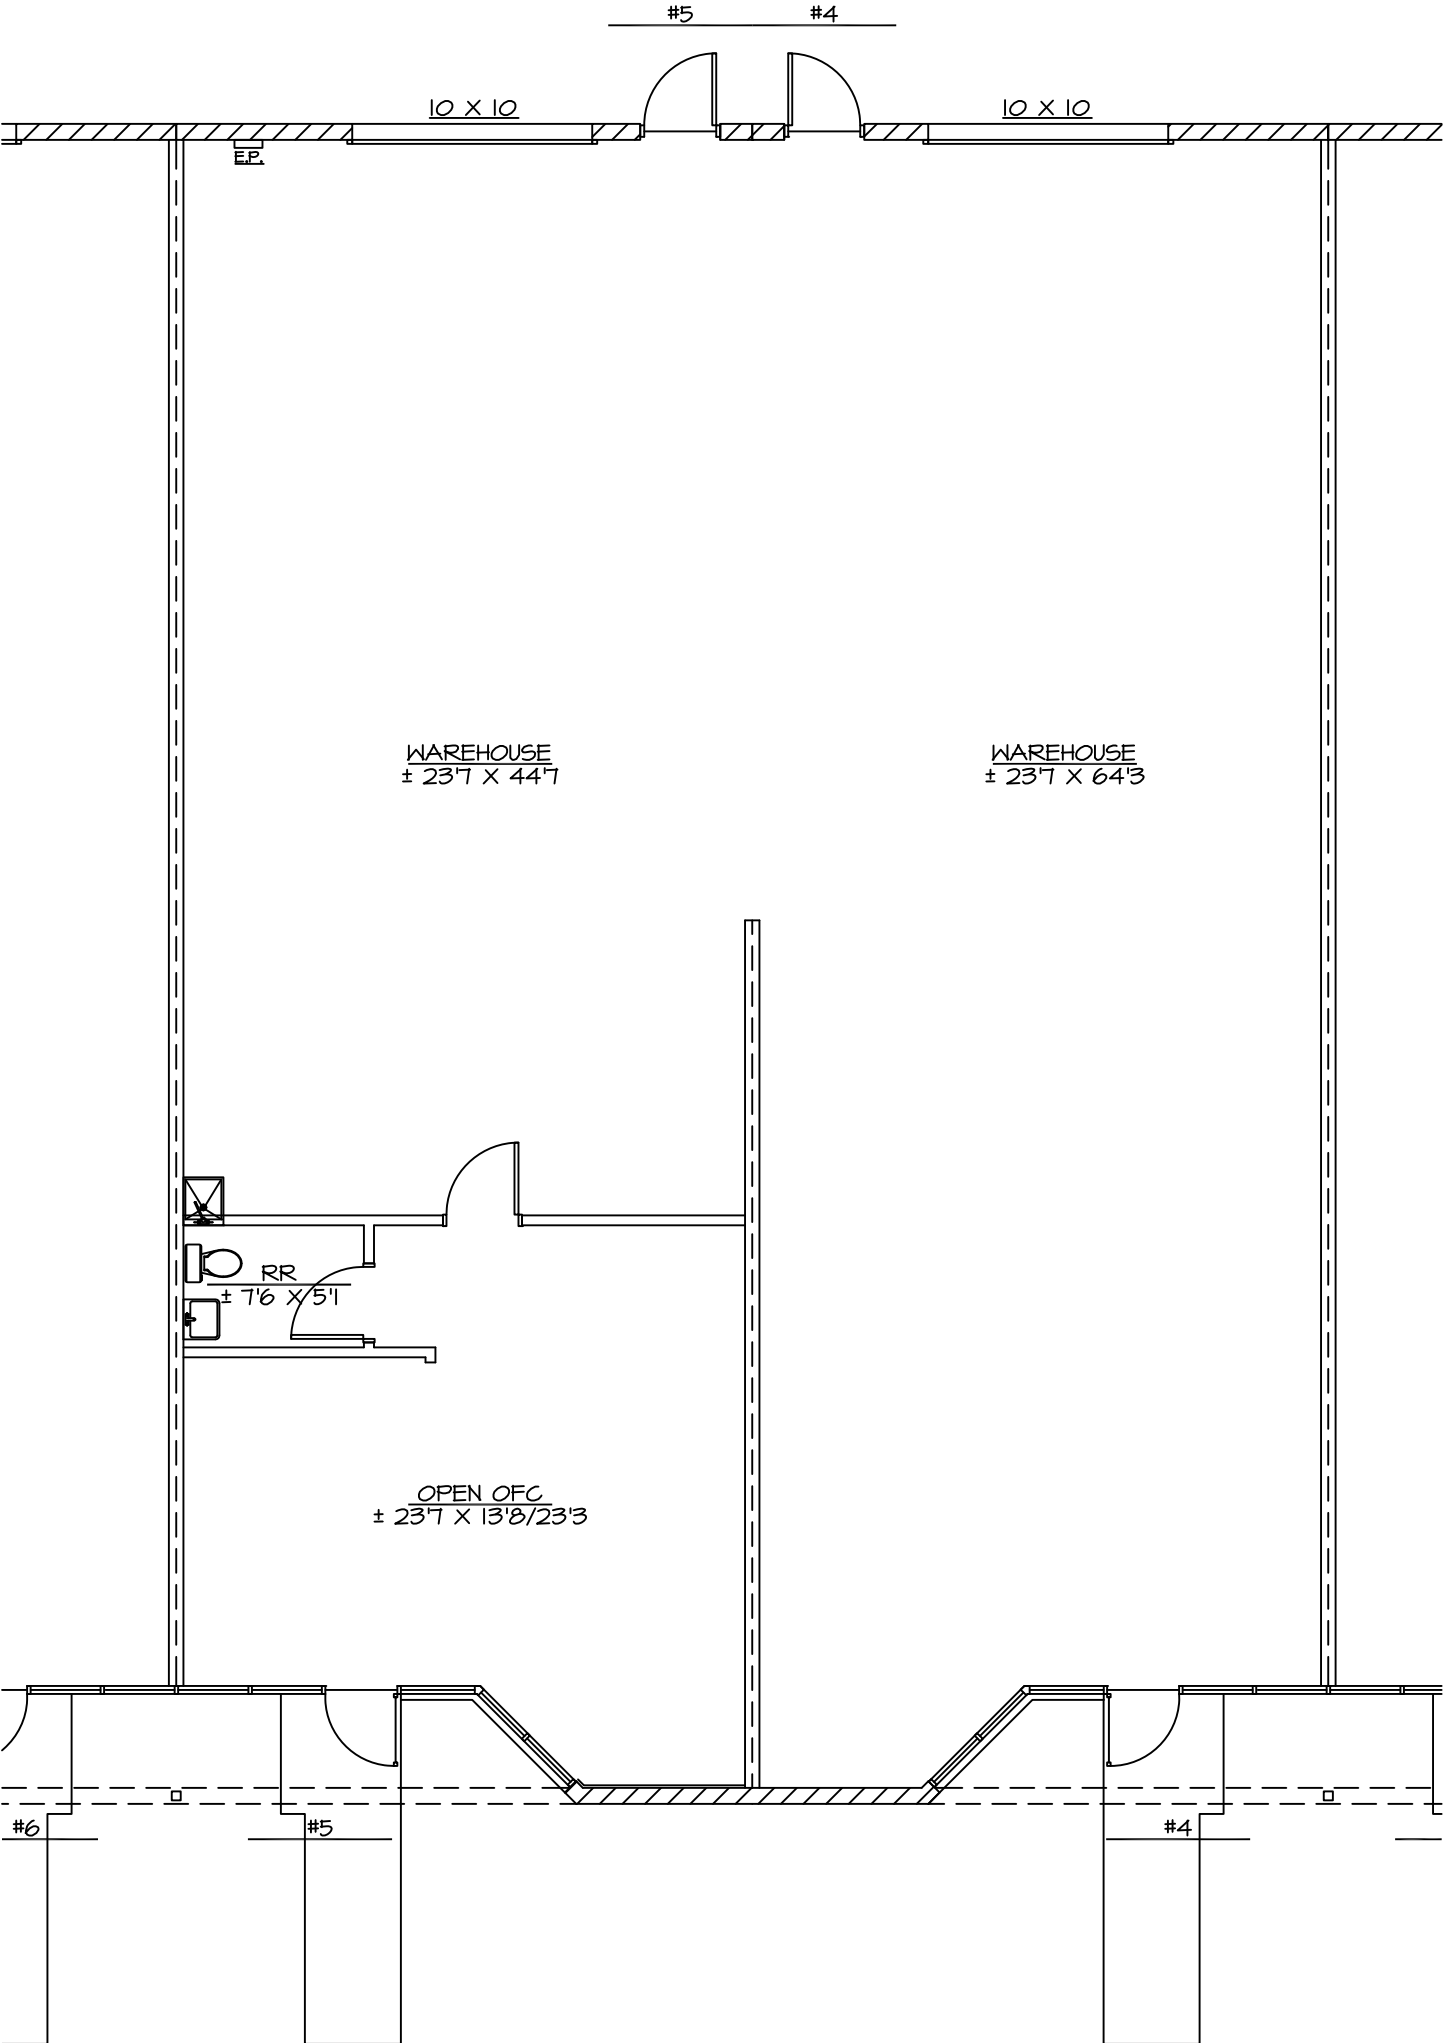

FLOOR PLAN

1/8"



DEER VALLEY AIR PARK

SWC 7th AVE & DEER VALLEY RD PHOENIX, AZ 85027

702, #4-5 (AS-BUILT) (3360 sf R)

JOB # 2323-03

5-21-2024

DRAWN BY: JT