


GROUND FLOOR

SCALE: 1/4" = 1'-0"

A

# As-Built Plan

1645 D Street  
Sparks, NV 89431

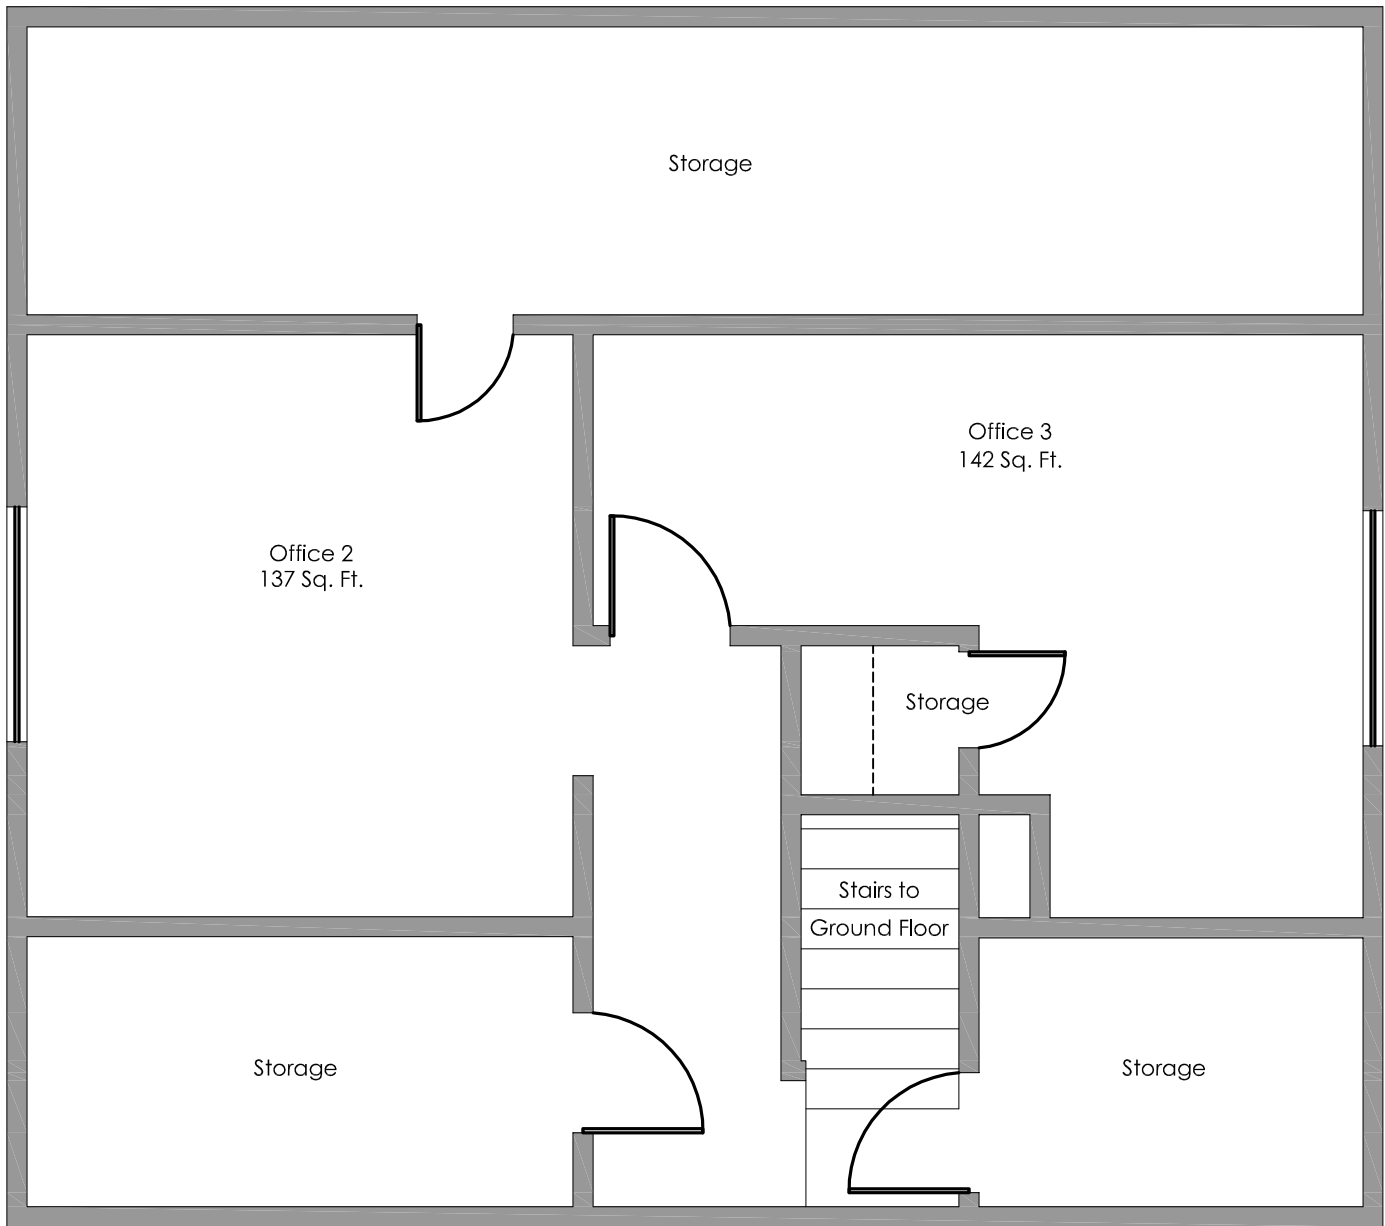

SECOND FLOOR

SCALE: 1/4" = 1'-0"

B

# As-Built Plan

1645 D Street  
Sparks, NV 89431