




Warming Pantry Elevation

12

SYM	FLOOR	BASE	WALLS	CEILING	REMARKS
A	EXISTING SIDEWALK	NONE	CEMENT FIBER PAINTED	EXIST. PAINTED	SEE WALL SECTIONS FOR RATED WALLS AND CEILING SYSTEMS CLEAN SIDEWALK SURFACE
B	CARPET	4" RUBBER	GYP BD PAINTED	GYP BOARD PAINTED	NEW GYP BD INSTALLED ON EXISTING FURRING AT EXIST. WALL STEPS TREAD & RISER TO BE RUBBER COVERED
C	VINYL	4" RUBBER	GYP BD/BRICK PAINTED	EXPOSED INSUL LINER & STRUCT.	NEW GYP BD INSTALLED ON EXISTING FURRING AT SOUTH WALL NORTH WALL TO BE EXPOSED BRICK PAINTED
D	CONCRETE	4" RUBBER	GYP BD/BRICK PAINTED	GYP BOARD PAINTED	NORTH WALL TO BE EXPOSED BRICK PAINTED
E	VCT	4" RUBBER	GYP BD PAINT	GYP BOARD PAINTED	RUBBER FLOORING ON RAMP
F	VCT	4" RUBBER	GYP BD WB EXOXY PAINT	GYP BOARD PAINTED	
G	EXISTING/SUB-FLOOR	NONE	GYP BD/BRICK PAINTED	EXPOSED INSUL LINER & STRUCT.	


Finish Schedule

4

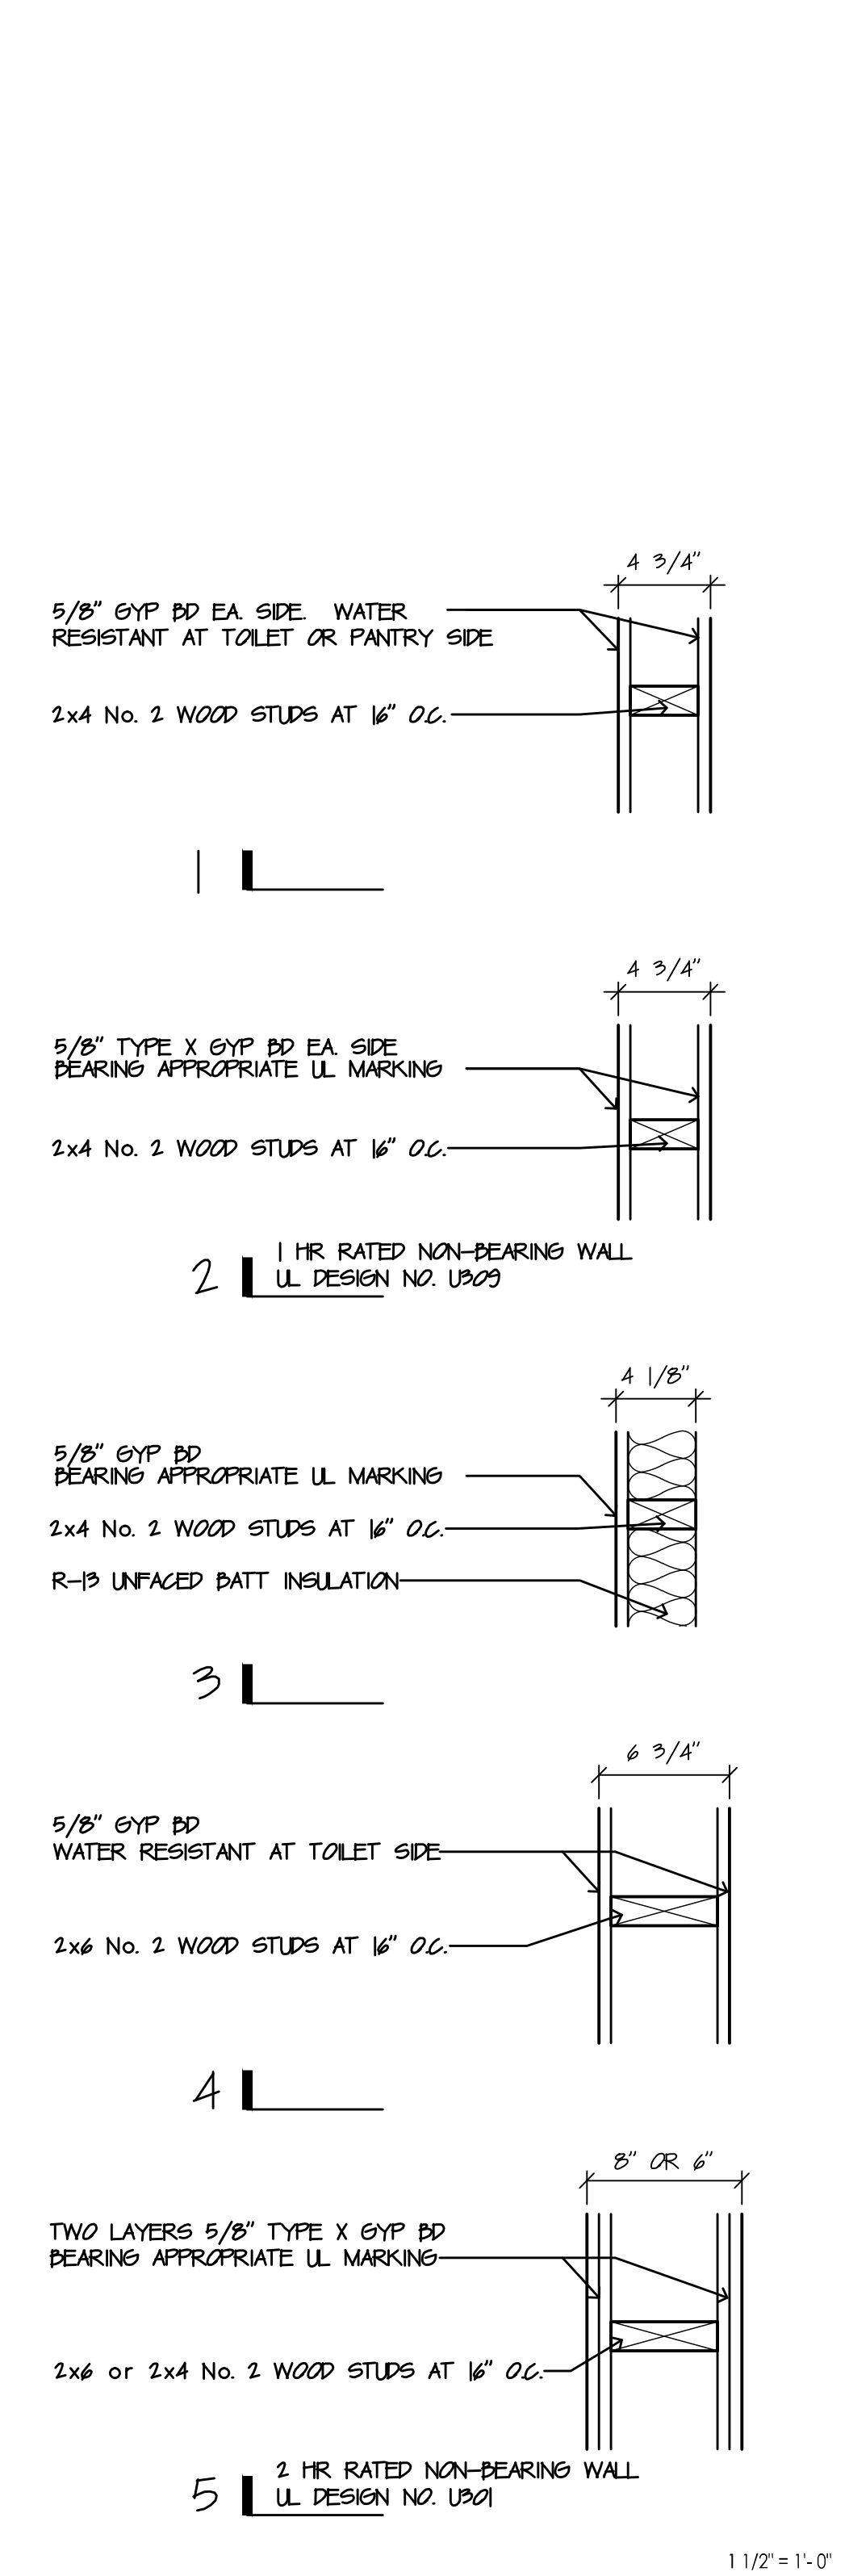

Wall Types

18

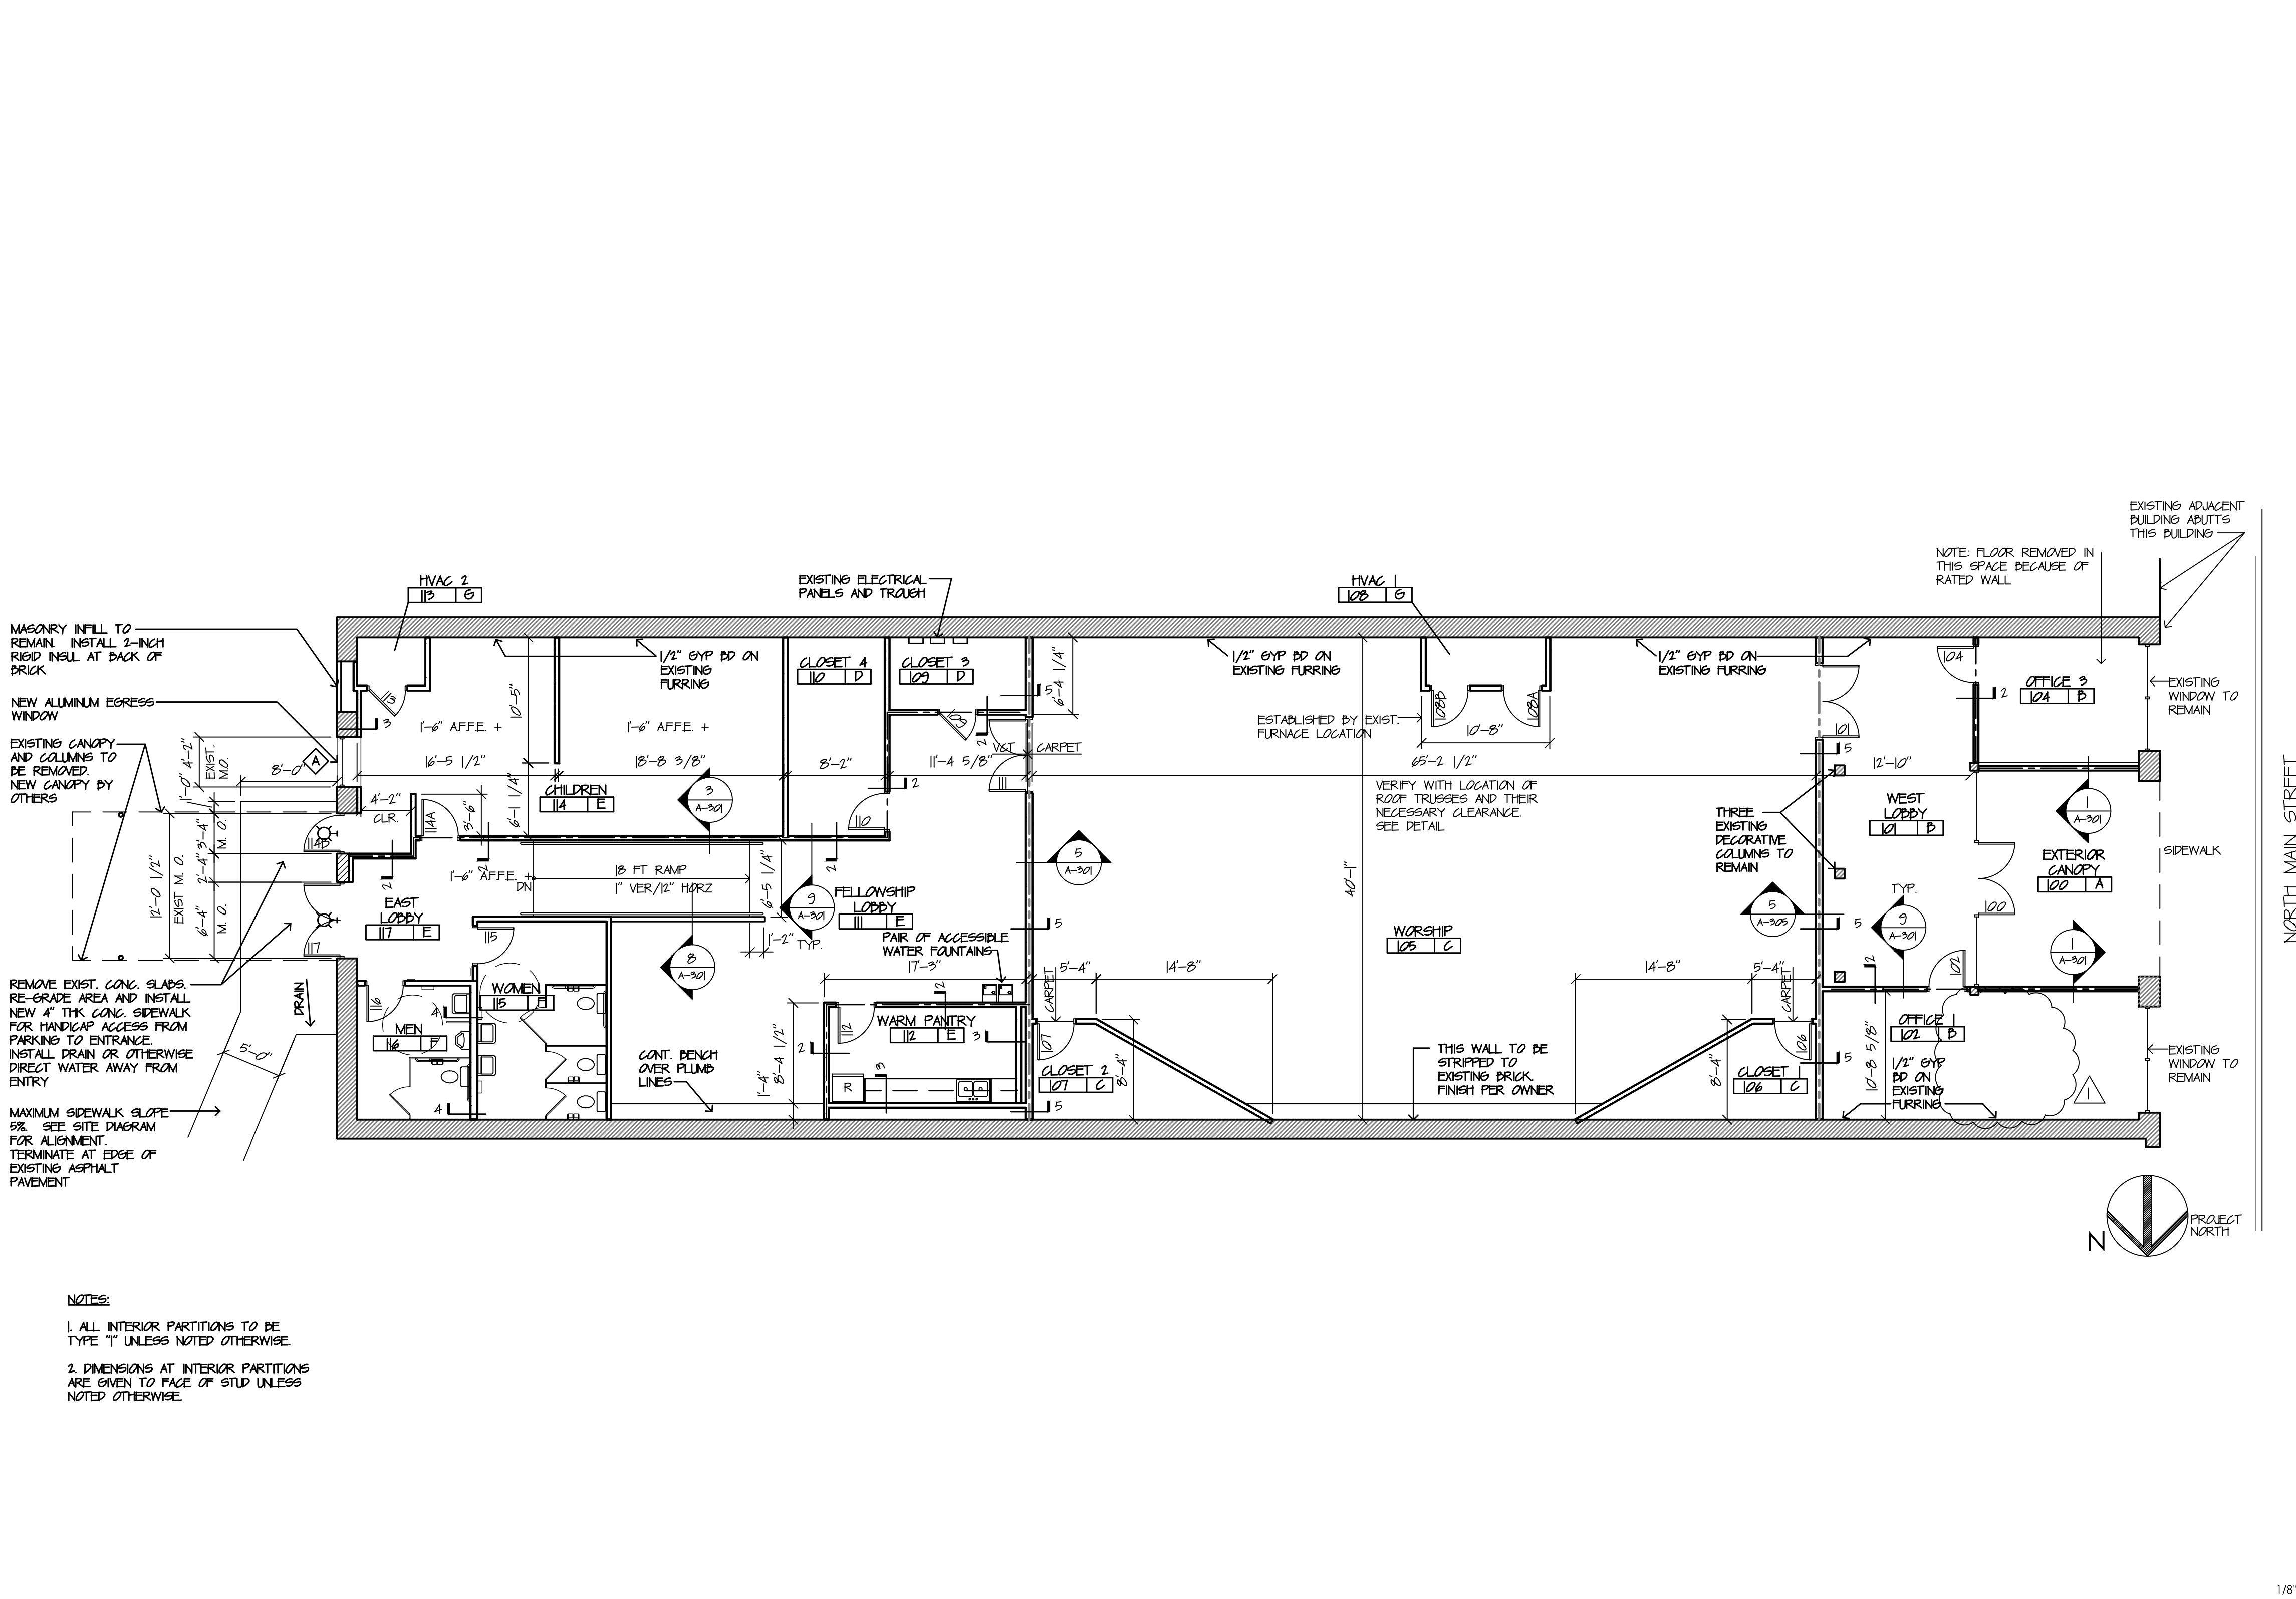

Floor Plan


1

Garner & Brown Architects PA

1718 East Boulevard  
Charlotte, North Carolina 28203  
704 333 1051 fax 704 376 6546

Copyright 2016

CONSULTANTS

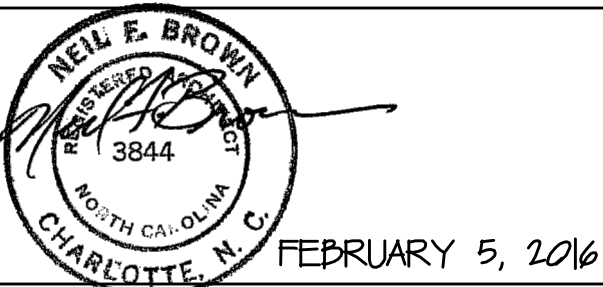

FINISH LINE  
CHRISTIAN  
CENTER

108 North Main  
Mount Holly,  
North Carolina

REVISIONS  
MARCH 2, 2016  
PLAN REVIEW REVISIONS

Project Number  
Date February 5, 2016  
Drawn by:  
Checked by:

Floor Plan  
Finish Schedule  
Wall Types

A-121