




# AS BUILT FLOOR PLAN

22421-22429 HESPERIAN BLVD  
HAYWARD, CALIFORNIA

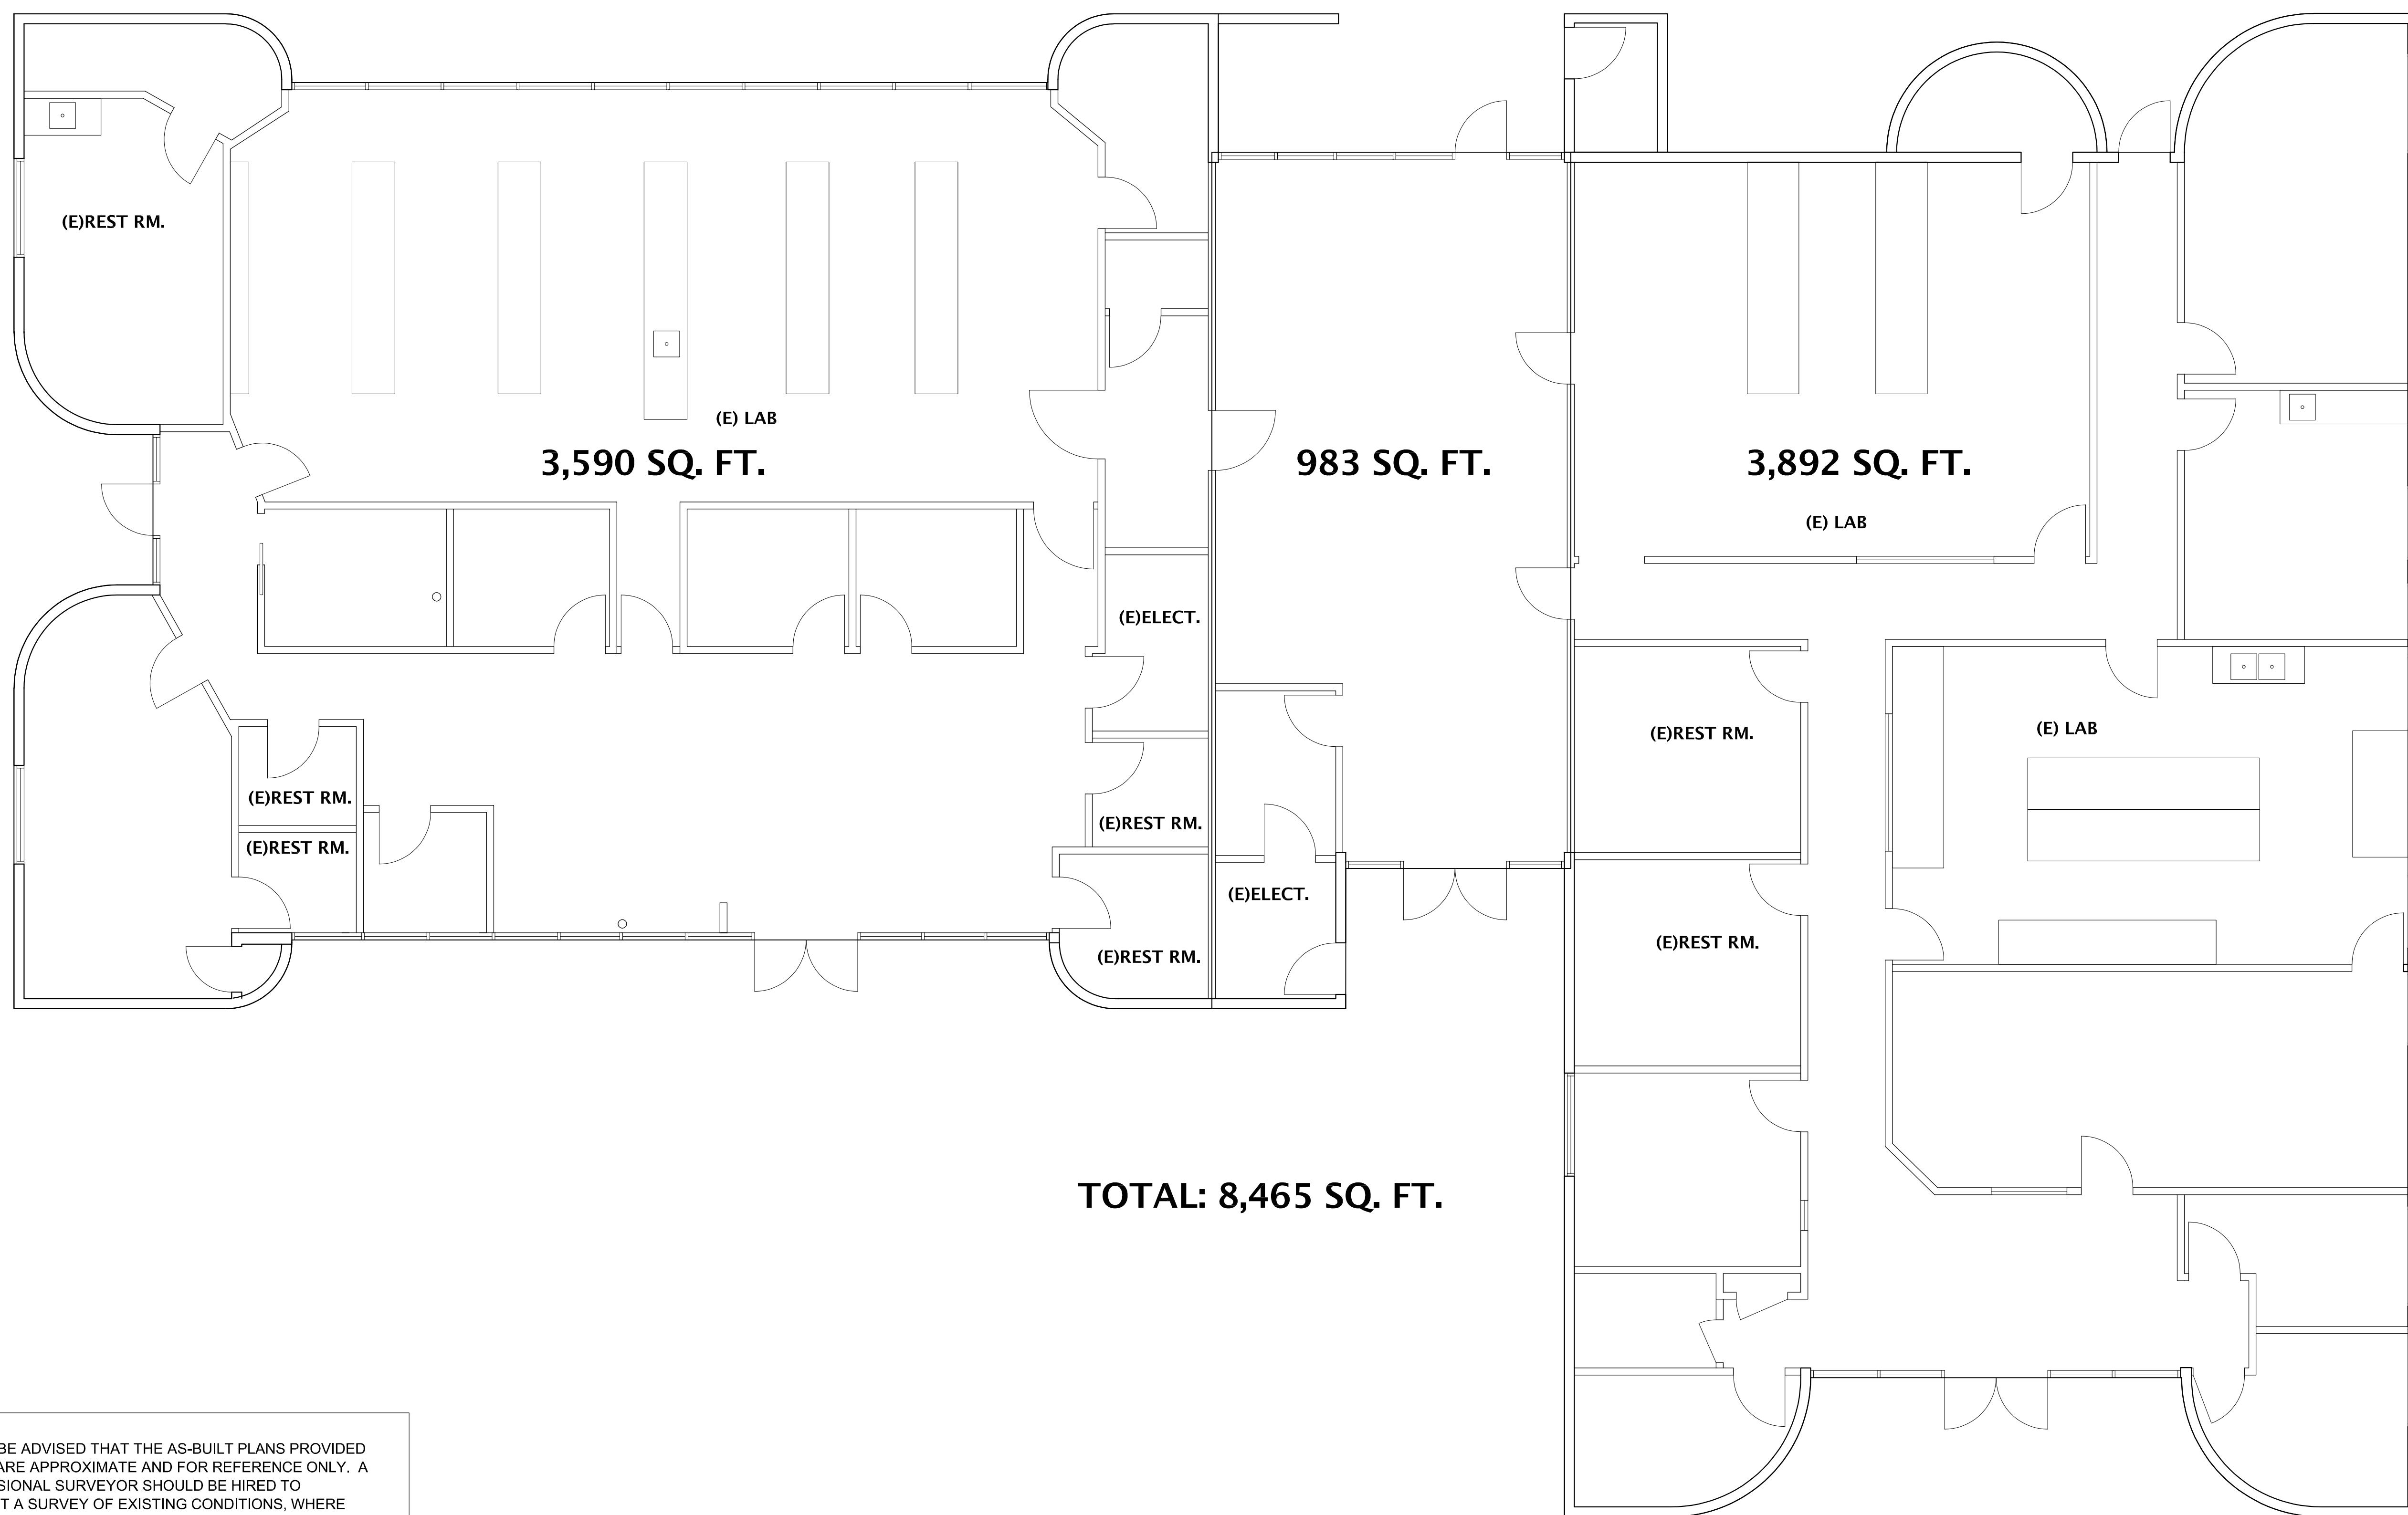

PLEASE BE ADVISED THAT THE AS-BUILT PLANS PROVIDED HEREIN ARE APPROXIMATE AND FOR REFERENCE ONLY. A PROFESSIONAL SURVEYOR SHOULD BE HIRED TO CONDUCT A SURVEY OF EXISTING CONDITIONS, WHERE ABSOLUTE ACCURACY IS REQUIRED.

## 1. EXISTING FLOOR PLAN

$$3/16" = 1'-0"$$

## **EXISTING FLOOR PLAN**

A2.0

DATE 12.12.2025	DRAWN S.L.
JOB NO.	CHECKED E.A.D.

All drawings and written material appearing herein constitute the original and unpublished work of E. A. DAVIDOVITS & CO. and the same may not be duplicated, used, or disclosed without written consent.

## EXISTING FLOOR PLAN