

NORMAN G. MORELL  
 ARCHITECT  
 5460 NORTH BROADWAY, PITTSFAN  
 NEW JERSEY 08801  
 (954) 589-0513 FAX (954) 589-4503


Norman G. Morell  
 N.J.L.C. 06441

JOB: (AS BUILT) EXISTING GREENHOUSE BUILDING  
 LOCATION: 4903 LAKE RD. NEWFIELD, N.J.

VISCONTI GREENHOUSES  
 (917) 681-2150  
 (718) 241-7771

DRAWN BY	CHECKED BY	DATE	JOB NO.	SCALE
DRAIN/R/S	CMH	3-13-2005	1009-23	1/8" = 1'-0"
SCALE AS NOTED				A-1

FLOOR PLAN  
 SCALE 1/8" = 1'-0"

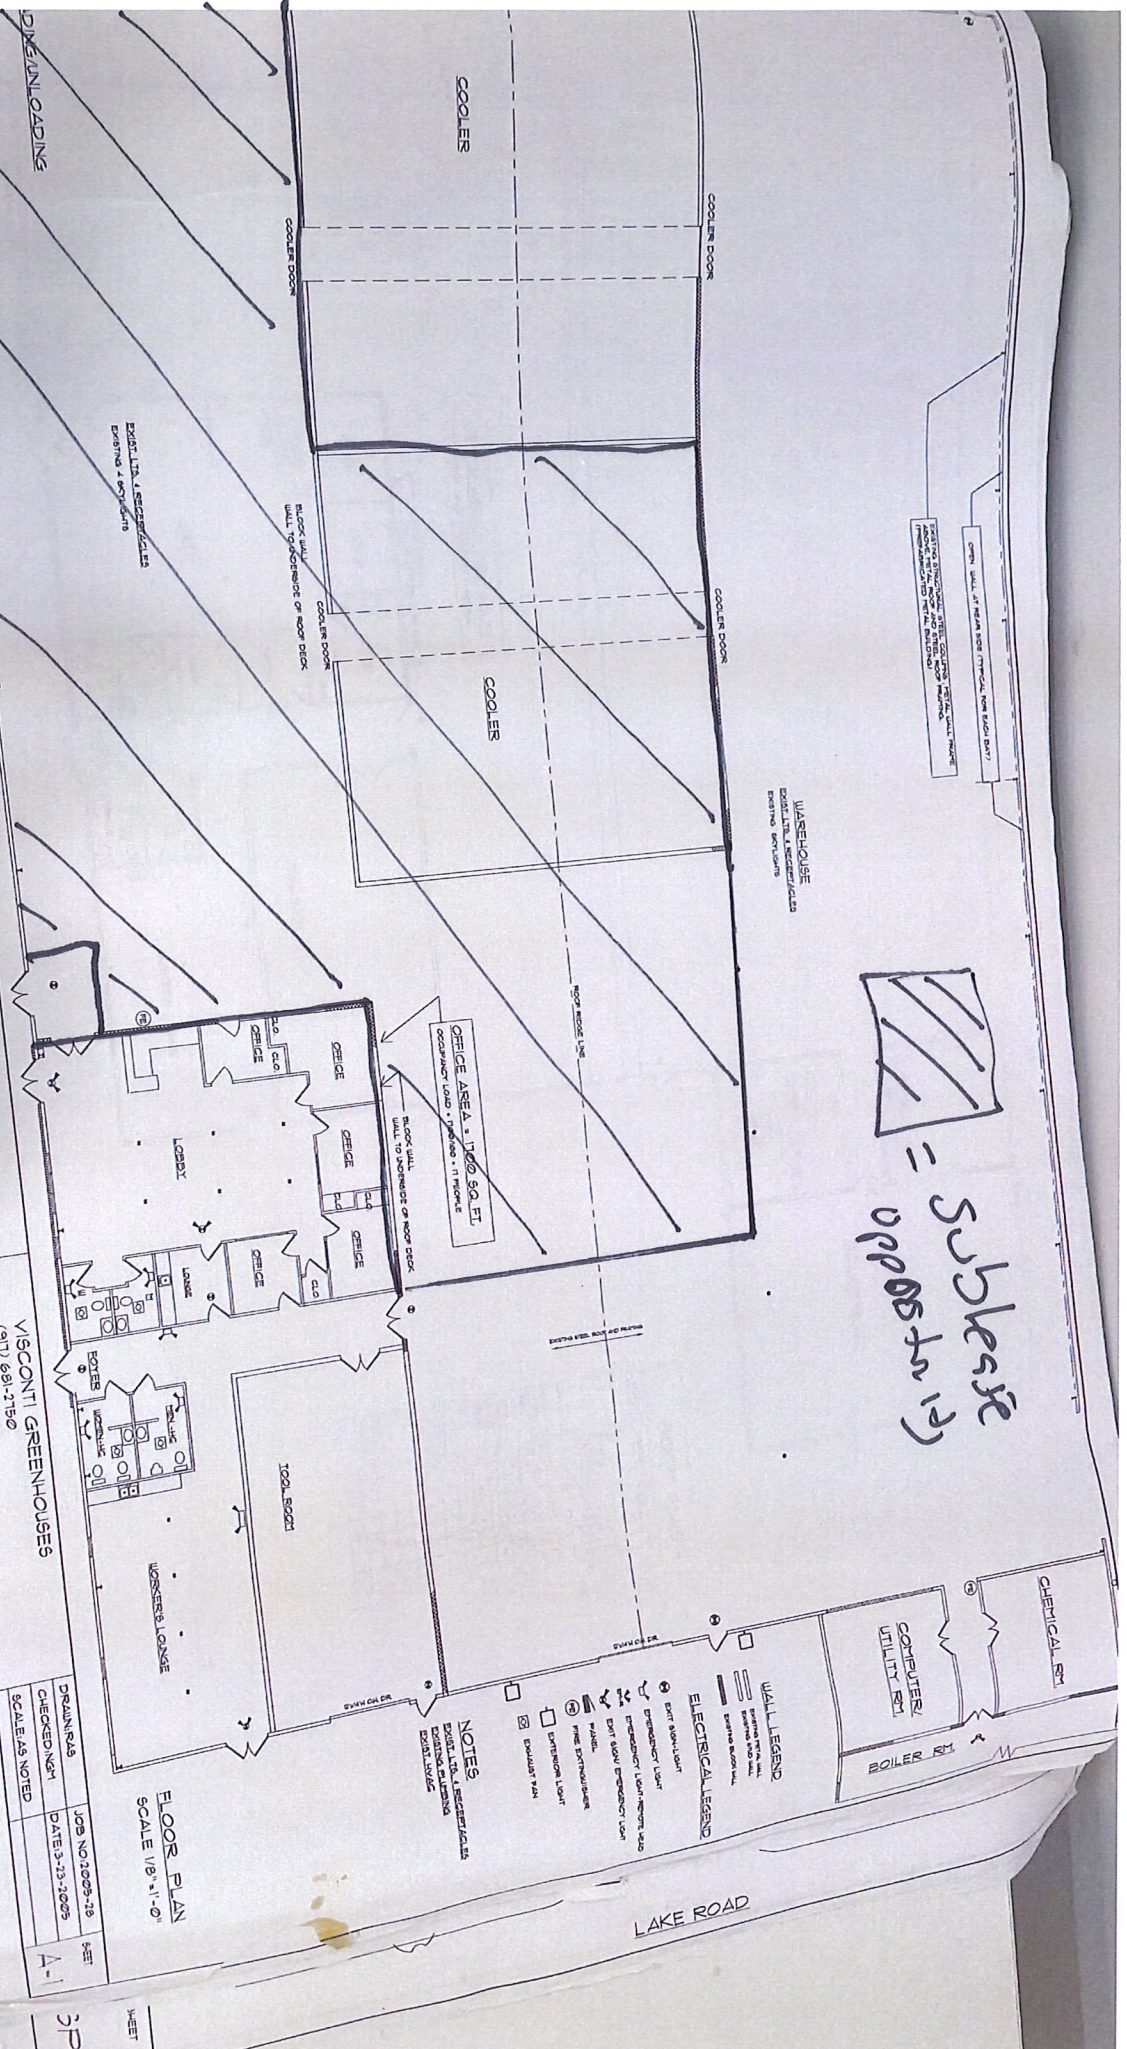

SUBLEASE  
 = Oppos for 12)

LAKE ROAD