
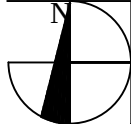


127 West Pepper Place
Mesa . Arizona
Suite 103 - 1,192 SF

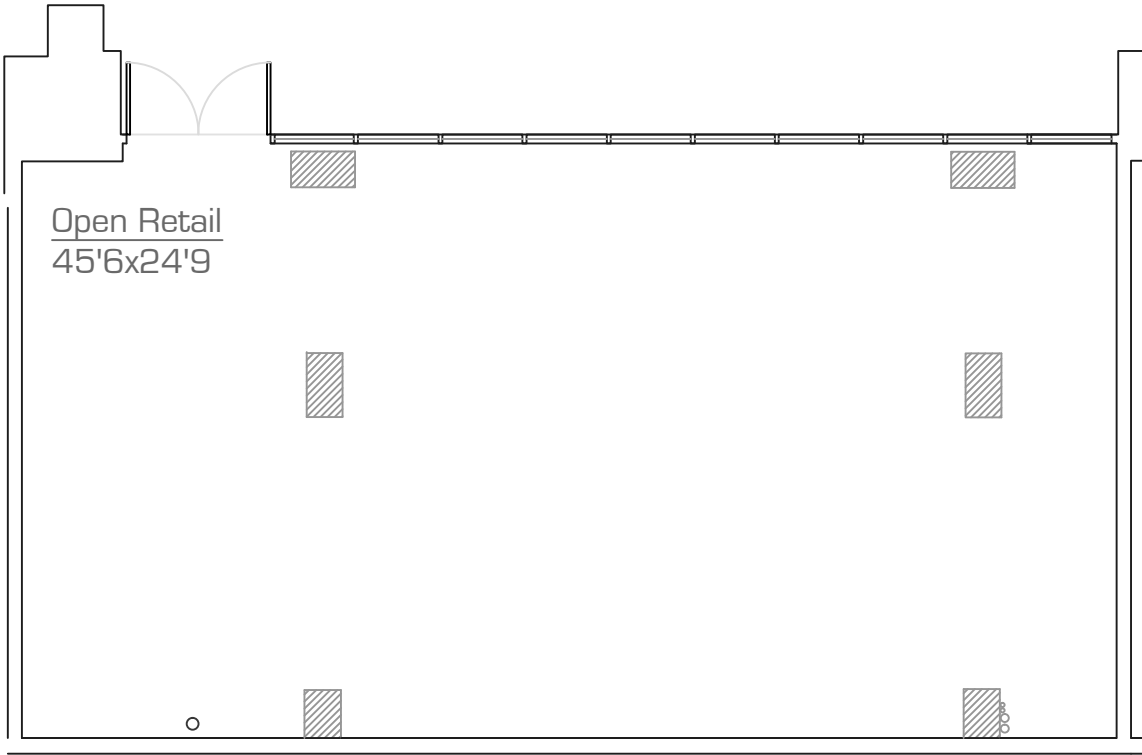


As-Built - floor plan

scale: 1/8" = 1'-0"

9.December.2024

*All dimensions are approximate at ± 3"

*All information is of general nature

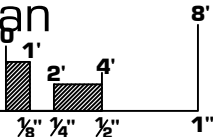

precisionDIMENSIONS

as-built & survey
602.790.6412

