


4TH AVENUE EAST

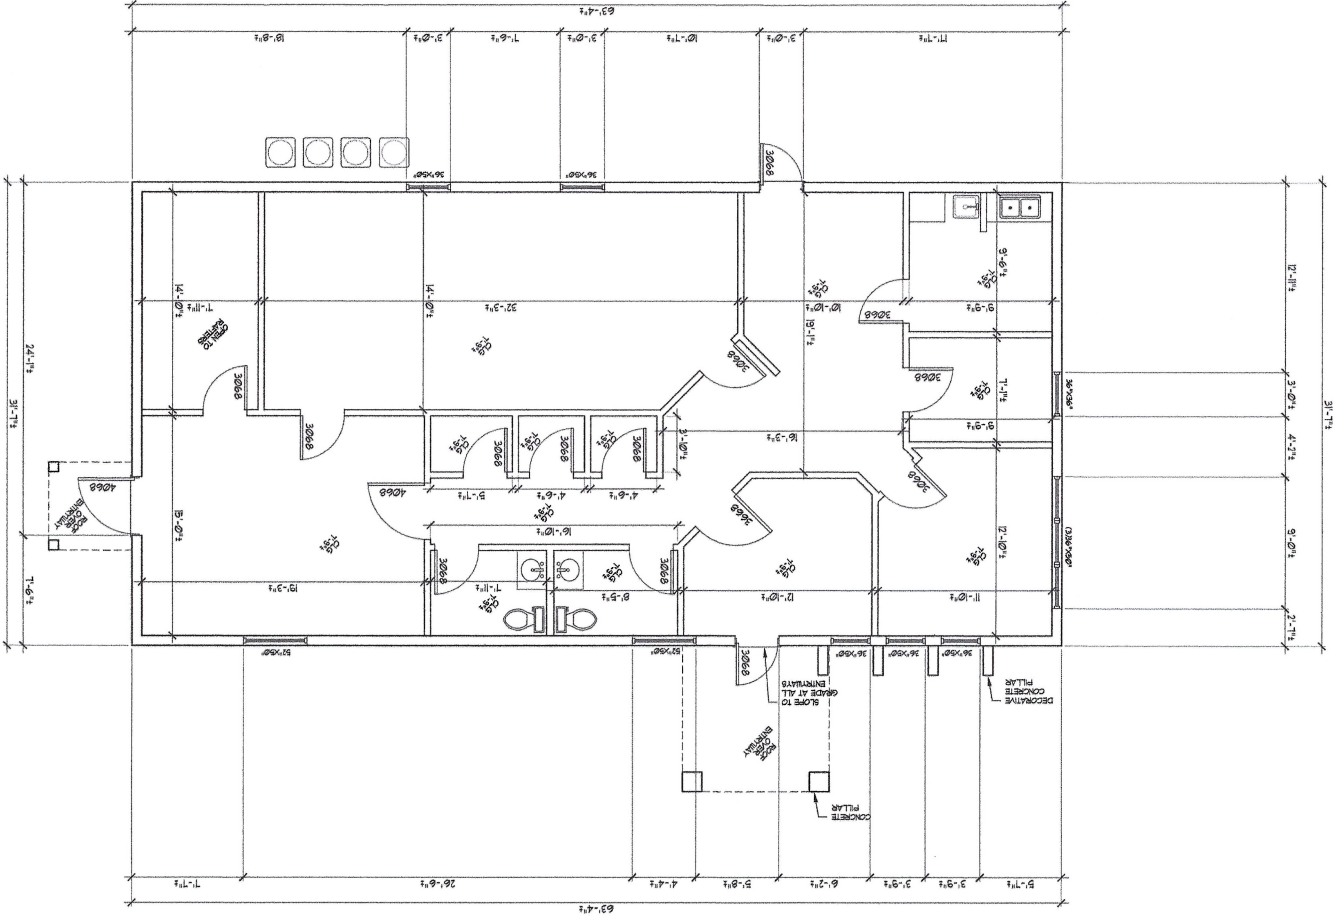

NOTE: ALL DIMENSIONS ARE APPROXIMATE BASED ON THE SKETCH PROVIDED AND THE AS-BUILT CONDITIONS MEASURED IN PLACE. EXACT MEASUREMENTS MUST BE FIELD VERIFIED.

SHEET #
1
OF **1**

Fine Impressions Studios
Drafting & Design
Jeffrey M. Wilson
920 59th Street West
Bradenton, FL 34209
941.576.5598

TITLE:
410 4th Avenue East
Bradenton, FL 34208

DATE: 06/07/23
SCALE: 1/4"=1'-0"
DRAWN BY: J.M.W.
CHECKED BY: J.M.W.

CLIENT: [Blank]
DESIGNER: [Blank]
REVISIONS: [Blank]