



# SHOWROOM WITH PALMETTO FRONTAGE

## WAREHOUSE SPACE FOR LEASE

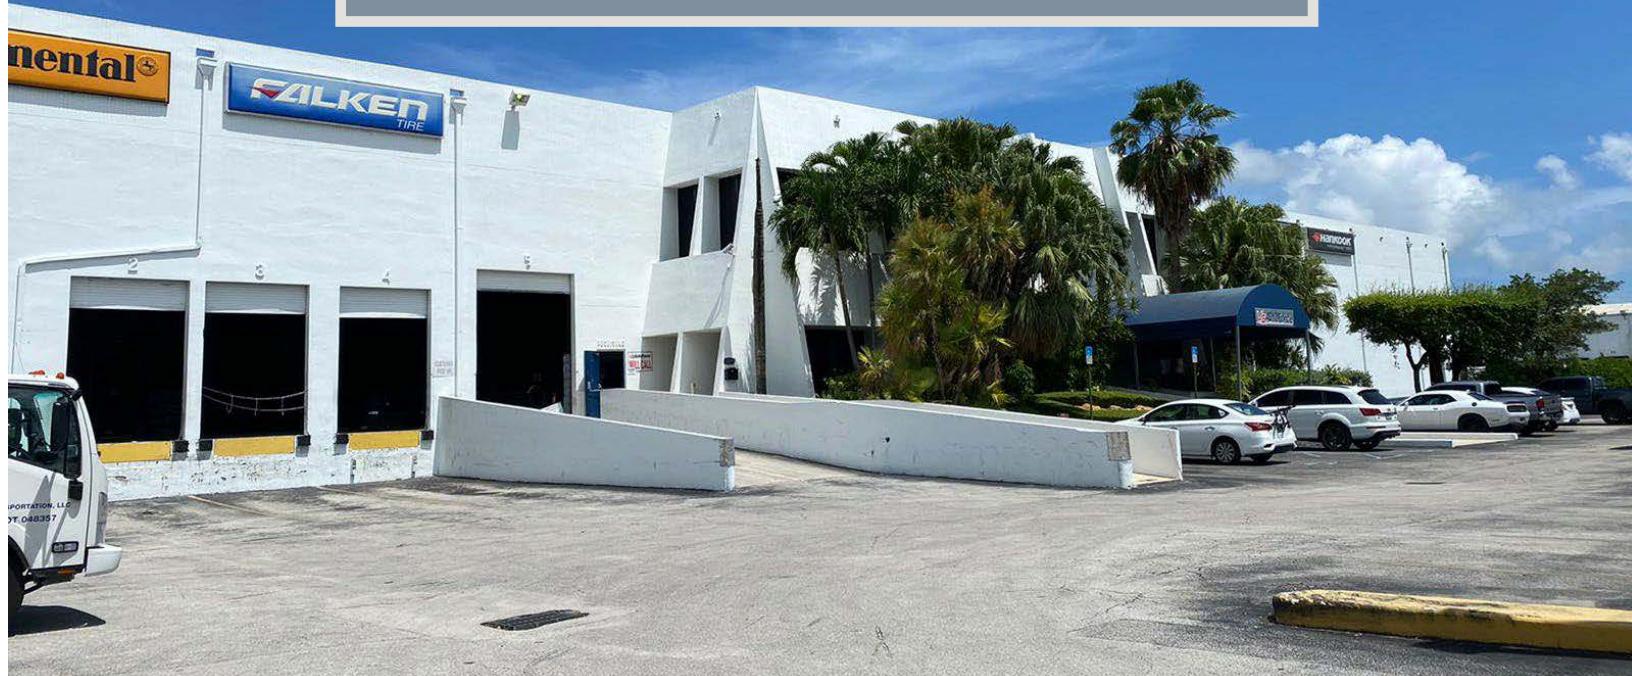

2875 NW 77th Avenue, Miami, FL 33122

### Location overview

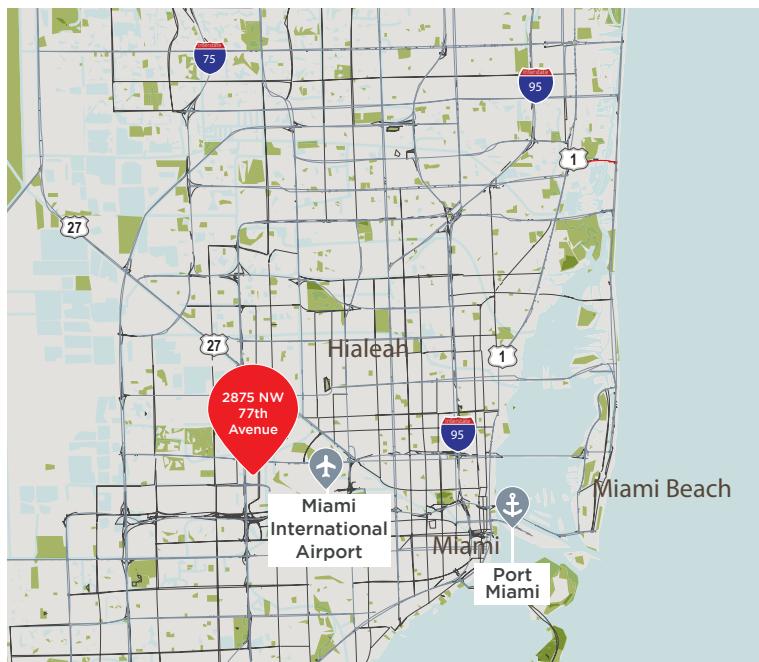

Excellent location in the heart of Doral with access to MIA & Port of Miami via Florida Turnpike and SR-826.




### Property overview

- 57,750 total sf
- 5,120 sf office - 2 floors
- Seven (7) dock-height doors with pit levelers
- One (1) concrete ramp
- 28' clear ceiling height
- Palmetto Expressway frontage
- Institutionally owned and managed
- Available Q4 2022
- Call for pricing

# SHOWROOM WITH PALMETTO FRONTAGE

As-Built Site Plan

**57,750 s.f.**

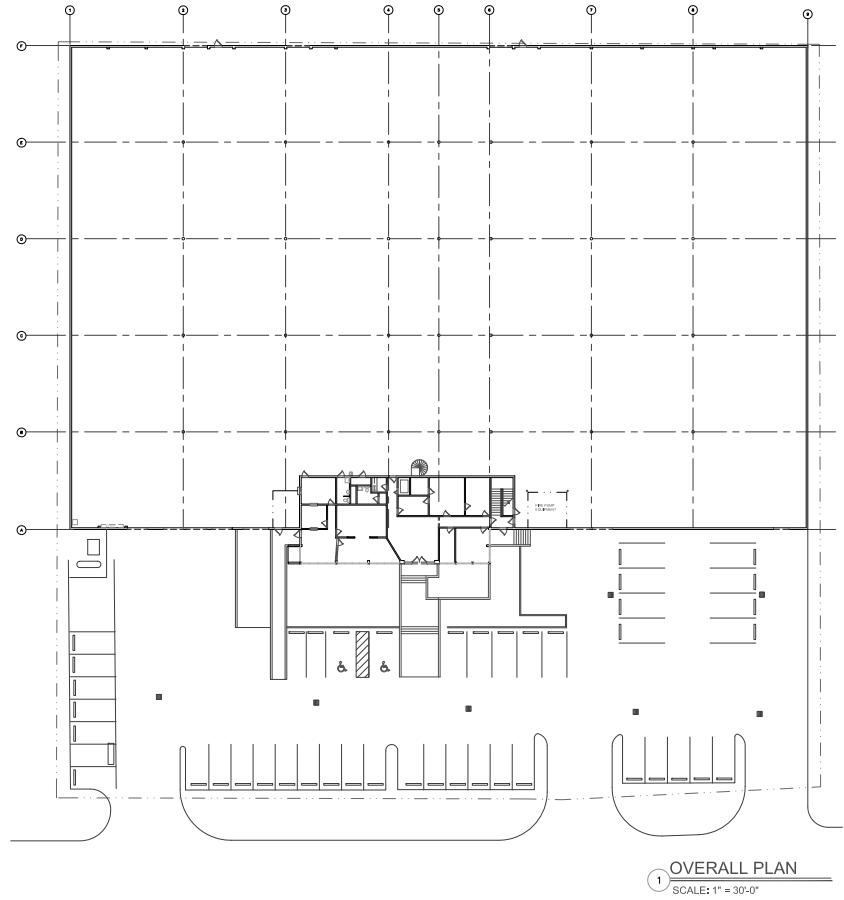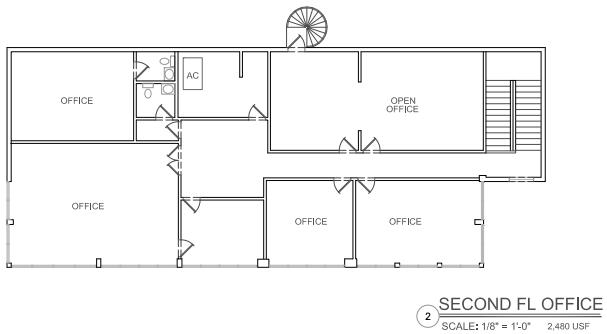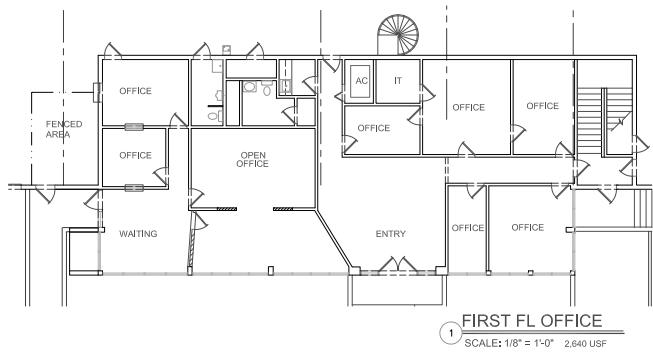

## SHOWROOM WITH PALMETTO FRONTAGE



### Leasing contact information

**Matt Maciag**

+1 305 960 8409

[matt.maciag@am.jll.com](mailto:matt.maciag@am.jll.com)

**Audley Bosch, SIOR**

+1 305 960 8404

[audley.bosch@am.jll.com](mailto:audley.bosch@am.jll.com)



Although information has been obtained from sources deemed reliable, neither Owner nor JLL makes any guarantees, warranties or representations, express or implied, as to the completeness or accuracy as to the information contained herein. Any projections, opinions, assumptions or estimates used are for example only. There may be differences between projected and actual results, and those differences may be material. The Property may be withdrawn without notice. Neither Owner nor JLL accepts any liability for any loss or damage suffered by any party resulting from reliance on this information. If the recipient of this information has signed a confidentiality agreement regarding this matter, this information is subject to the terms of that agreement.

© 2020 Jones Lang LaSalle IP, Inc. All rights reserved.