


Midtown Centre OFFICE PARK

3947 BOULEVARD CENTER DRIVE
1000 BUILDING SUITE 5
JACKSONVILLE, FLORIDA 32207
904-396-9092

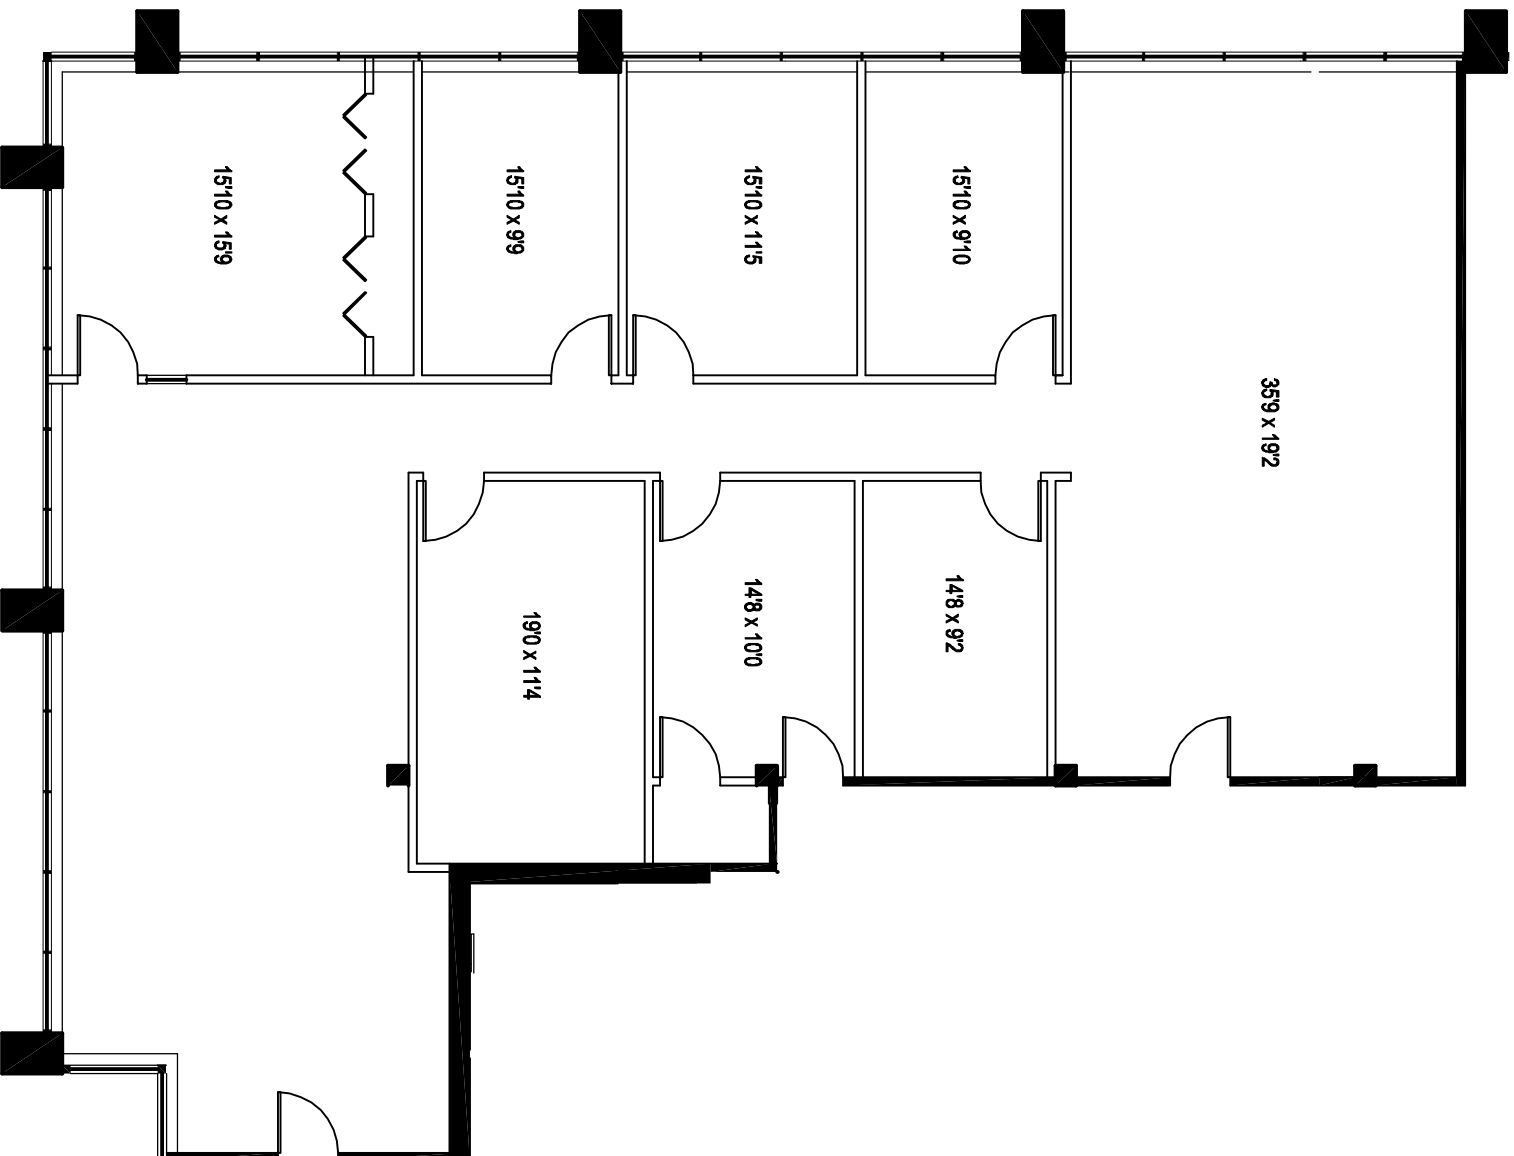

walburn studio
art . architecture . environments
3947 BOULEVARD CENTER DRIVE, SUITE 8
JACKSONVILLE, FLORIDA 32207

AS BUILT PLAN
SUITE 100, 4000 BUILDING
4811 BEACH BOULEVARD
JACKSONVILLE, FLORIDA

SCALE: N.T.S.
U.S.F.: 2,932
R.S.F.: 3,284
1/8/09

SHEET:
1
OF 1