


NOTES

1. BOTTOM OF BAR JOIST.
2. THIS DRAWING WAS CREATED USING DATA CAPTURED WITH LASER SCANNING TECHNOLOGY.
3. VECTORNET EMPLOYS A VARIETY OF SURVEYING AND LASER SCANNING EQUIPMENT TO CAPTURE AS-BUILT INFORMATION.
4. A 'BEST-FIT' APPROACH WAS USED TO REPRESENT AS-BUILT CONDITIONS.
5. CONTACT VECTORNET FOR MORE INFORMATION ON THE SPATIAL DATA AND LEVEL OF ACCURACY.
6. GROSS BUILDING AREA = 3,544.41 FT²



PROPERTY ADDRESS:
4200 E 7TH AVE.
TAMPA, FL 33605

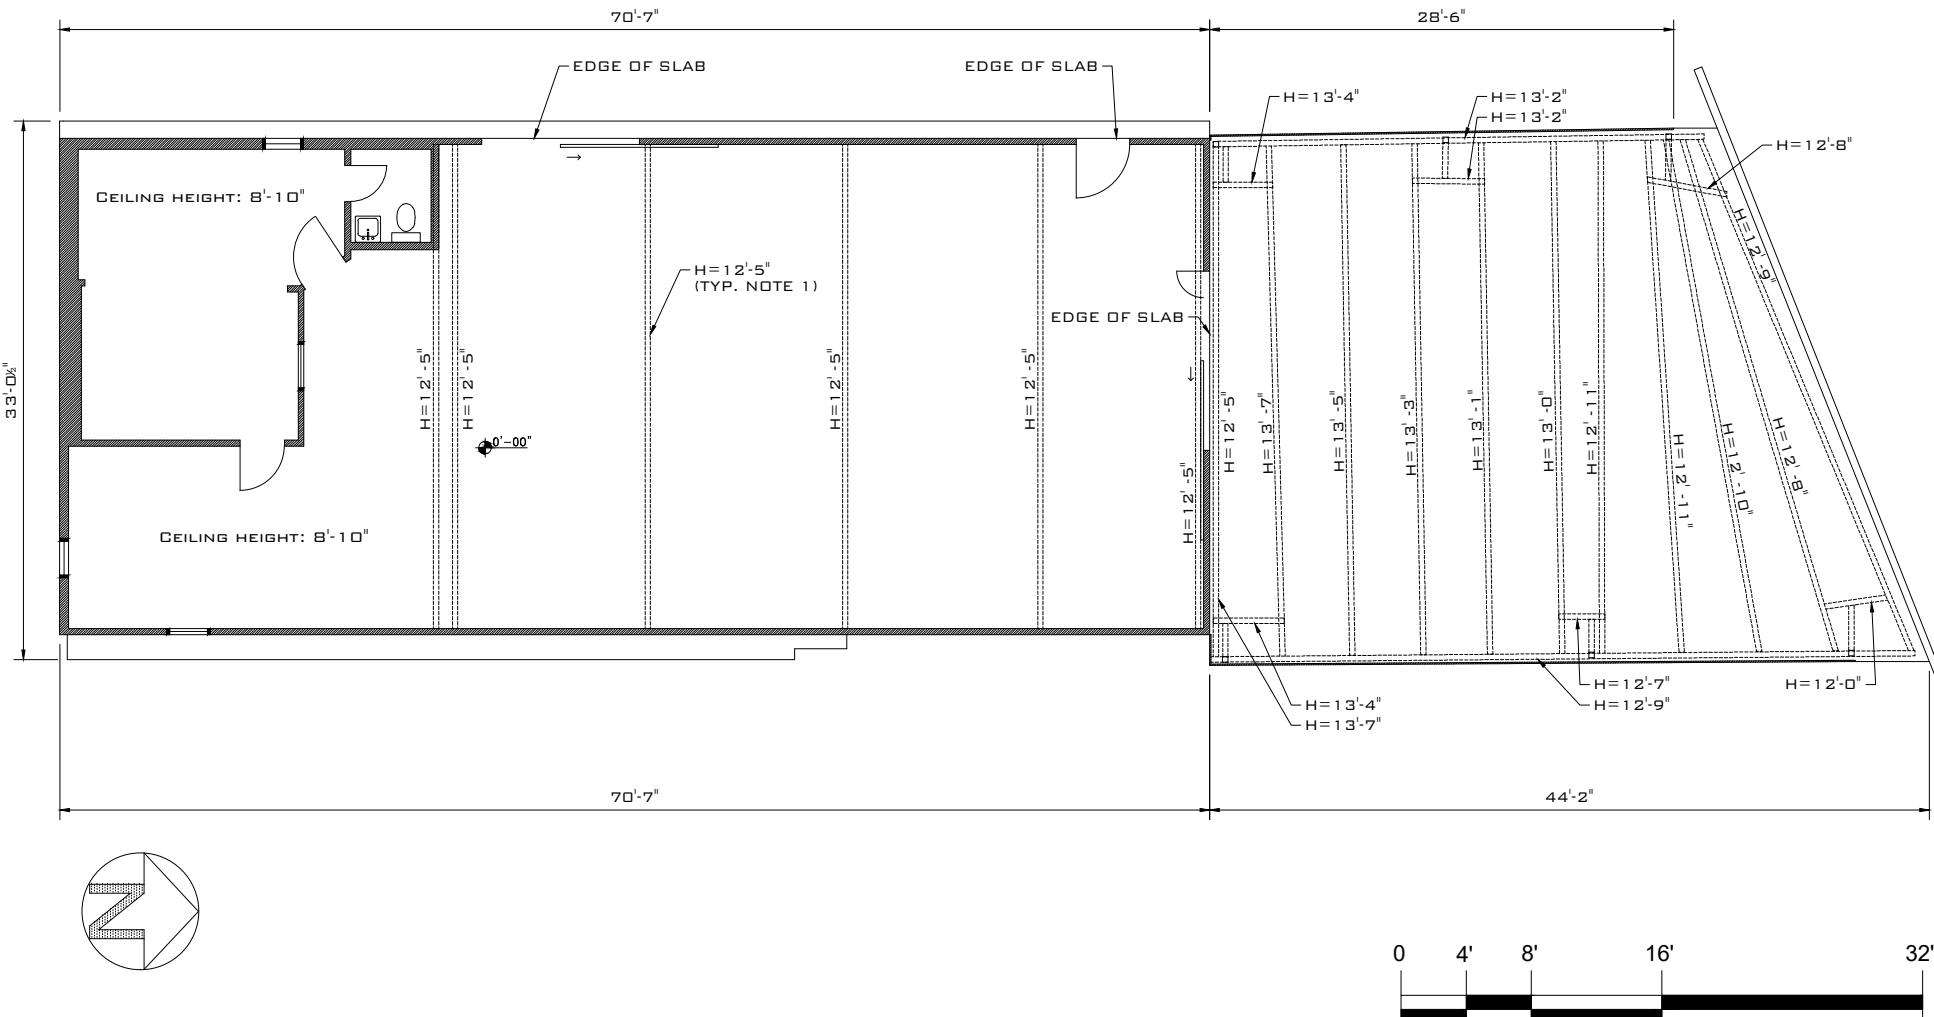

813-798-SCAN
VECTORNET3D.COM

SCALE: AS NOTED

DRAWN: ULA
CHECKED: NJS

DATE: 06/03/25
DATE: 06/03/25

TITLE

FLOOR PLAN
LEVEL 1