


13840 N NORTHSIGHT BLVD

AS BUILT

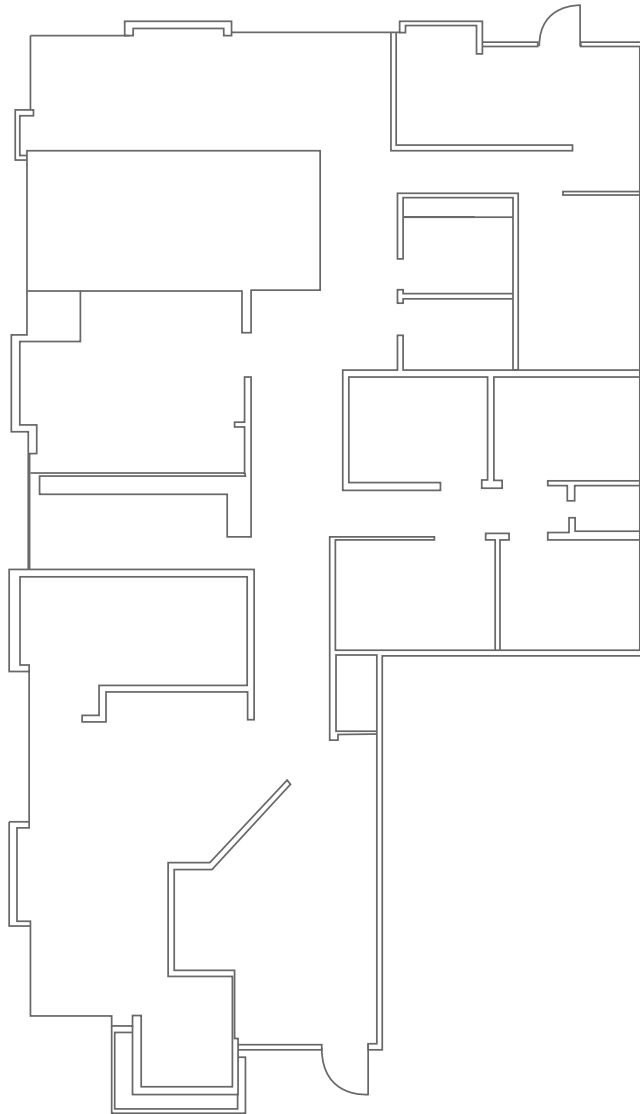

AVAILABLE FOR LEASE OR SALE

2,180 SF

AVAILABLE

Leasing by

CHAD SUTTON

602.513.5110

chad.sutton@kidder.com

RACHAEL THOMPSON

602.513.5122

rachael.thompson@kidder.com

KIDDER MATHEWS