

**BURGESS DESIGN**  
INTERIORS • ARCHITECTURE  
1200 5th Ave Suite 400 Seattle WA | 206.587.7120

2218 WESTERN AVE  
SEATTLE, WA 98121

Professional seal

No.	Issue Description	Date
	AS BUILT	5/18/2024

CLIENT APPROVAL	DATE


City Electronic Stamp Location

Drawn by: \_\_\_\_\_ Project Manager: \_\_\_\_\_  
Project No: 23.0336.01

AS BUILT PLAN


Original drawing is 24" x 36". Scale in this document is as reduced.

A101

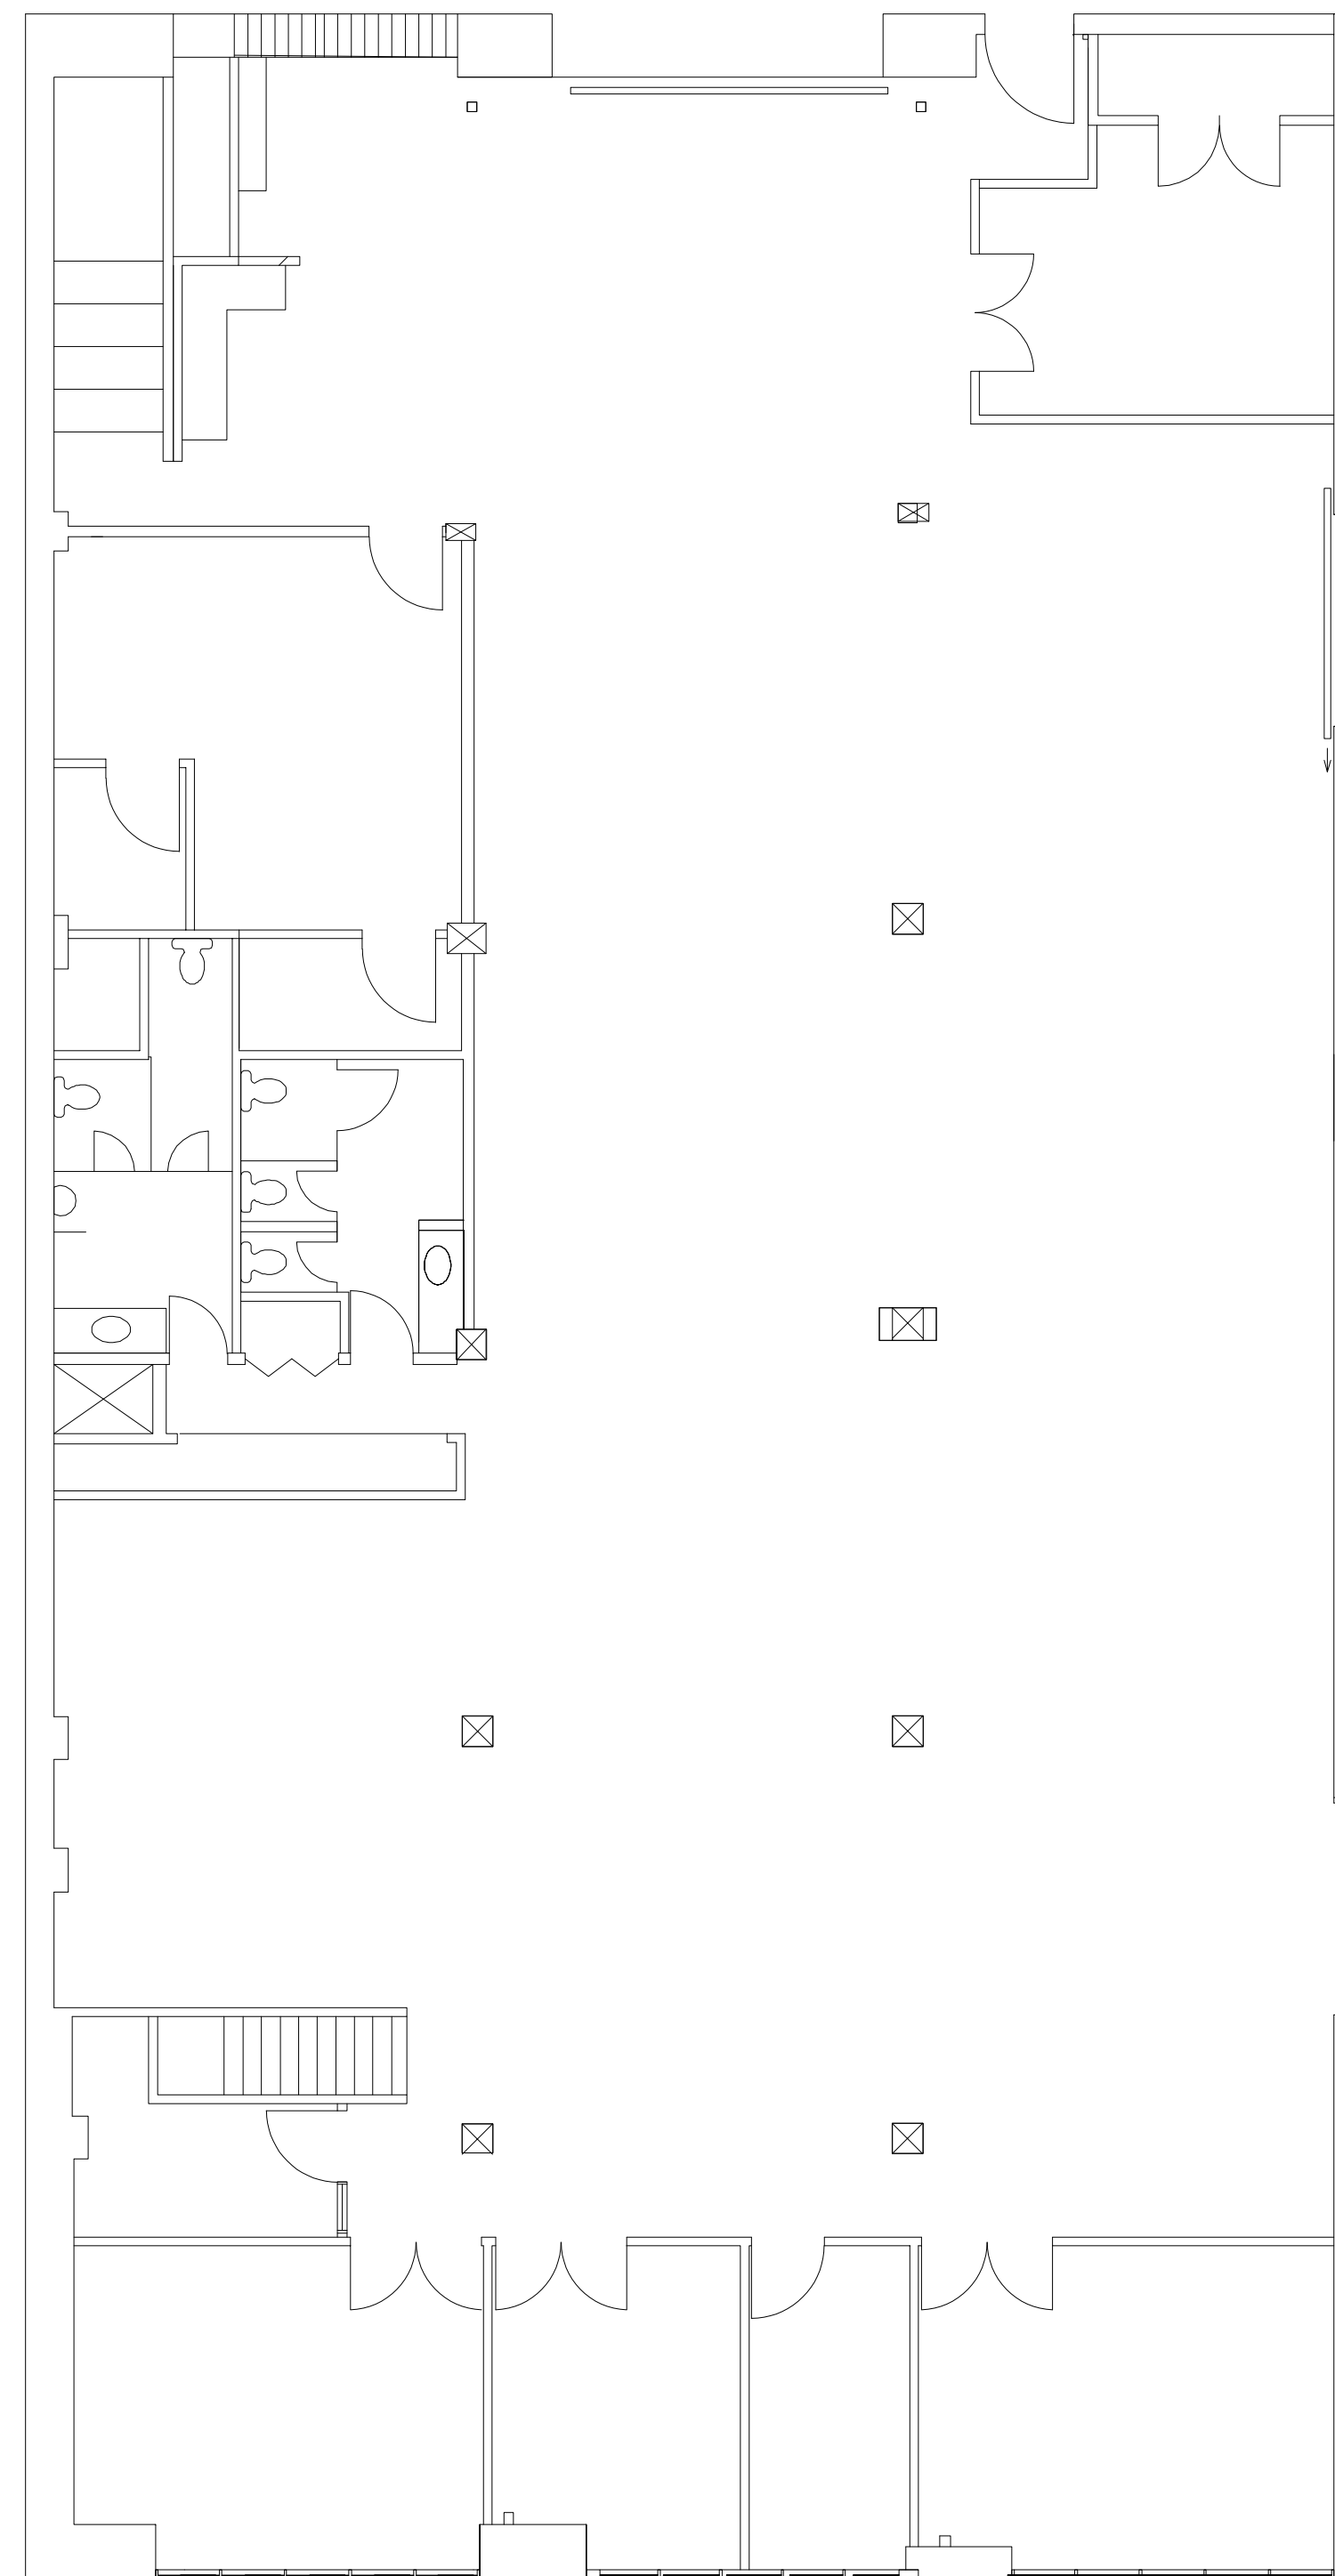

**A** AS BUILT PLAN

1/8" = 1'-0"

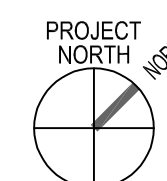

All reproduced & intellectual property rights reserved © 2024