


SCALE: 1/4"= 1'-0'

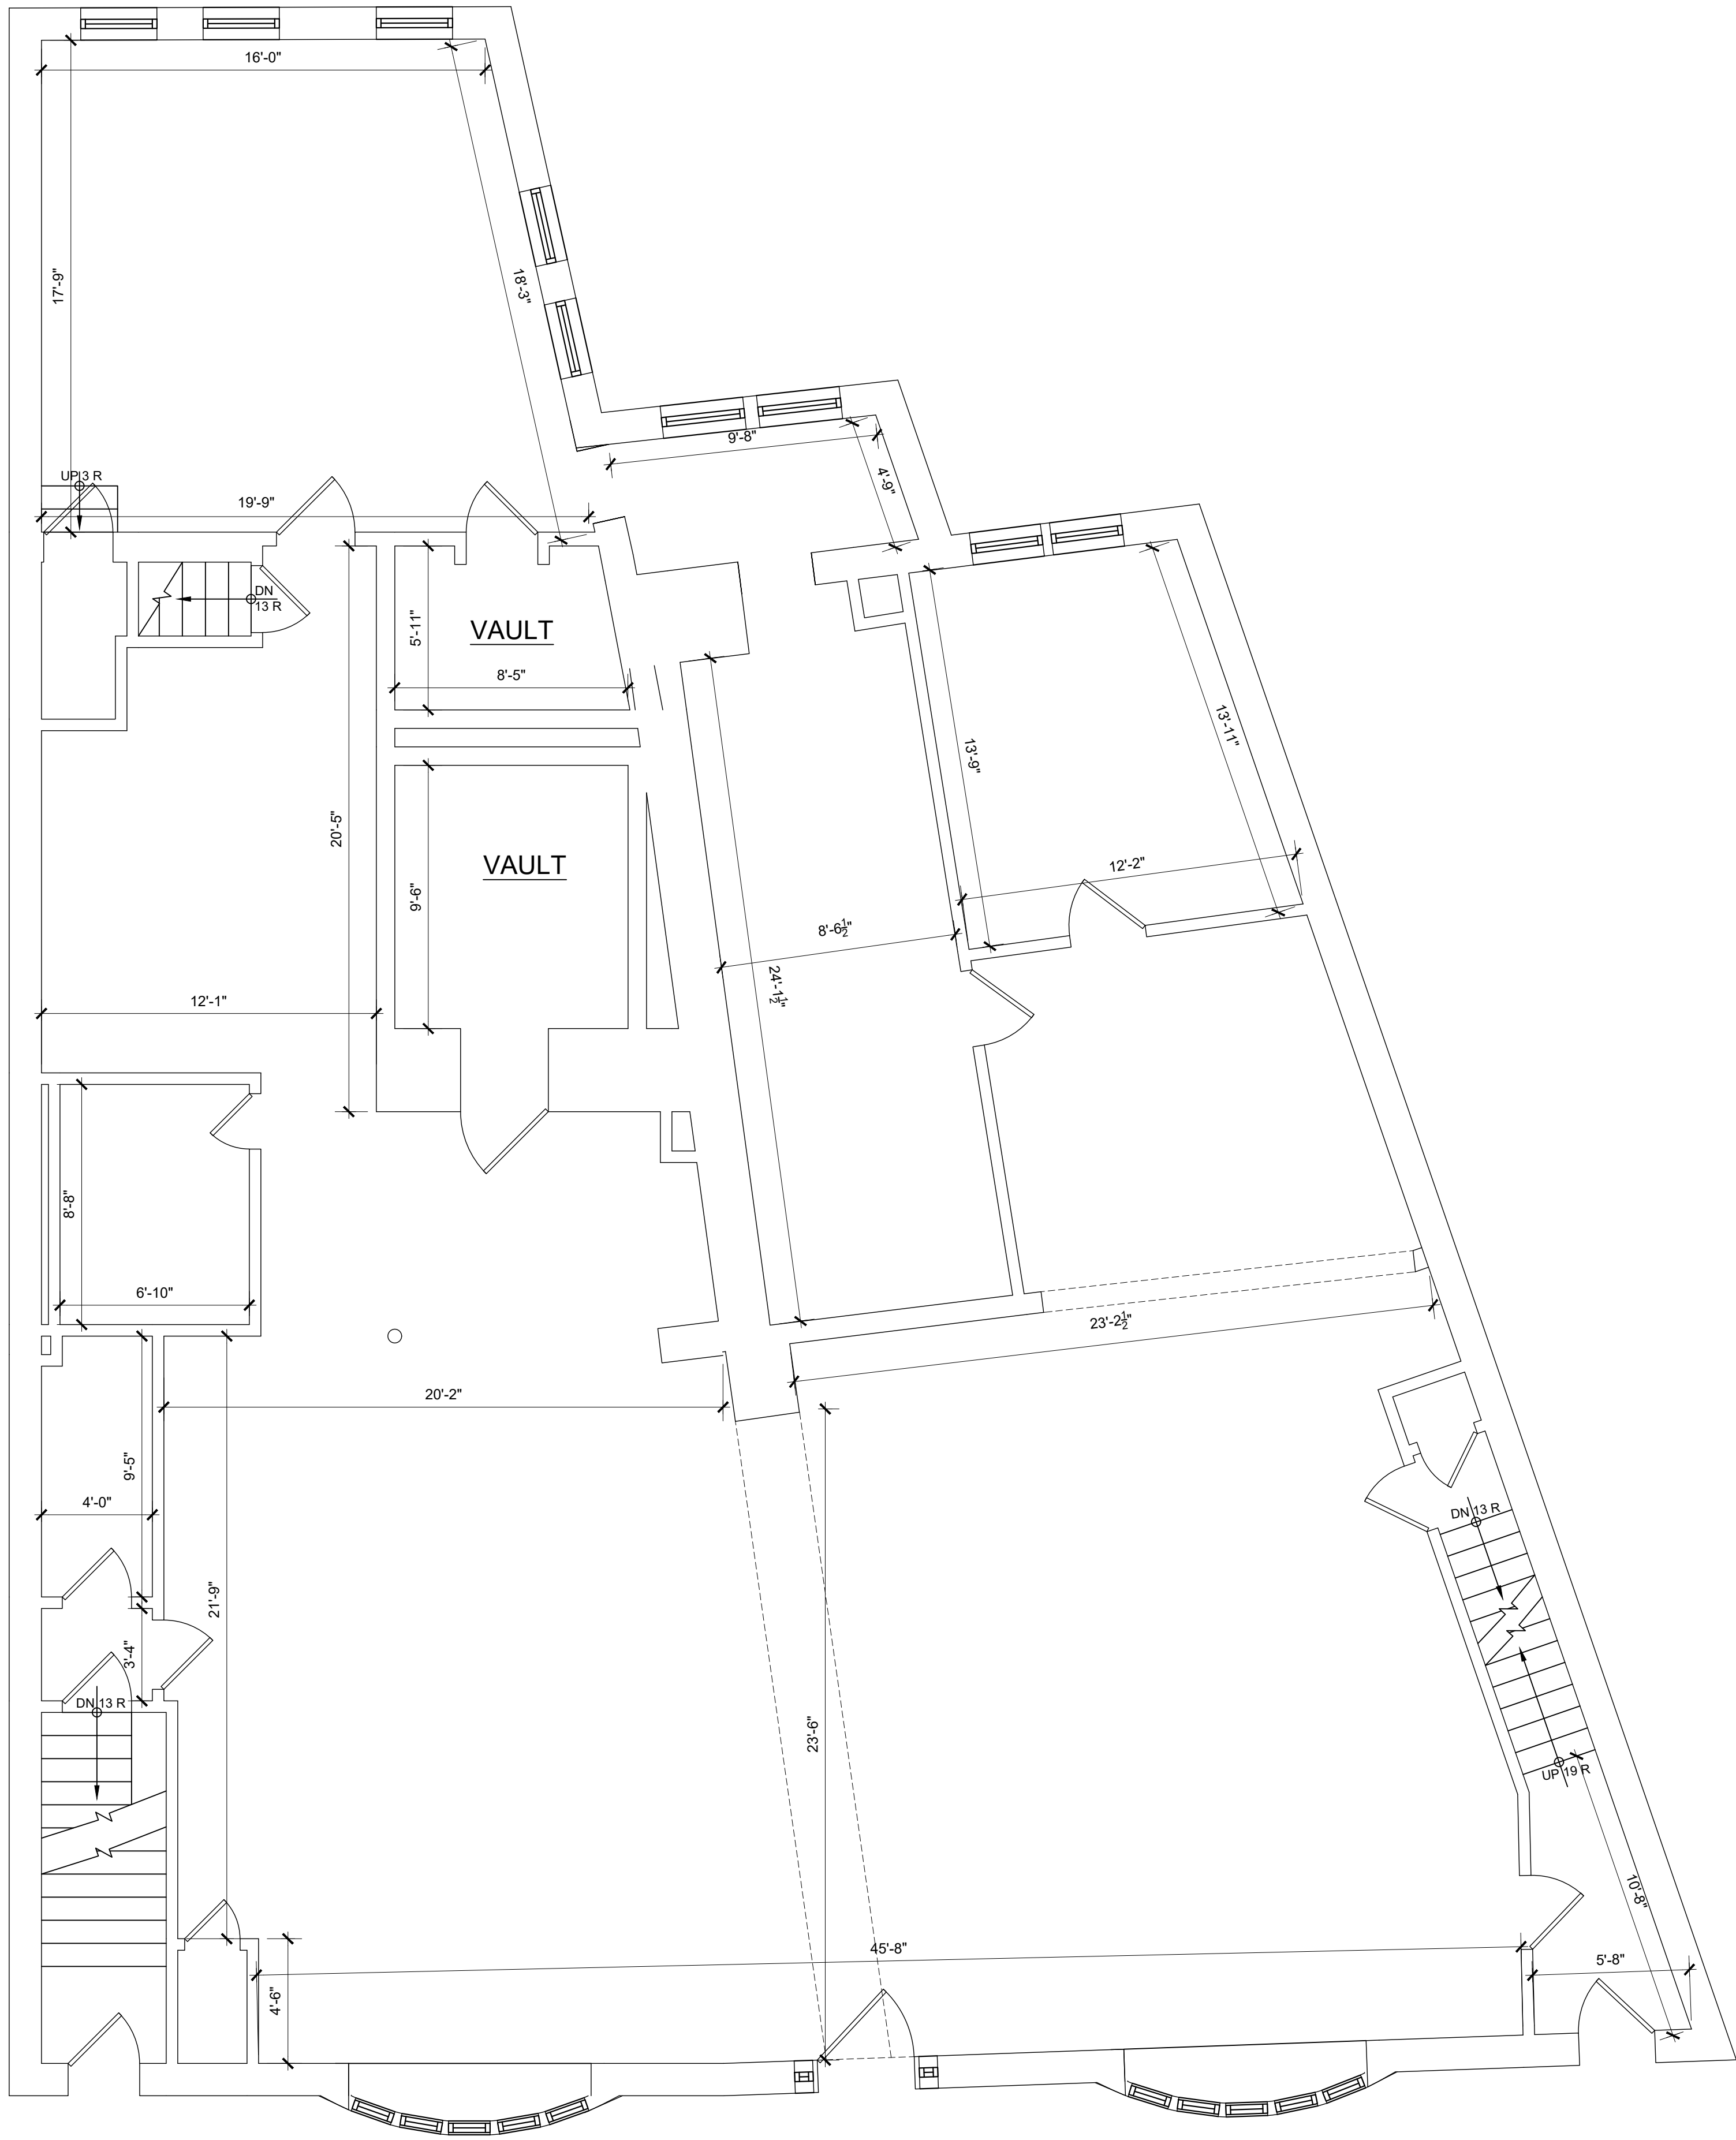

AS-BUILT FIRST FLOOR PLAN
SCALE: 1/4"= 1'-0"

Architect
ENSPIRE DESIGN GROUP, PLLC
4964 EXPRESS DRIVE SOUTH, SUITE 1
RONKONKOMA, NEW YORK, 11779
Phone: 631-471-9500 Fax: 631-471-9510
info@enspirepllc.com www.enspirepllc.com
MICHAEL F. MORBILLO, AIA – Principal
New York State License #25202

Mechanical, Electrical, Plumbing Consultant


OWNER/APPLICANT:
A2 228E MAIN LLC

These drawings and all documents prepared by the Architect are instruments of the Architect's service, and are to remain the property of the Architect. The designs contained herein are intended for the specific location indicated and are not to be used at any other locations without the express written consent of the Architect. It is a violation of the law for any person, unless acting under the authority of the Architect, to alter these documents in any way.

These documents are copyrighted and their use shall be limited to the construction of this project, once only. The Architectural Works Copyright Protection Act, adopted by Congress in 1990 and incorporated into the United States Copyright Act of 1976 (Title 17, U.S. Code, sections 101 and 102) provides potentially very severe penalties for infringement, including criminal penalties. These documents may not be used for any other purpose.

General Notes


No.	Date	Revision Description
-----	------	----------------------

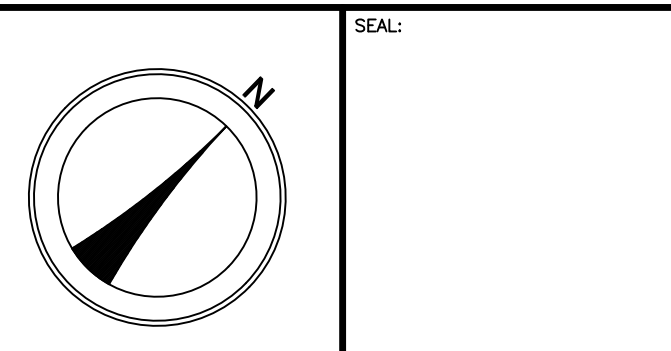

PROJECT TITLE:
**INTERIOR ALTERATIONS
FOR
"THE VAULT AT
PORT JEFFERSON"**
228 E MAIN STREET,
PORT JEFFERSON, N.Y. 11777
SCTM# 0206-12-3-12

TITLE SHEET:
FIRST FLOOR AS-BUILT PLAN

PROJECT NO. 24-112	SHEET NO.
DATE: 5/21/2025	A-2
DESIGN BY: MICHAEL F. MORBILLO, AIA	
DRAWN BY: T/J JAS	
CHECKED BY: MF	
SCALE: AS PER PLAN	

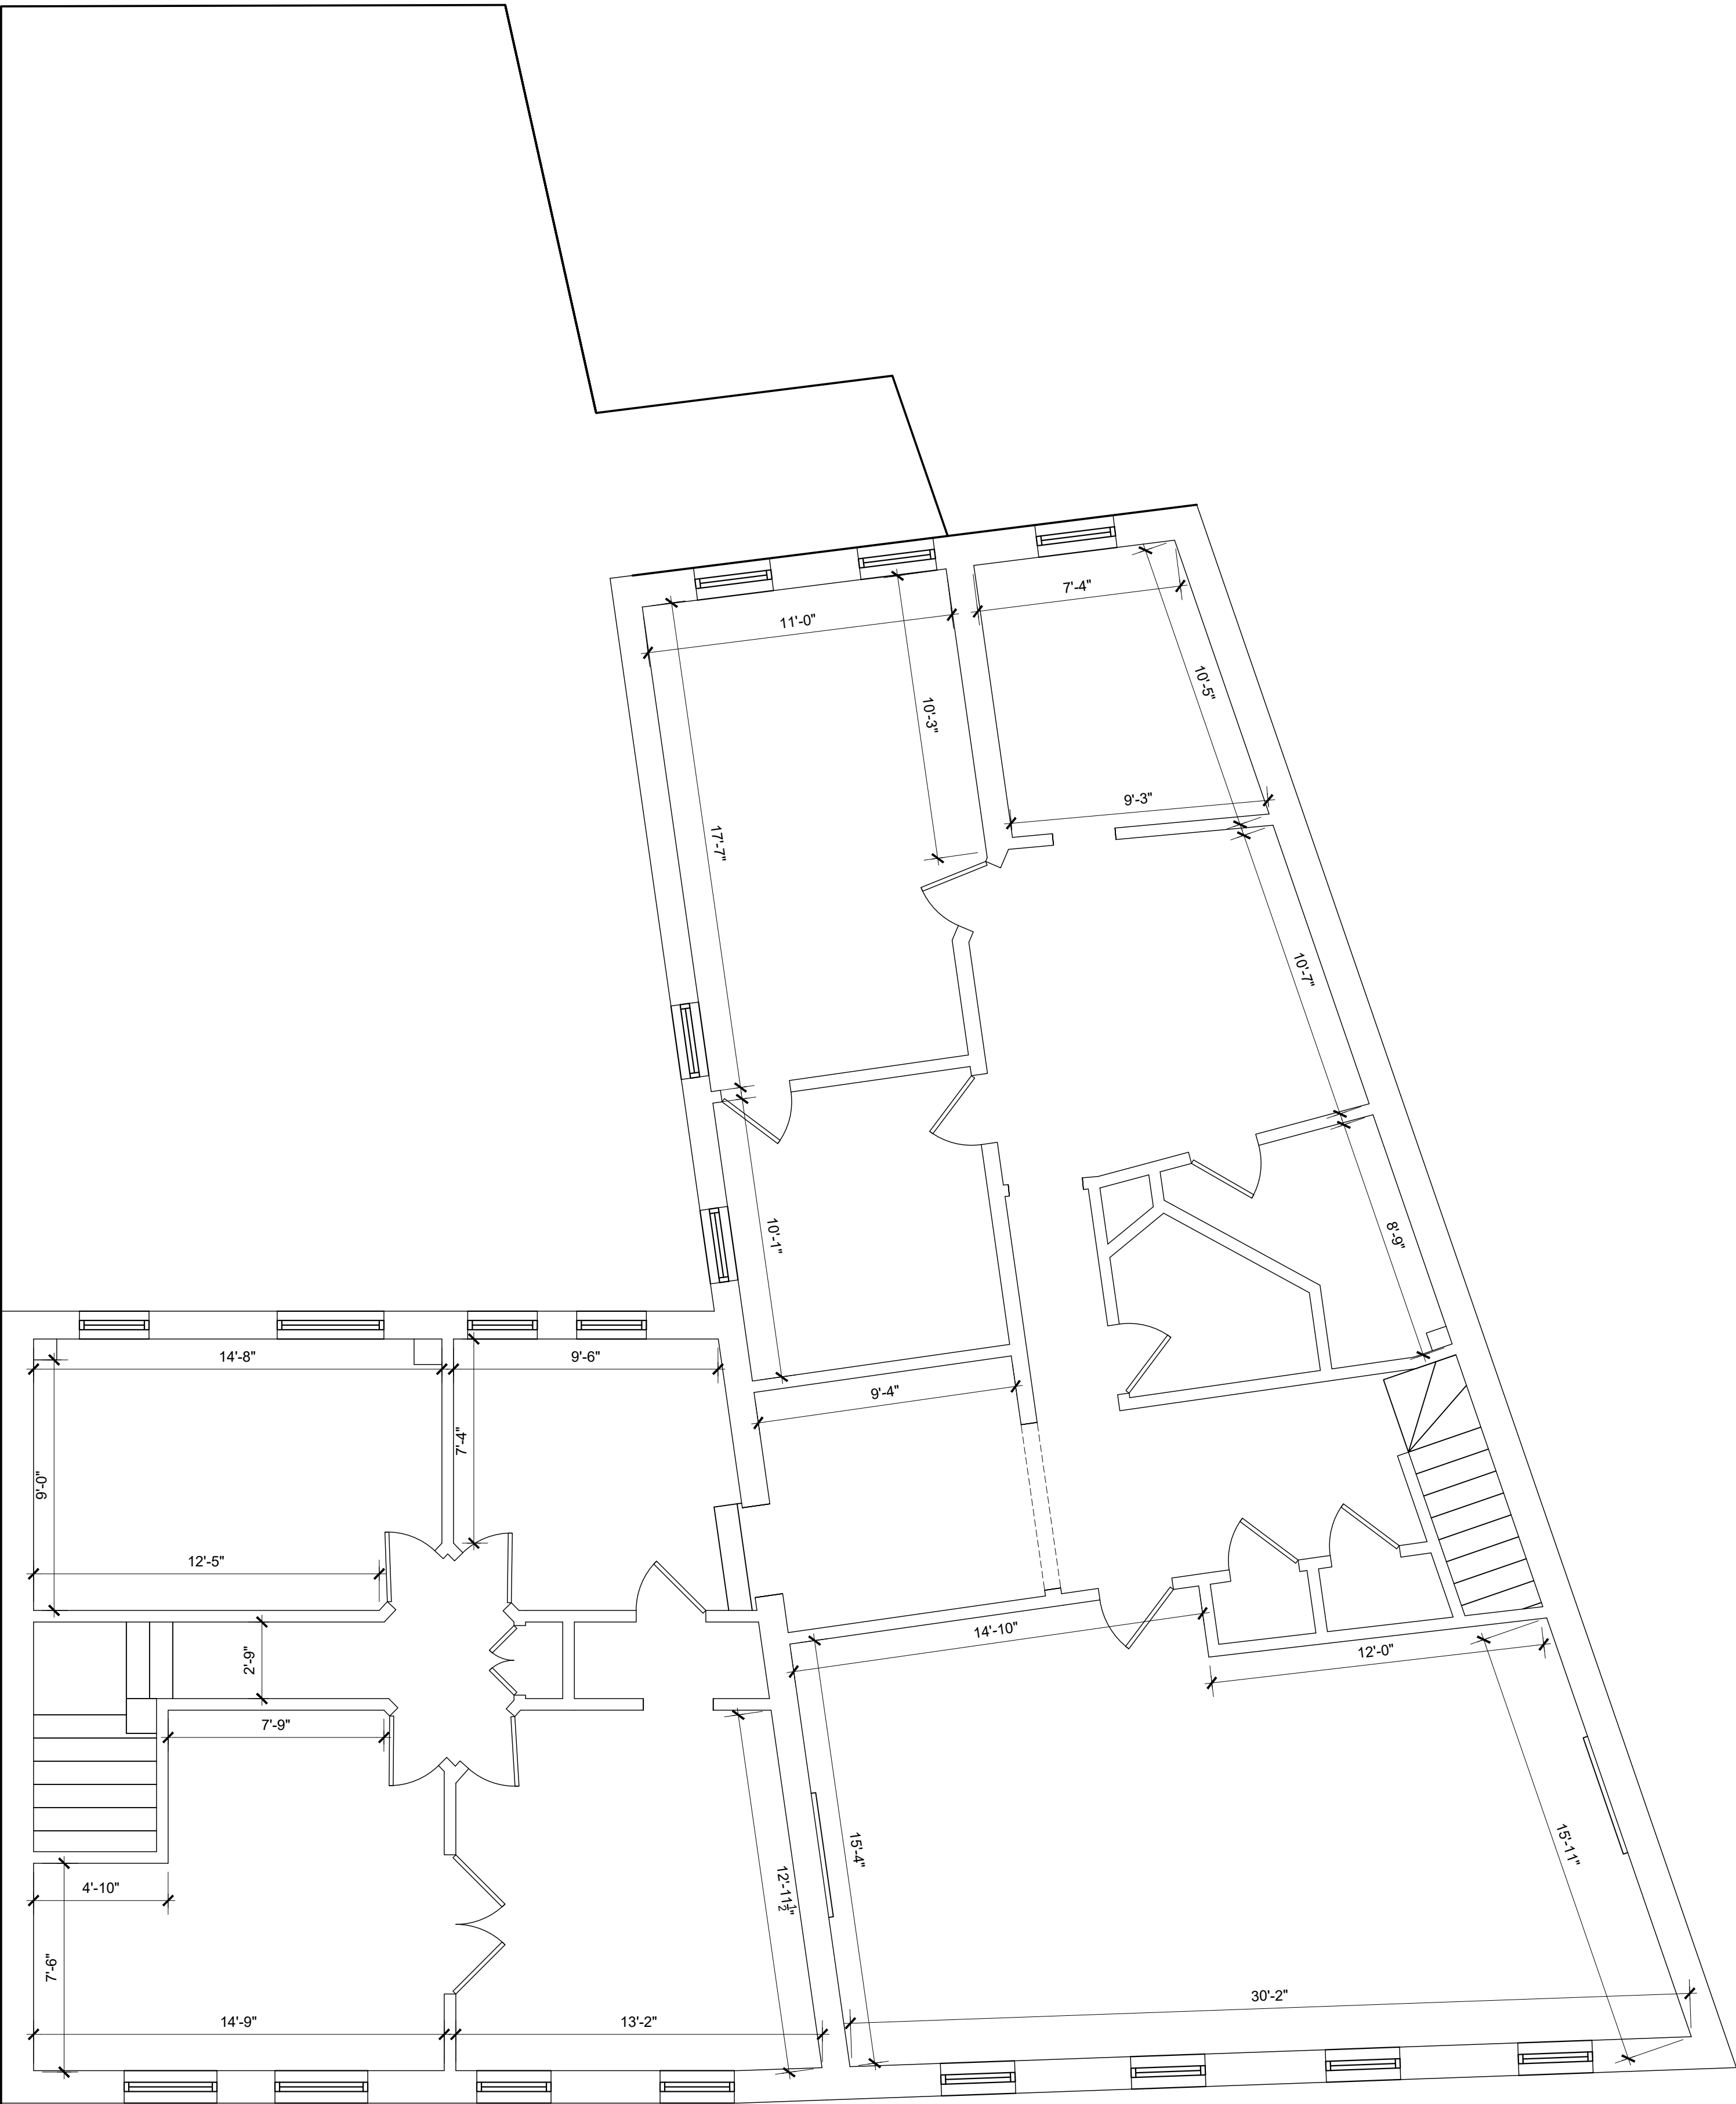

AS-BUILT SECOND FLOOR PLAN
SCALE: 1/4"= 1'-0"

Architect
ENSPIRE DESIGN GROUP, PLLC
4964 EXPRESS DRIVE SOUTH, SUITE 1
RONKONKOMA, NEW YORK, 11779
Phone: 631-471-9500 Fax: 631-471-9510
info@enspirellc.com www.enspirellc.com
MICHAEL F. MORBILLO, AIA – Principal
New York State License #25202

Mechanical, Electrical, Plumbing Consultant


OWNER/APPLICANT:
A2 228E MAIN LLC

These drawings and all documents prepared by the Architect are instruments of the Architect's service, and are to remain the property of the Architect. The designs contained herein are intended for the specific location indicated and are not to be used at any other location without the express written consent of the Architect. It is a violation of the law for any person, unless acting under the authority of the Architect, to alter these documents in any way.

These documents are copyrighted and their use shall be limited to the construction of this project, once only. The Architectural Works Copyright Protection Act, adopted by Congress in 1990 and incorporated into the United States Copyright Act of 1976 (Title 17, U.S. Code, sections 101 and 102) provides potentially very severe penalties for infringement, including criminal penalties. These documents may not be used for any other purpose.

General Notes

No.	Date	Revision Description
-----	------	----------------------

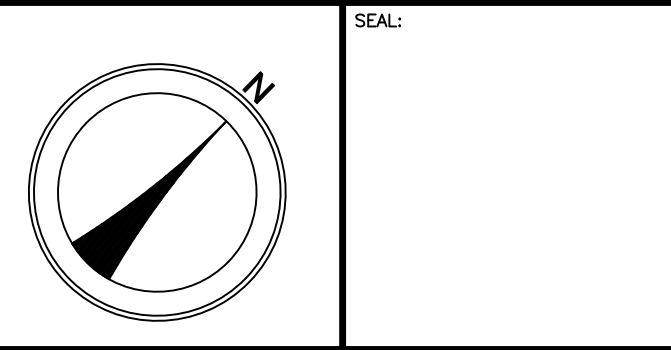

PROJECT TITLE:
**INTERIOR ALTERATIONS
FOR
"THE VAULT AT
PORT JEFFERSON"
228 E MAIN STREET,
PORT JEFFERSON, N.Y. 11777
SCTM# 0206-12-3-12**

TITLE SHEET:
**PROPOSED SECOND
AS-BUILT PLAN**

PROJECT NO. 24-112	SHEET NO.
DATE: 5/21/2025	A-3
DESIGN BY: MICHAEL F. MORBILLO, AIA	
DRAWN BY: T/J JAS	
CHECKED BY: MF	
SCALE: AS PER PLAN	