

WORK SAFELY

15

14

13

12

11

10

9

8

7

6



5

4


3

2


WORK SAFELY

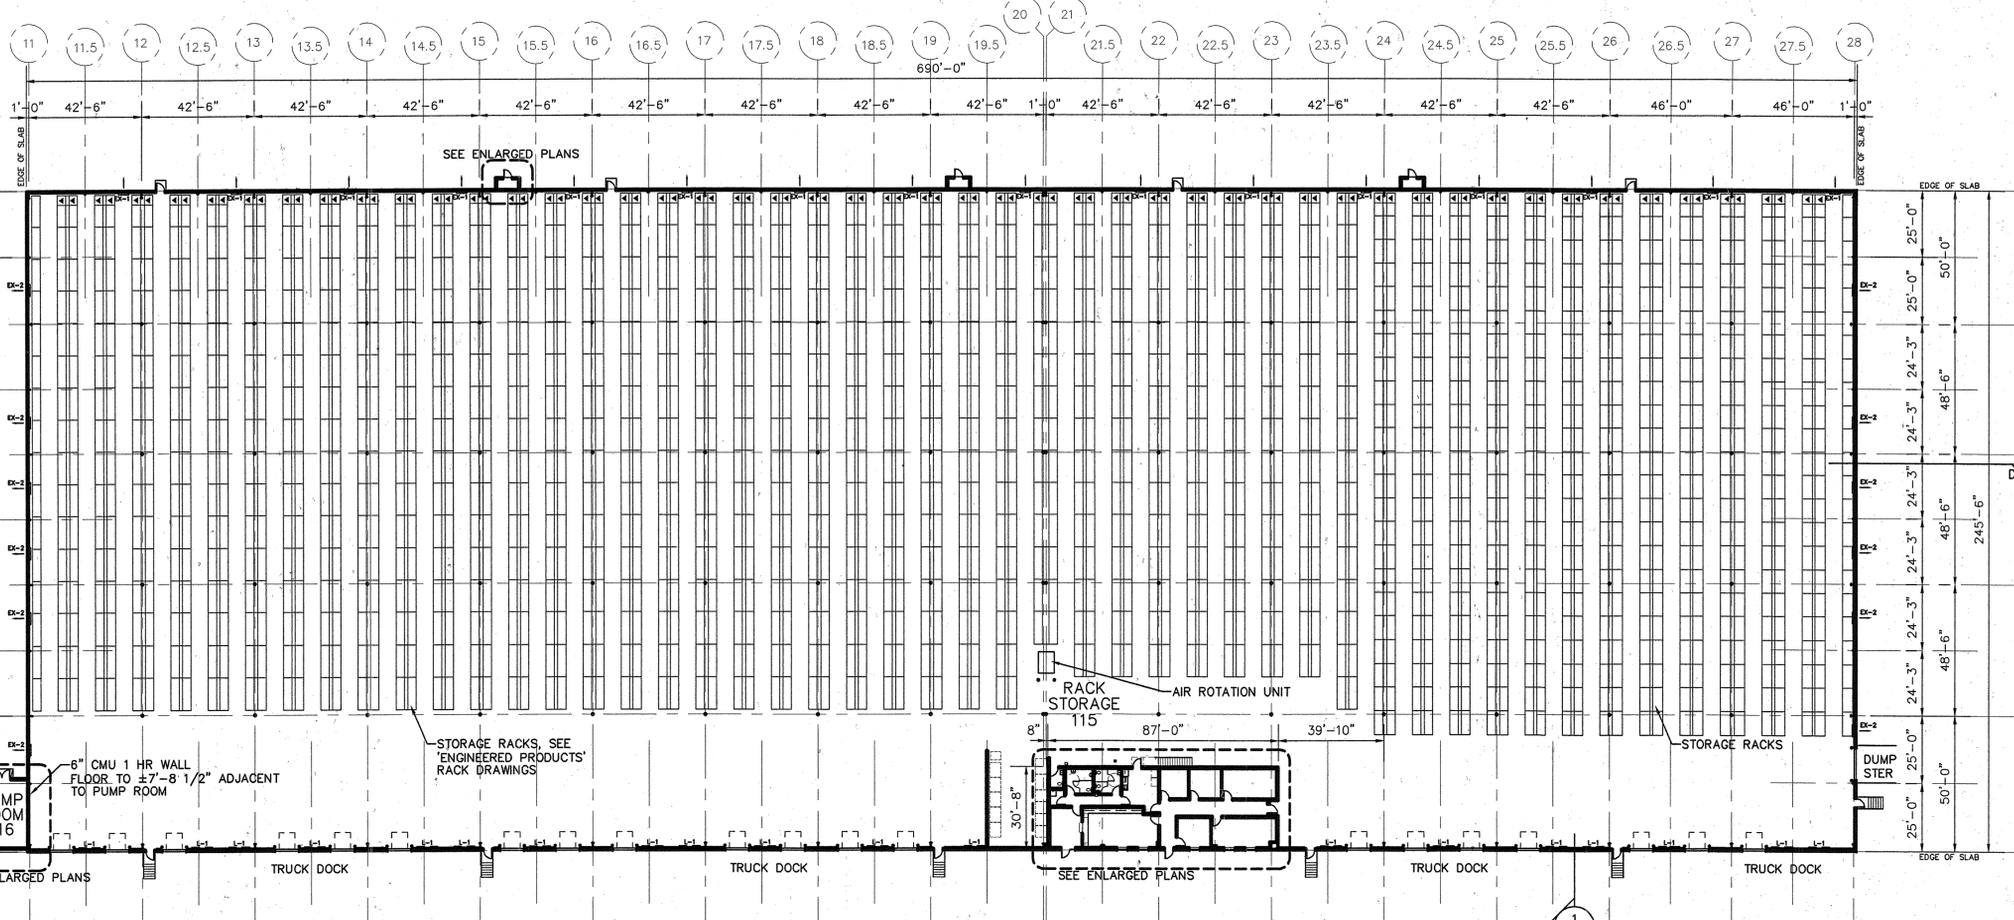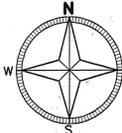


FLOOR PLAN  
SCALE 1/32" = 1'-0"

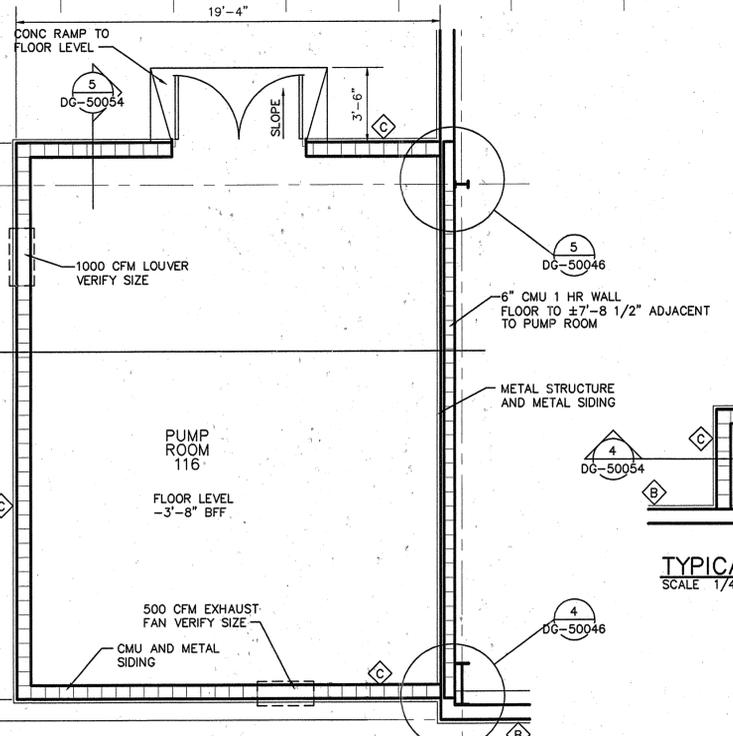


PUMP ROOM FLOOR PLAN  
SCALE 1/4" = 1'-0"

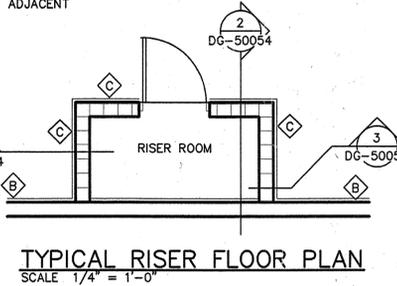


TYPICAL RISER FLOOR PLAN  
SCALE 1/4" = 1'-0"

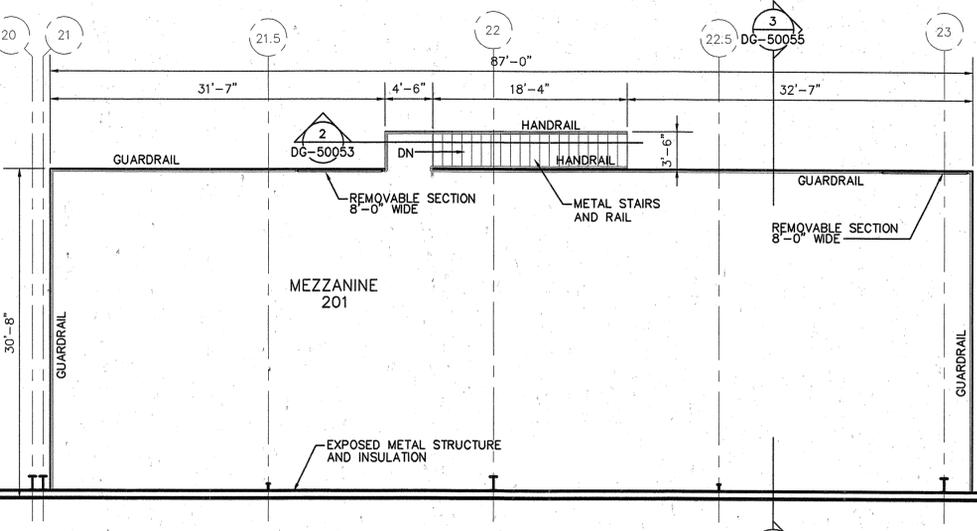

MEZZANINE PLAN  
SCALE 1/8" = 1'-0"

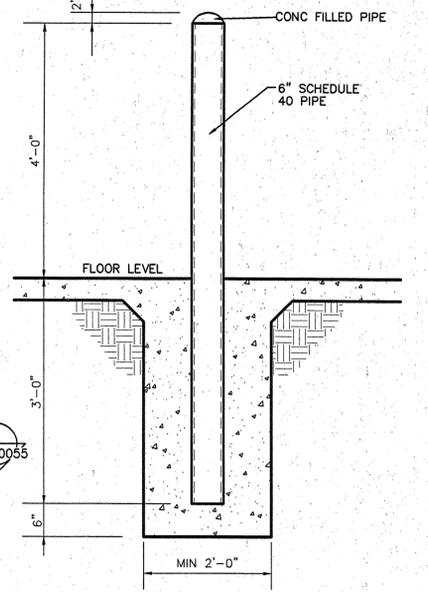

1 PIPE GUARD DETAIL  
DG-50043 SCALE 3/4" = 1'-0"

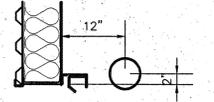

2 PIPE GUARD PLAN  
DG-50043 SCALE 3/4" = 1'-0"

SEALS	
EE10007	M. JOHNS T. KEITH 12-11-00 12-11-00
2	AS BUILTS
EE10007	M. JOHNS T. KEITH 8-18-00 8-18-00
1	SMOKEVENTS/FIREMARSHALL COMMENTS
EE10007	M. JOHNS T. KEITH 6-30-00 6-30-00
0	ISSUED FOR CONSTRUCTION
PROJECT NO.	BY CHECKED APPROVED APPROVED DATE DATE DATE DATE
REV.	DESCRIPTION

**SOLUTIA**  
Applied Chemistry, Creative Solutions

SOLUTIA GREENWOOD PLANT  
P.O. BOX 1057 - HWY 246  
GREENWOOD, SC 29648

COMPANY CONFIDENTIAL THIS DRAWING IS THE CONFIDENTIAL PROPERTY OF SOLUTIA INC. AND IS TO BE USED ONLY BY AUTHORIZED PERSONNEL AND IN THE INTEREST OF SOLUTIA, IT MUST BE ACCOUNTED FOR. SHALL NOT BE REPRODUCED IN WHOLE OR PART WITHOUT PRIOR WRITTEN PERMISSION FROM SOLUTIA AND MUST BE RETURNED TO SOLUTIA ENTERPRISE AT COMPLETION OF THE WORK. THE REQUESTOR AGREES TO KEEP CONFIDENTIAL AND TO REQUIRE ITS EMPLOYEES TO KEEP CONFIDENTIAL THE INFORMATION CONTAINED HEREON. DISCLOSURE OF THE INFORMATION CONTAINED HEREON SHALL BE MADE ONLY TO THOSE PERSONS WHO REQUIRE SUCH INFORMATION FOR THEIR WORK ON SOLUTIA'S PROJECTS.

261 AREA WAREHOUSE LAYOUT  
FULL WAREHOUSE PLAN WITH MEZZANINE, PUMP ROOM, AND RISER ROOM

BY	DATE	APPROVED	DATE	GROUP/BUSINESS UNIT
DRAWN				
CHECKED				
DESIGNED				
PROJECT NO.	PROCESS/AREA	DEPT./SUB-GROUP	TYPE	NUMBER
EE10007	261		A	K.A.I. INR SHEET A-1 JOB 00030
SIZE	SITE DRAWING NO.			REV.
D	DG-50043			

**Keith ARCHITECTS inc**  
GREENVILLE, SOUTH CAROLINA (864) 235-2306

PROFESSIONAL ENGINEERING ASSOCIATES, INCORPORATED  
P.O. BOX 8334 GREENVILLE, S.C. 29604  
**pe**

**SUIT CONSTRUCTION COMPANY**  
GREENVILLE, SOUTH CAROLINA

F:\ACAD\00030\00030A01.dwg Tue Dec 26 10:02:59 2000

261 Area 33