


NOTES:
SUITE A HAS 3,312 SQFT

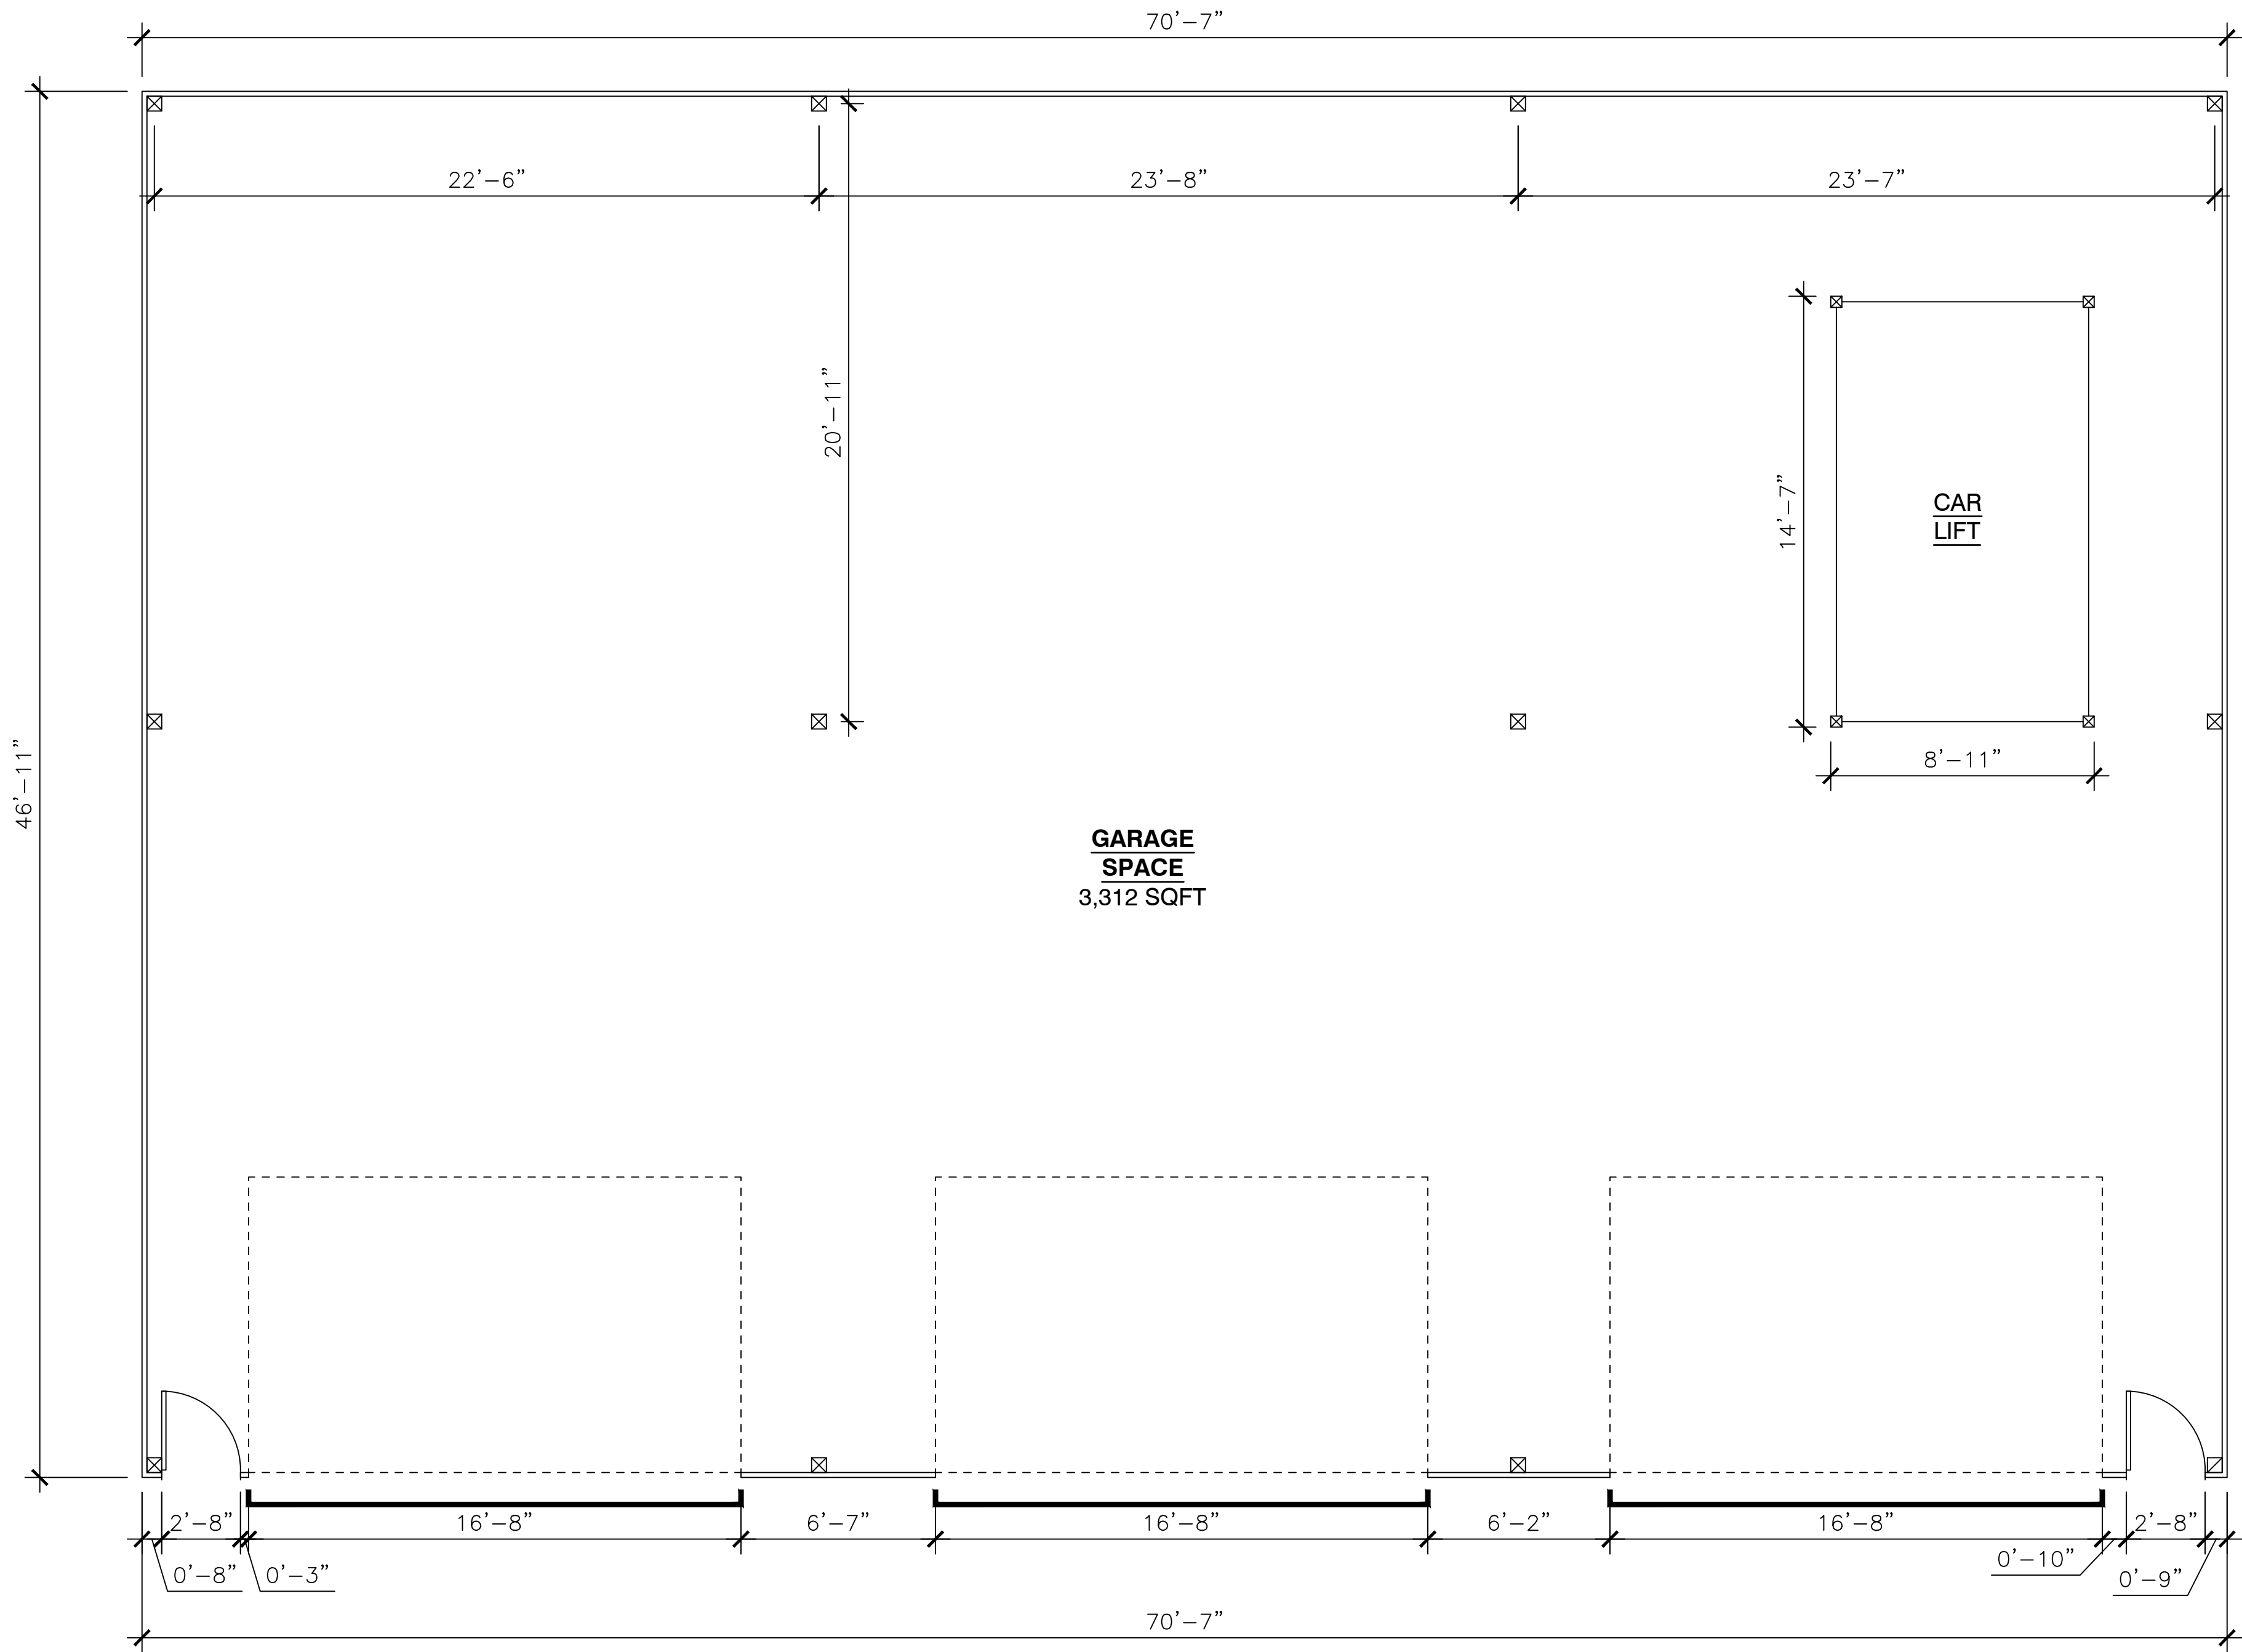

AMC
DESIGN

10413 ROCKLEY RD.
Houston, TX 77099
PHONE: 832-274-4464
FAX: 281-598-5797
anthony_vu@comcast.net

ALL IDEAS, DESIGNS, ARRANGEMENTS AND PLANS INDICATED OR REPRESENTED BY THIS DRAWING ARE OWNED BY AND ARE THE PROPERTY OF THE DESIGNER AND ARE NOT TO BE REPRODUCED, COPIED, REPRODUCED, EVOLVED AND DEVELOPED FOR USE ON AND IN CONNECTION WITH THE SPECIFIC PROJECT. NONE OF SUCH IDEAS, DESIGNS, ARRANGEMENTS, OR PLANS SHALL BE USED BY OR DISCLOSED TO ANY PERSON, FIRM, OR CORPORATION FOR ANY PURPOSE, WITHOUT THE WRITTEN PERMISSION OF THE DESIGNER. THE WRITTEN PERMISSIONS ON THESE DRAWINGS SHALL HAVE PRECEDENCE OVER SPOKE DIMENSIONS. CONTRACTORS SHALL VERIFY AND BE RESPONSIBLE FOR ALL DIMENSIONS AND CONDITIONS ON THE JOB. THE OFFICE MUST BE NOTIFIED OF ANY VIOLATIONS FROM THE DIMENSIONS OR CONDITIONS SHOWN ON THESE DRAWINGS.

5610 SOUTHWEST FREEWAY SUITE A
5610 SOUTHWEST FREEWAY, SUITE A
HOUSTON, TEXAS 77057

DRAWING ISSUED FOR:

REVISIONS

DATE:	DESCRIPTION:

DATE: 10/19/2020
DRAWN BY: C.R.
CHECKED BY: A.V.
PROJECT: A.V.
FILE NO:

SHEET TITLE:
AS-BUILT
FLOOR PLAN

SHEET NO:

AB-1