



DOCUMENTATION & DETAILING

Plan A Services Inc.
70 Gilbert St
Monroe NY 10950

718.219.4749

info@planaservices.com
planaservices.com

Project

222 NY-59, Ramapo
NY 10901

Drawing



**As-built
Floor Plan**

A - 001.00


Area 3357.7 SF

Scale 1/4" = 1'-0"

Date 08/27/2023

Drawn By O. P.

Notes

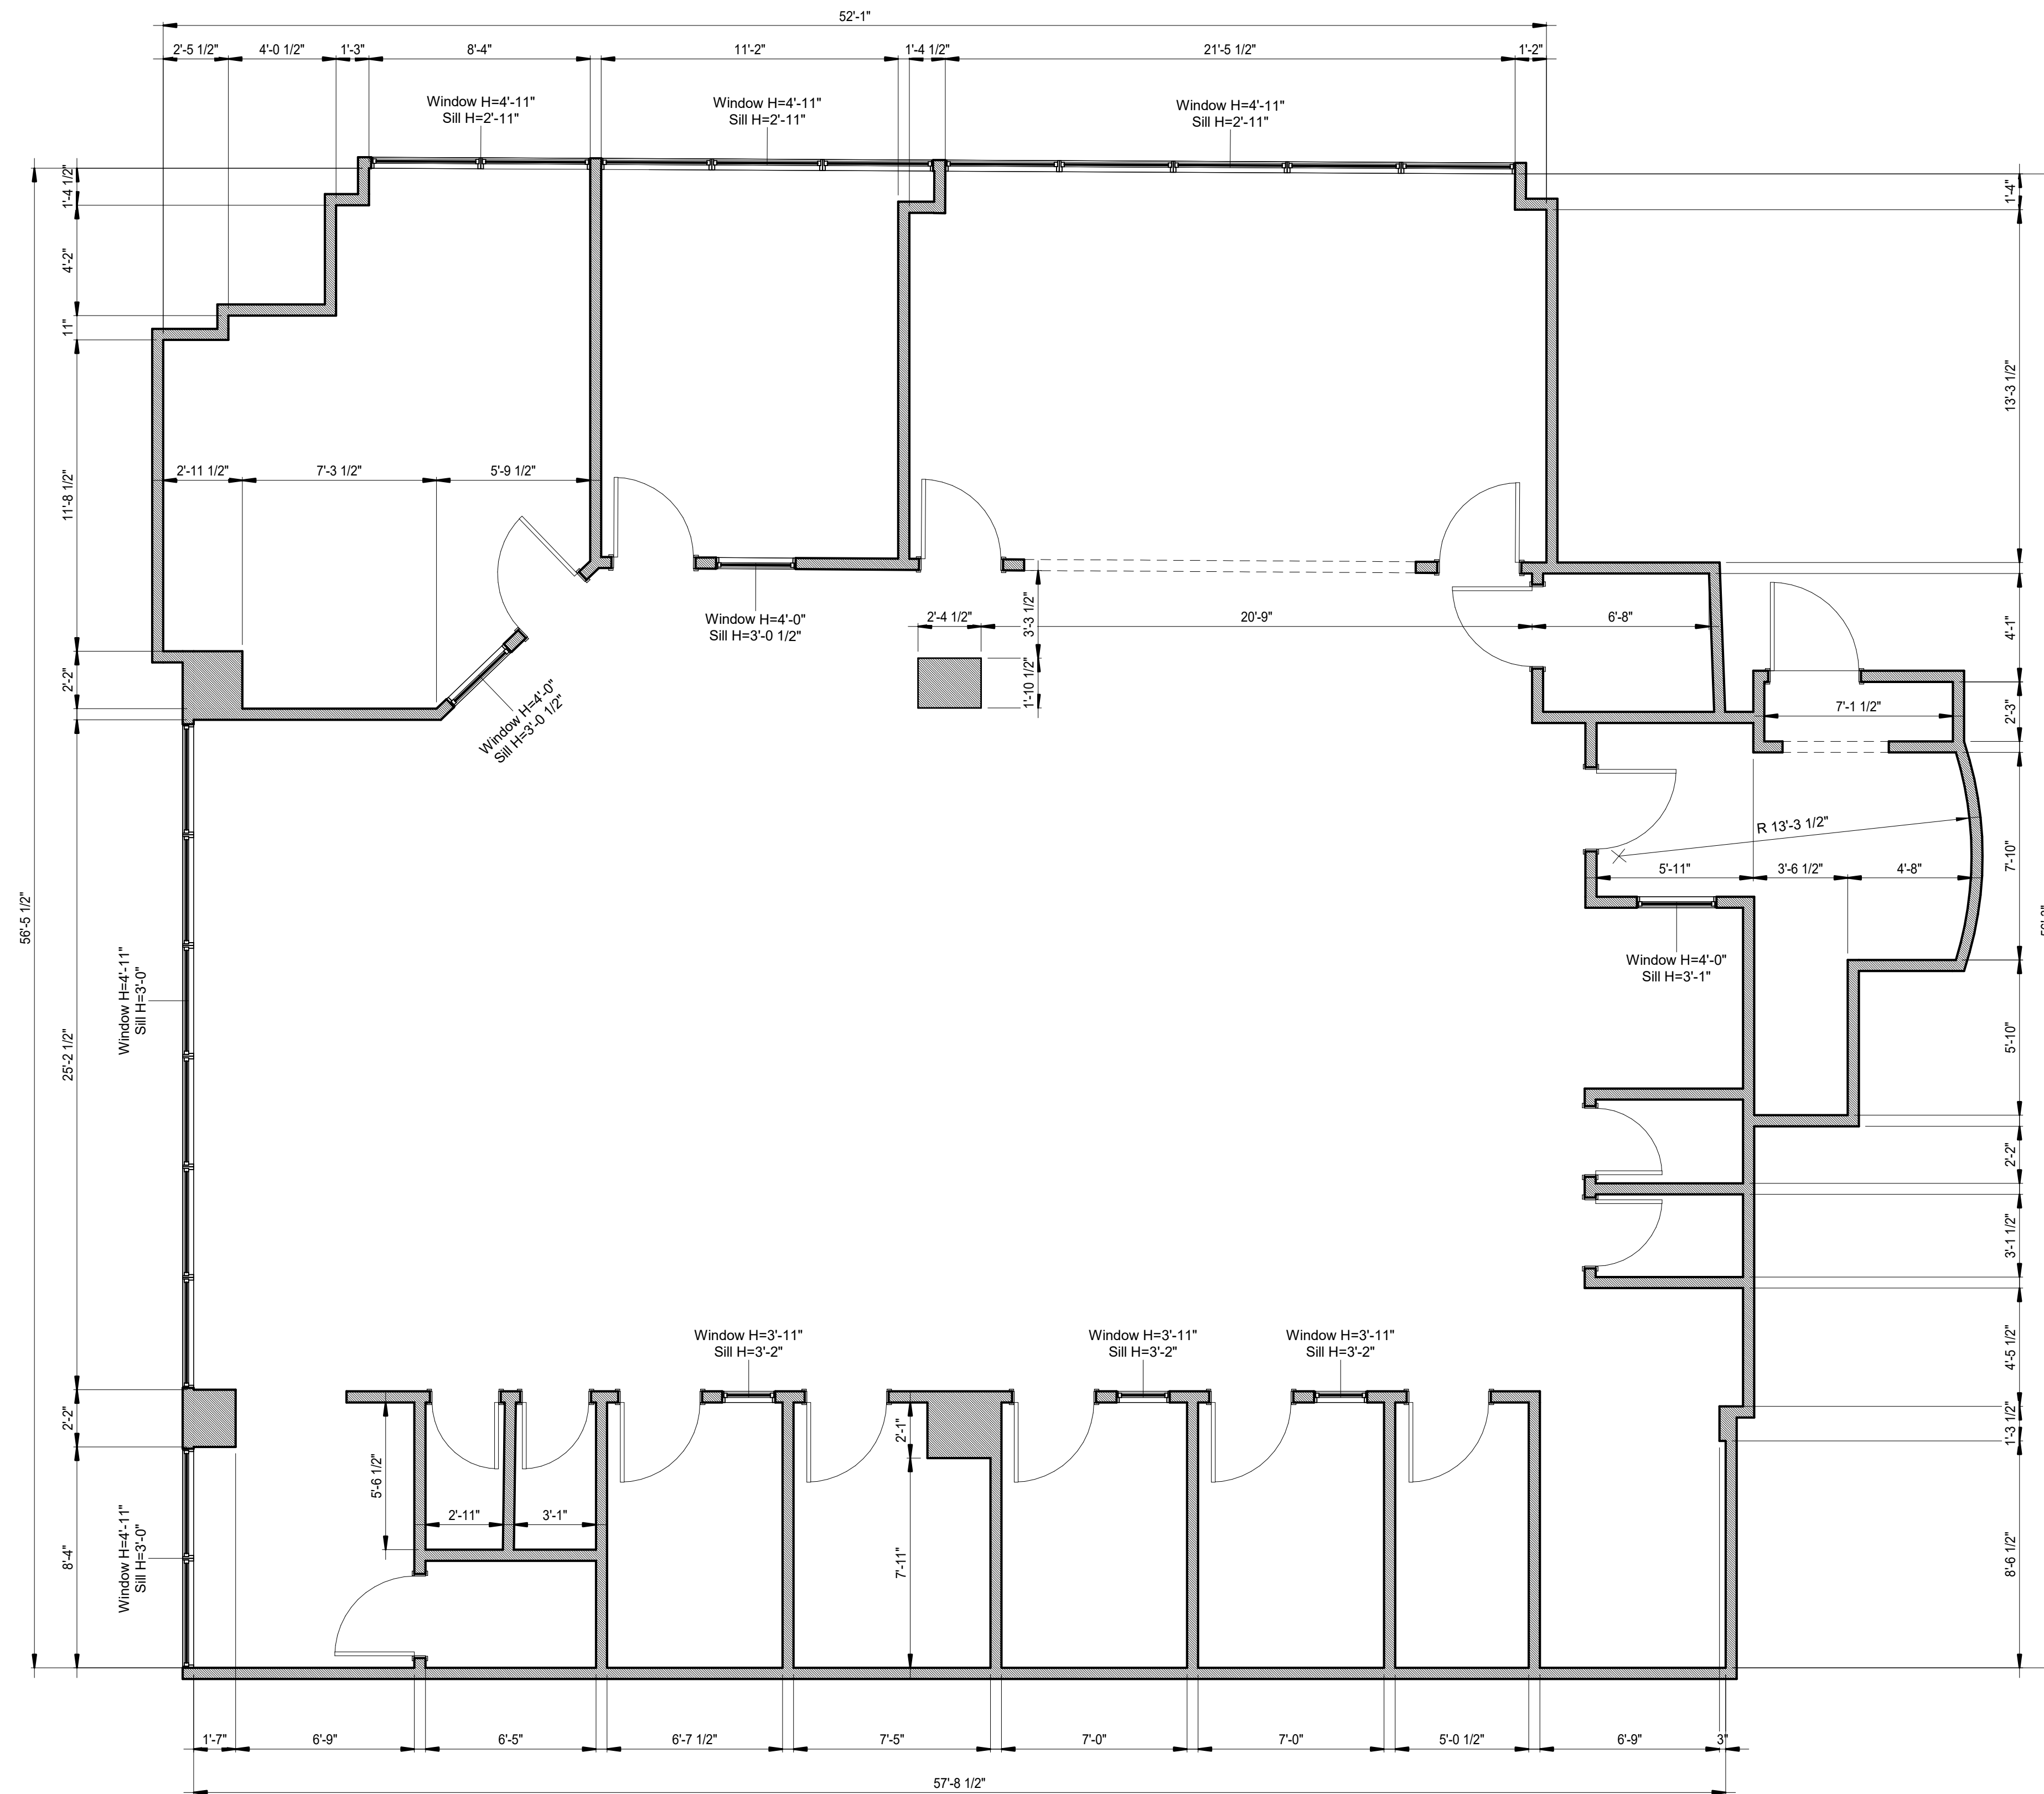

① As-built First Floor Plan
1/4" = 1'-0"



DOCUMENTATION & DETAILING

Plan A Services Inc.
70 Gilbert St
Monroe NY 10950

718.219.4749

info@planaservices.com
planaservices.com

Project

222 NY-59, Ramapo
NY 10901

Drawing

**As-built
Ceiling Plan**

A - 002.00


Area 3357.7 SF

Scale 1/4" = 1'-0"


Date 08/27/2023

Drawn By O. P.

Notes

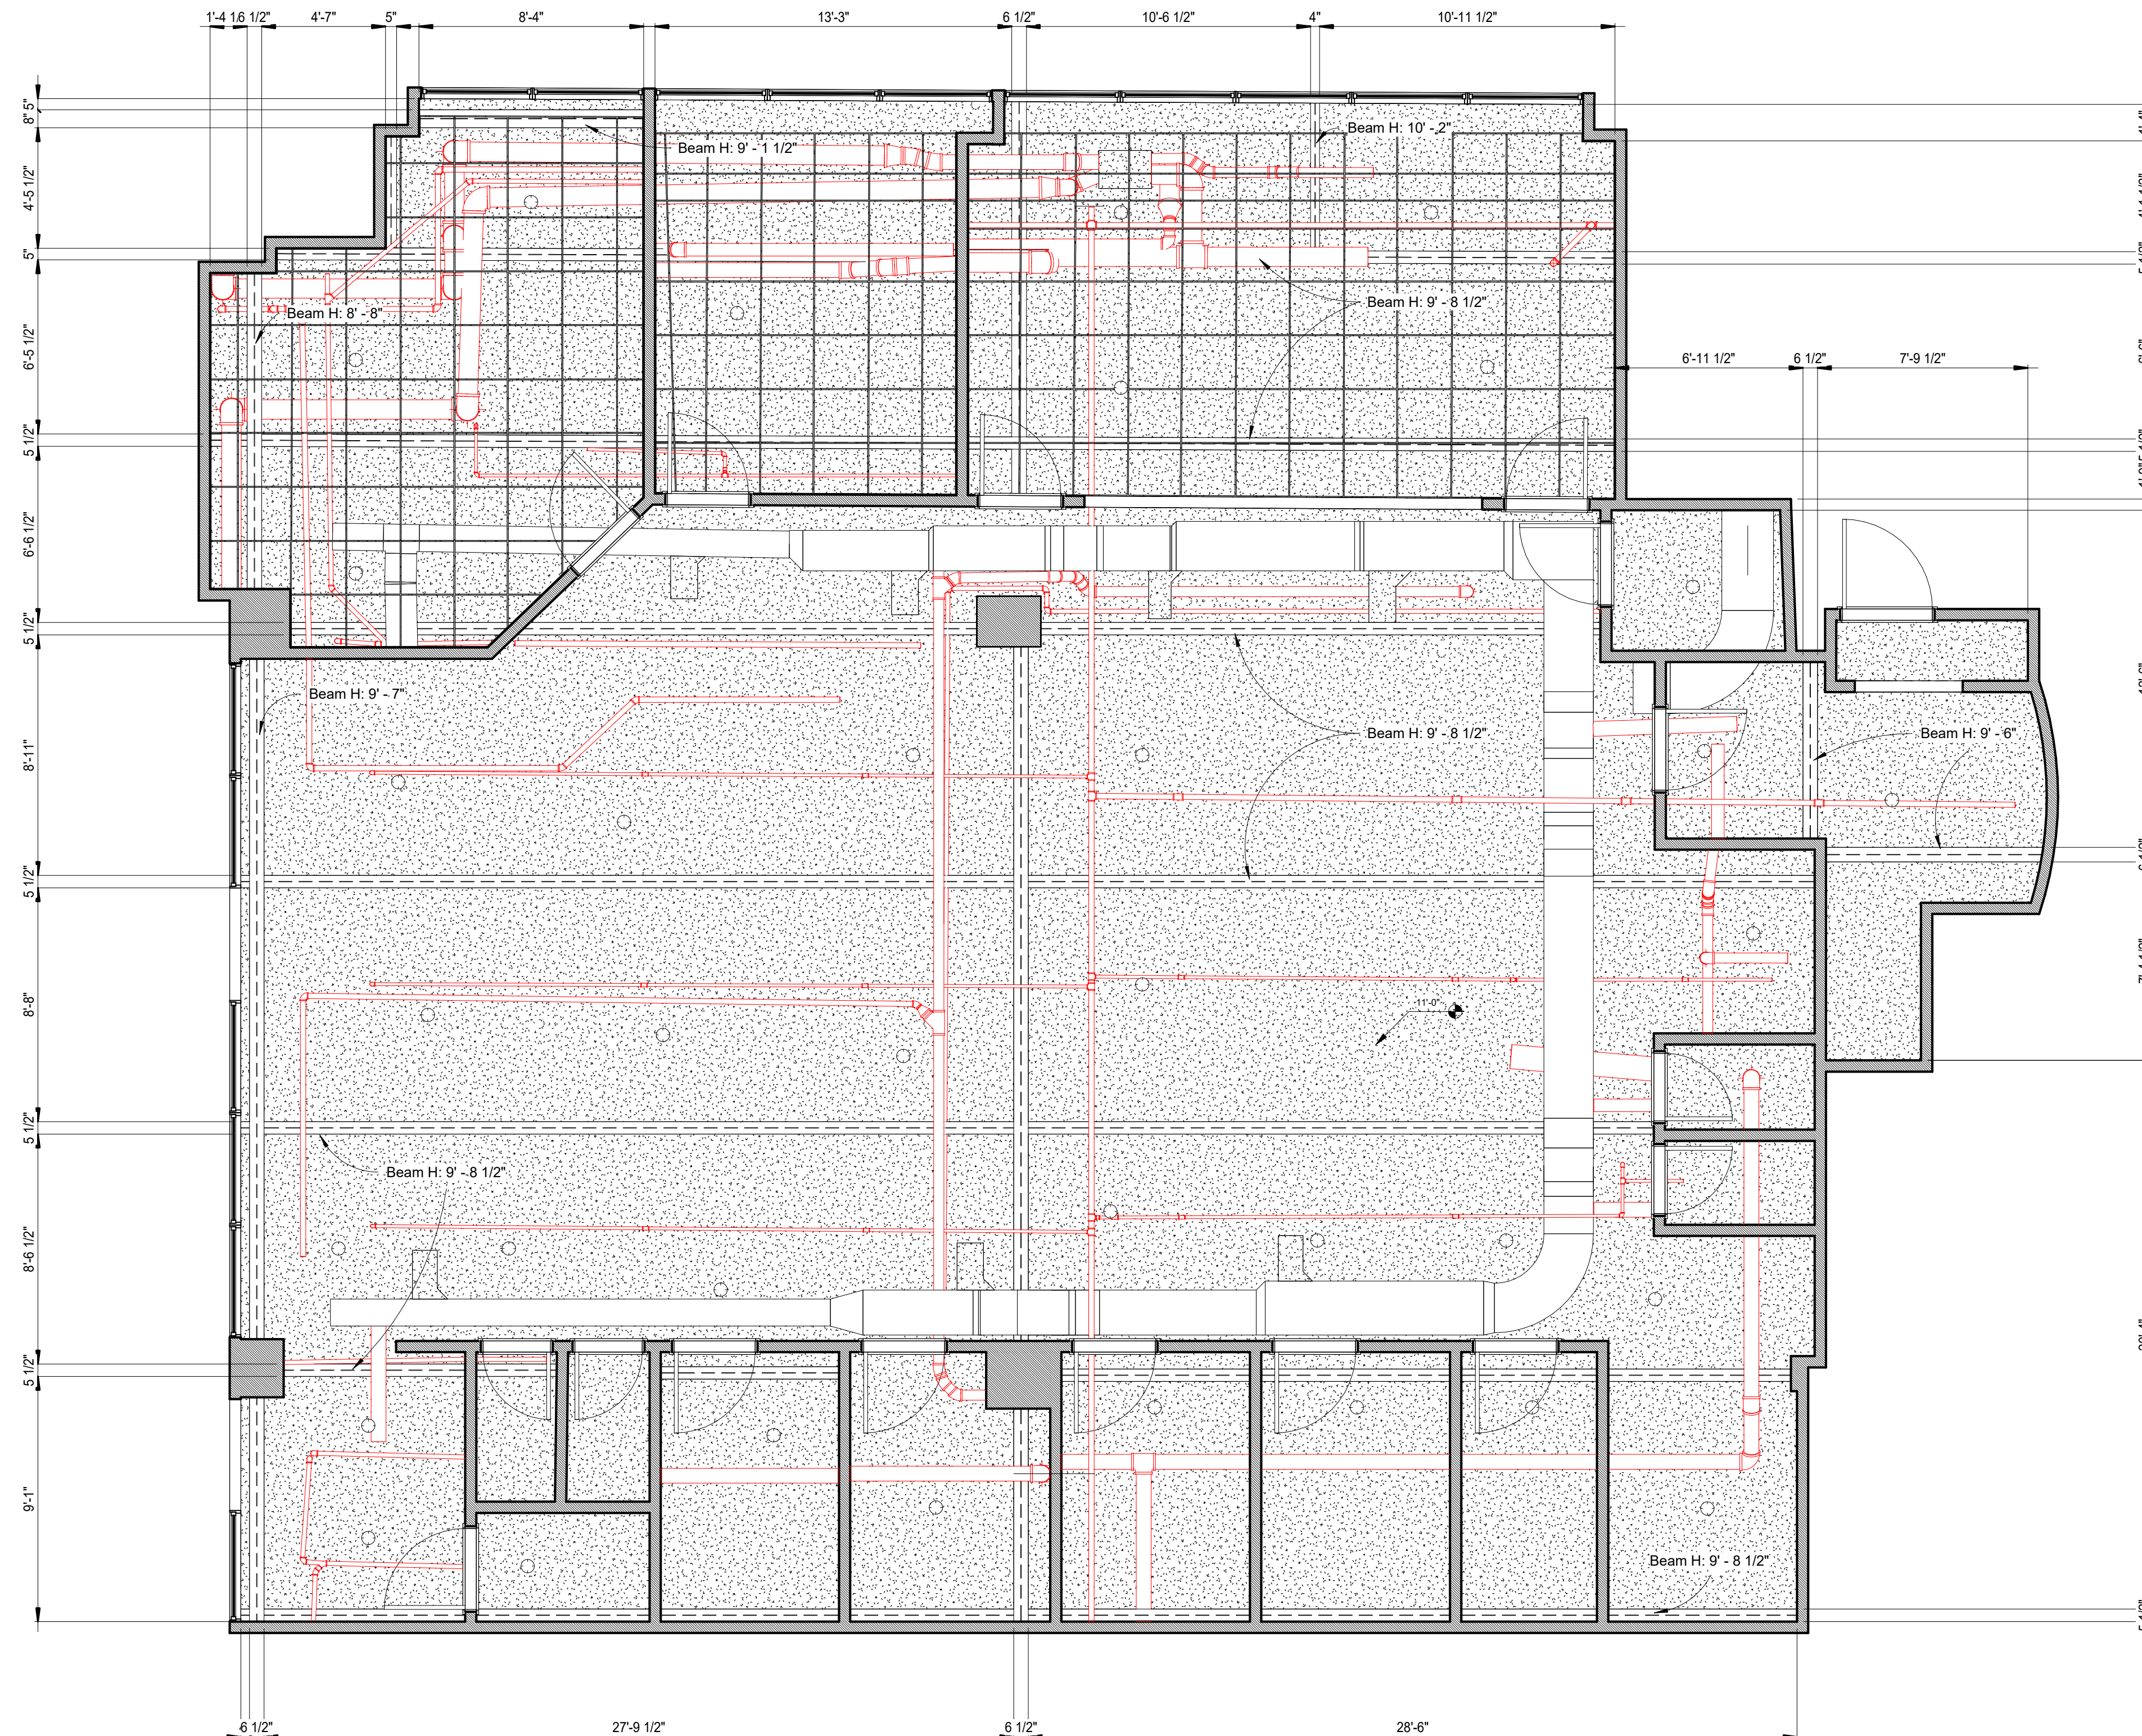

① As-built First Ceiling Plan
1/4" = 1'-0"

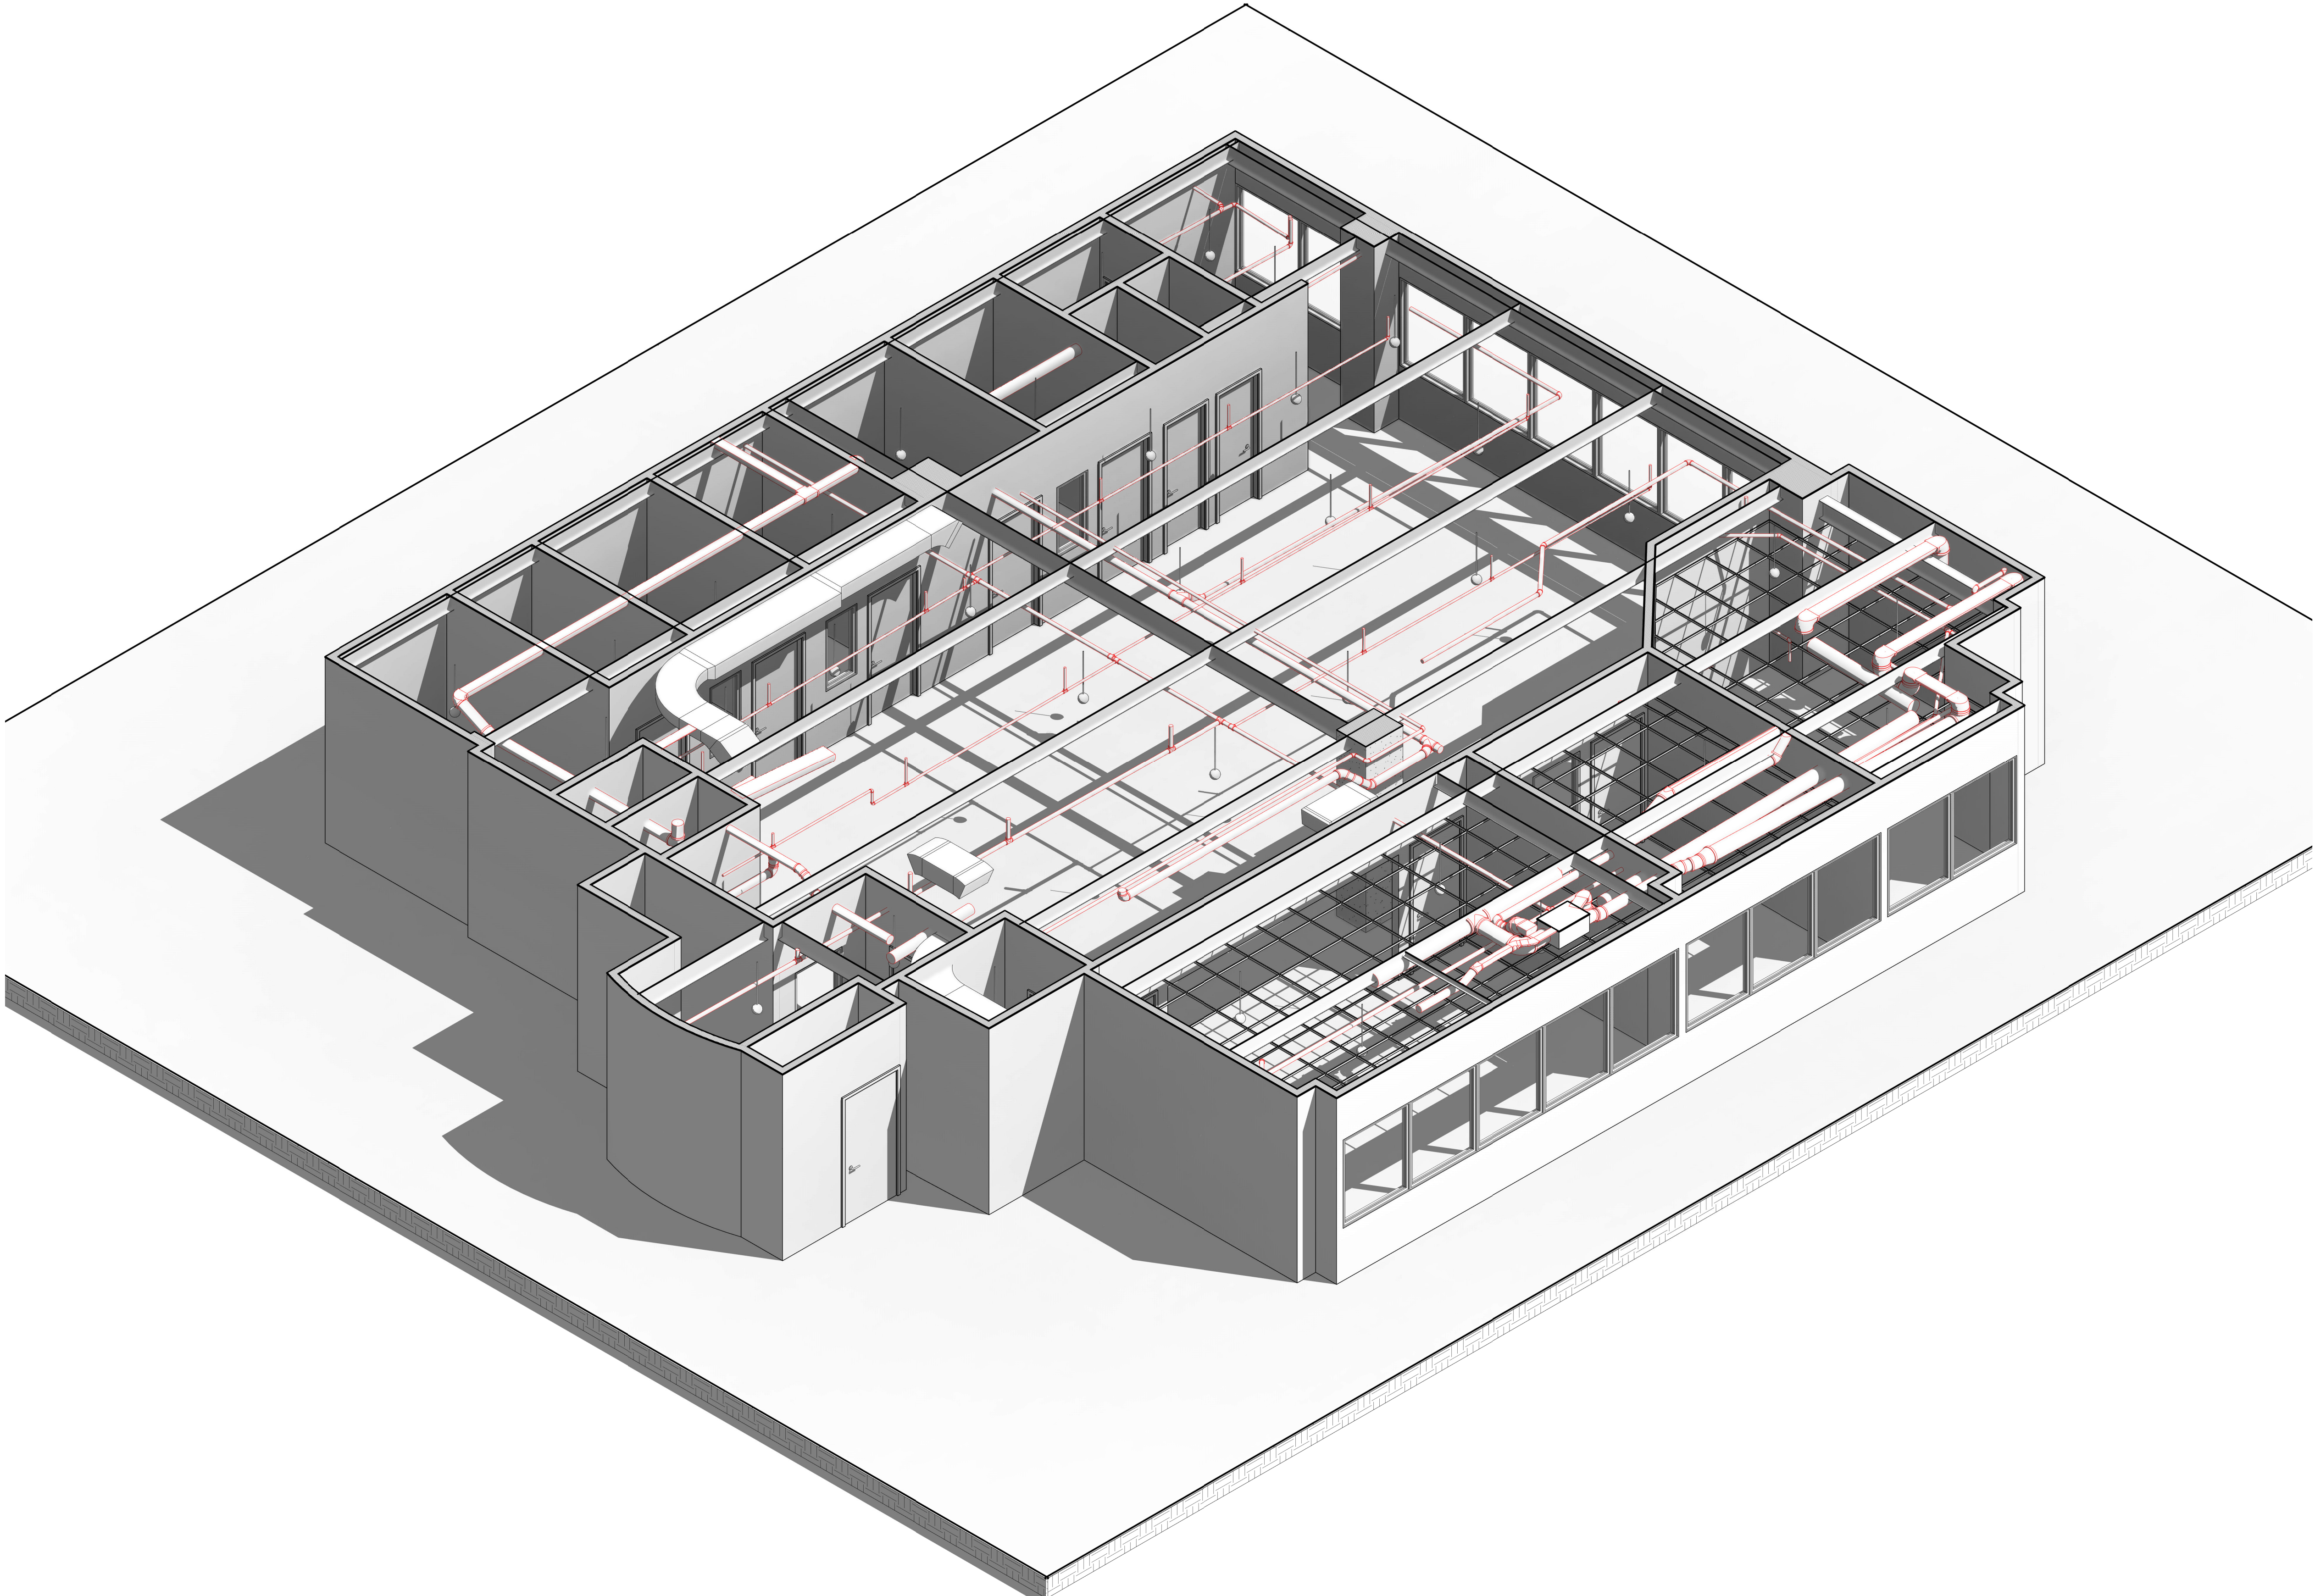

Plan A Services Inc.
70 Gilbert St
Monroe NY 10950

718.219.4749

info@planaservices.com
planaservices.com

Project

222 NY-59, Ramapo
NY 10901

Drawing

A

B

3D Views

A - 003.00

Area	3357.7 SF
Scale	
Date	08/27/2023
Drawn By	O. P.
Notes	