[illegible]

474 Summit Street, Elgin, Illinois, 60120, US

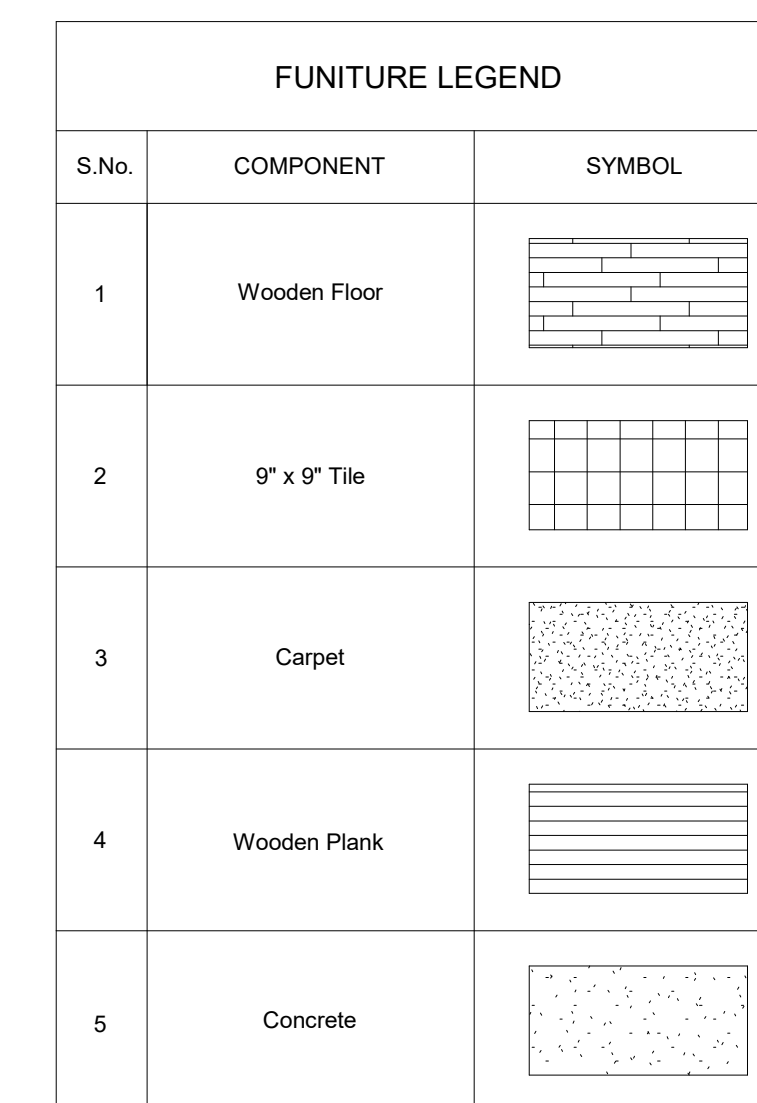
Basement Floorplan

Checked by	Checker
------------	---------

A1.00

Scale	1/4" = 1'-0"
-------	--------------

11/22/2024 10:27:06 AM

[illegible]

474 Summit Street, Elgin, Illinois, 60120, US

First Floor Floorplan

Checked by	Checker
------------	---------

A1.01

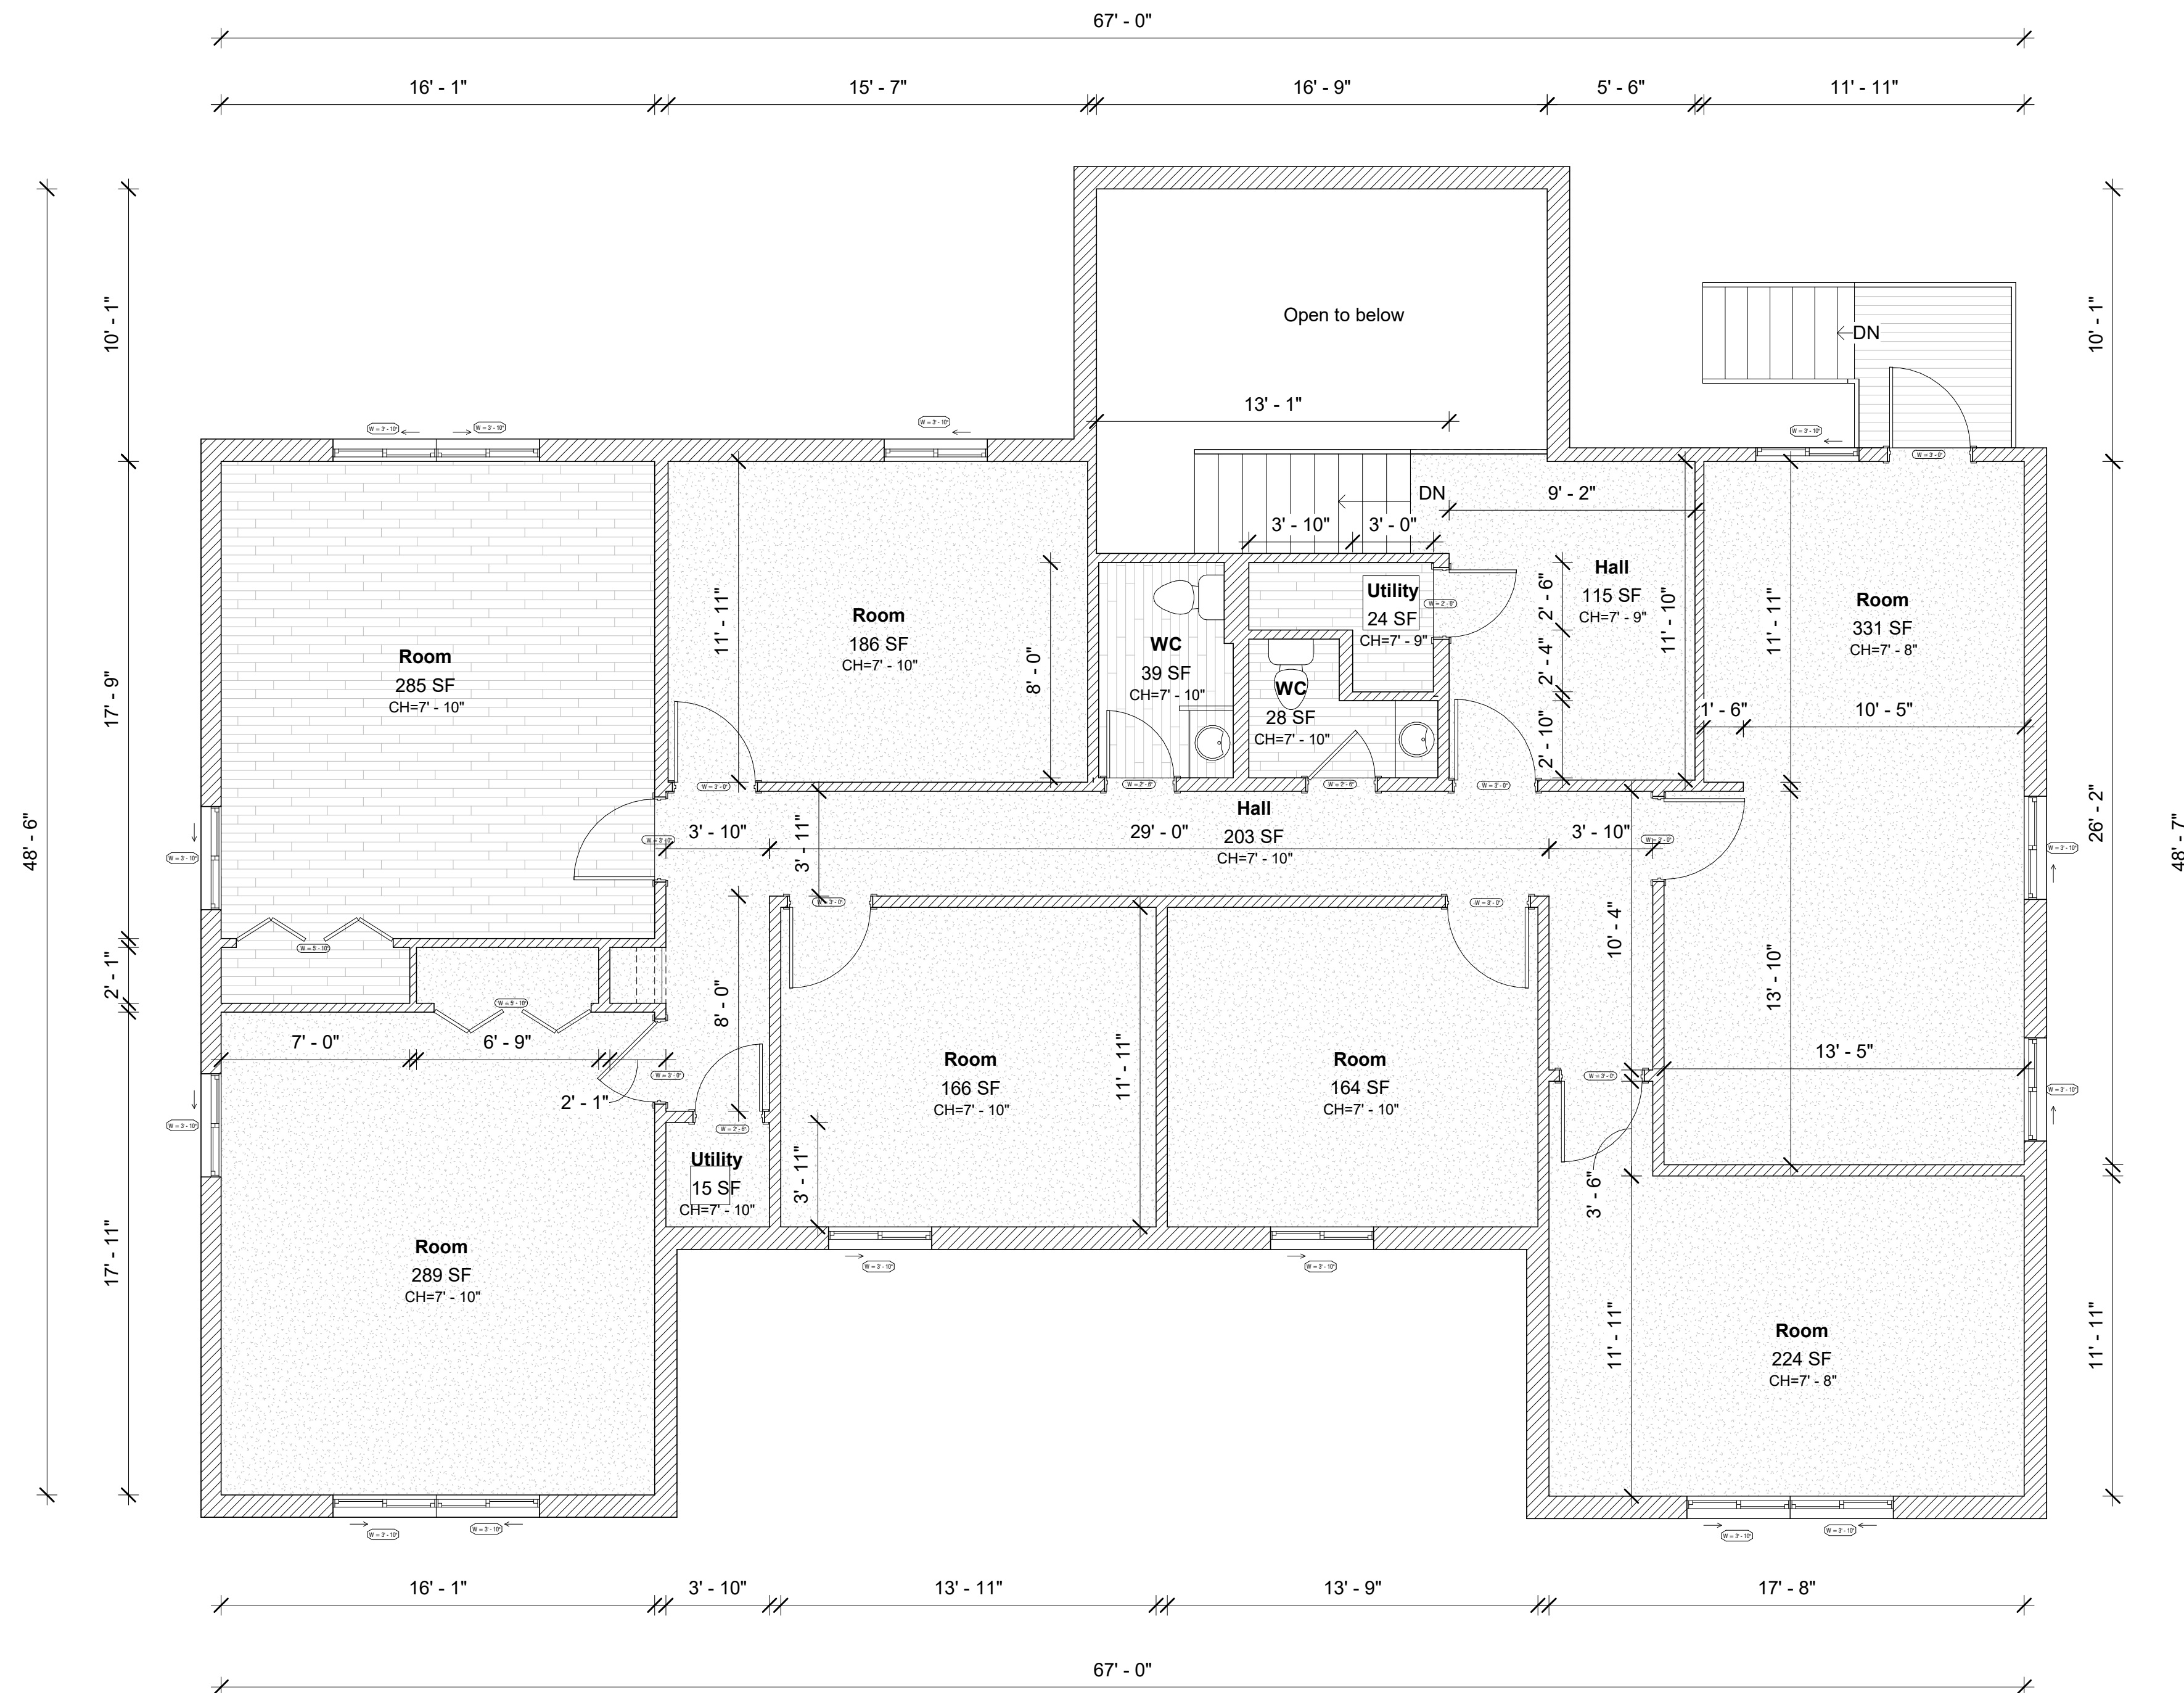
Scale	1/4" = 1'-0"
-------	--------------

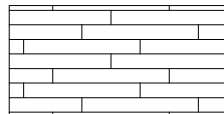
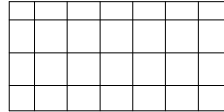
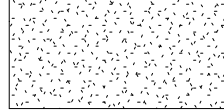
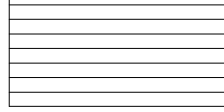
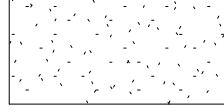
***DISCLAIMER:** Laser/LiDAR scanning is a measurement tool to assist in capturing as-built conditions of existing spaces and should be used in conjunction with other sound industry practices for verifying these conditions, including but not limited to: site visits, manual field measurements, and verifications of scan data, to ensure its accuracy prior to design and engineering. Because this data can be used for various applications and disciplines outside the scope of the original field scanning and beyond our control, we cannot guarantee that the data is accurate for these uses.

DATE: 11/10/2011



VirtualSpace.xyz



FUNITURE LEGEND		
S.No.	COMPONENT	SYMBOL
1	Wooden Floor	
2	9" x 9" Tile	
3	Carpet	
4	Wooden Plank	
5	Concrete	

[illegible]

474 Summit Street

474 Summit Street, Elgin, Illinois, 60120, US

Second Floor Floorplan

Project number	0001
----------------	------

Date	11/21/2024
------	------------

Drawn by	Author
----------	--------

Checked by	Checker
------------	---------

A1.02

Scale	1/4" = 1'-0"
-------	--------------

***DISCLAIMER:** Laser/LiDAR scanning is a measurement tool to assist in capturing as-built conditions of existing spaces and should be used in conjunction with other sound industry practices for verifying these conditions, including but not limited to: site visits, manual field measurements, and verifications of scan data, to ensure its accuracy prior to design and engineering. Because this data can be used for various applications and disciplines outside the scope of the original field scanning and beyond our control, we cannot guarantee that the data is accurate for these uses.

11/22/2024 10:27:19 AM