


Concord Professional Center

1010 Concord Pike, Wilmington, DE 19802

North Wing

1st floor | 6,242 SF
(As built plan)

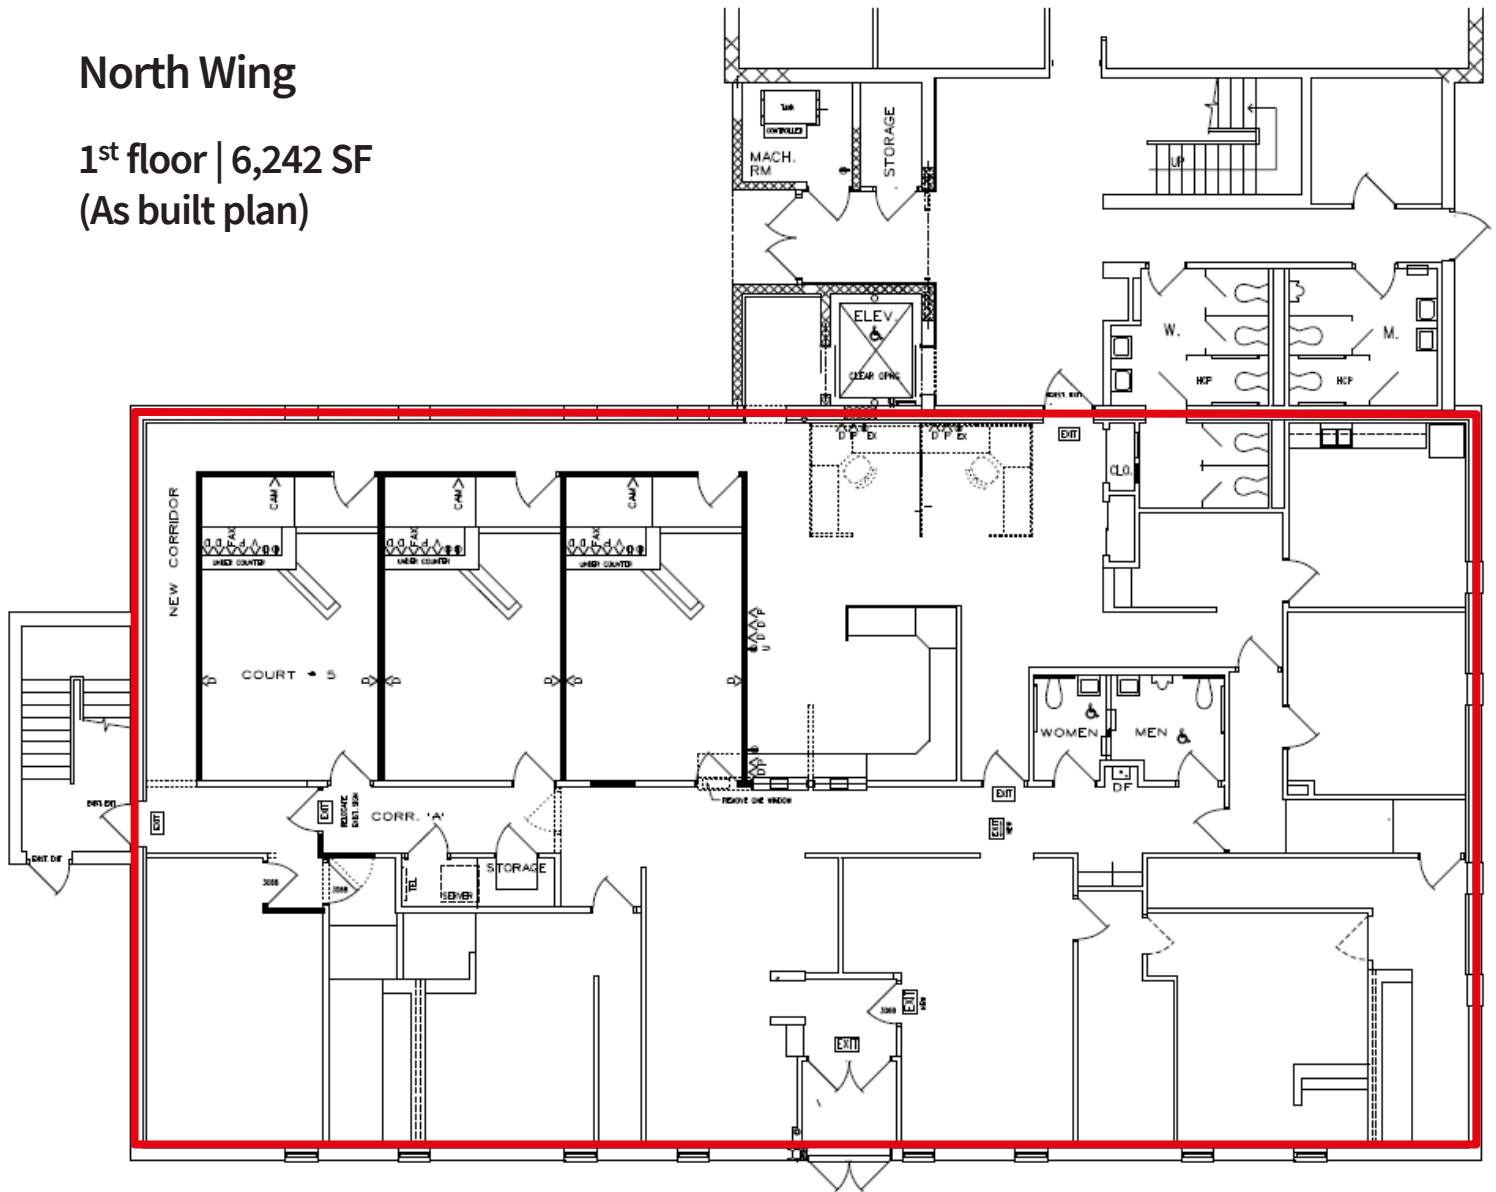

Contact

Cindy Fleming
+1 302 356 2866
cindy.fleming@am.jll.com

Blaise Fletcher
+1 302 356 2861
blaise.fletcher@am.jll.com



Although information has been obtained from sources deemed reliable, JLL does not make any guarantees, warranties or representations, express or implied, as to the completeness or accuracy as to the information contained herein. Any projections, opinions, assumptions or estimates used are for example only. There may be differences between projected and actual results, and those differences may be material. JLL does not accept any liability for any loss or damage suffered by any party resulting from reliance on this information. If the recipient of this information has signed a confidentiality agreement with JLL regarding this matter, this information is subject to the terms of that agreement. ©2021. Jones Lang LaSalle IP, Inc. All rights reserved.


Jones Lang LaSalle Brokerage, Inc. | 1007 N. Orange Street, Suite 400, Wilmington, DE 19801 | +1 302 356 2858

Concord Professional Center

1010 Concord Pike, Wilmington, DE 19802

North Wing

2nd floor | 6,242 SF
(As built plan)

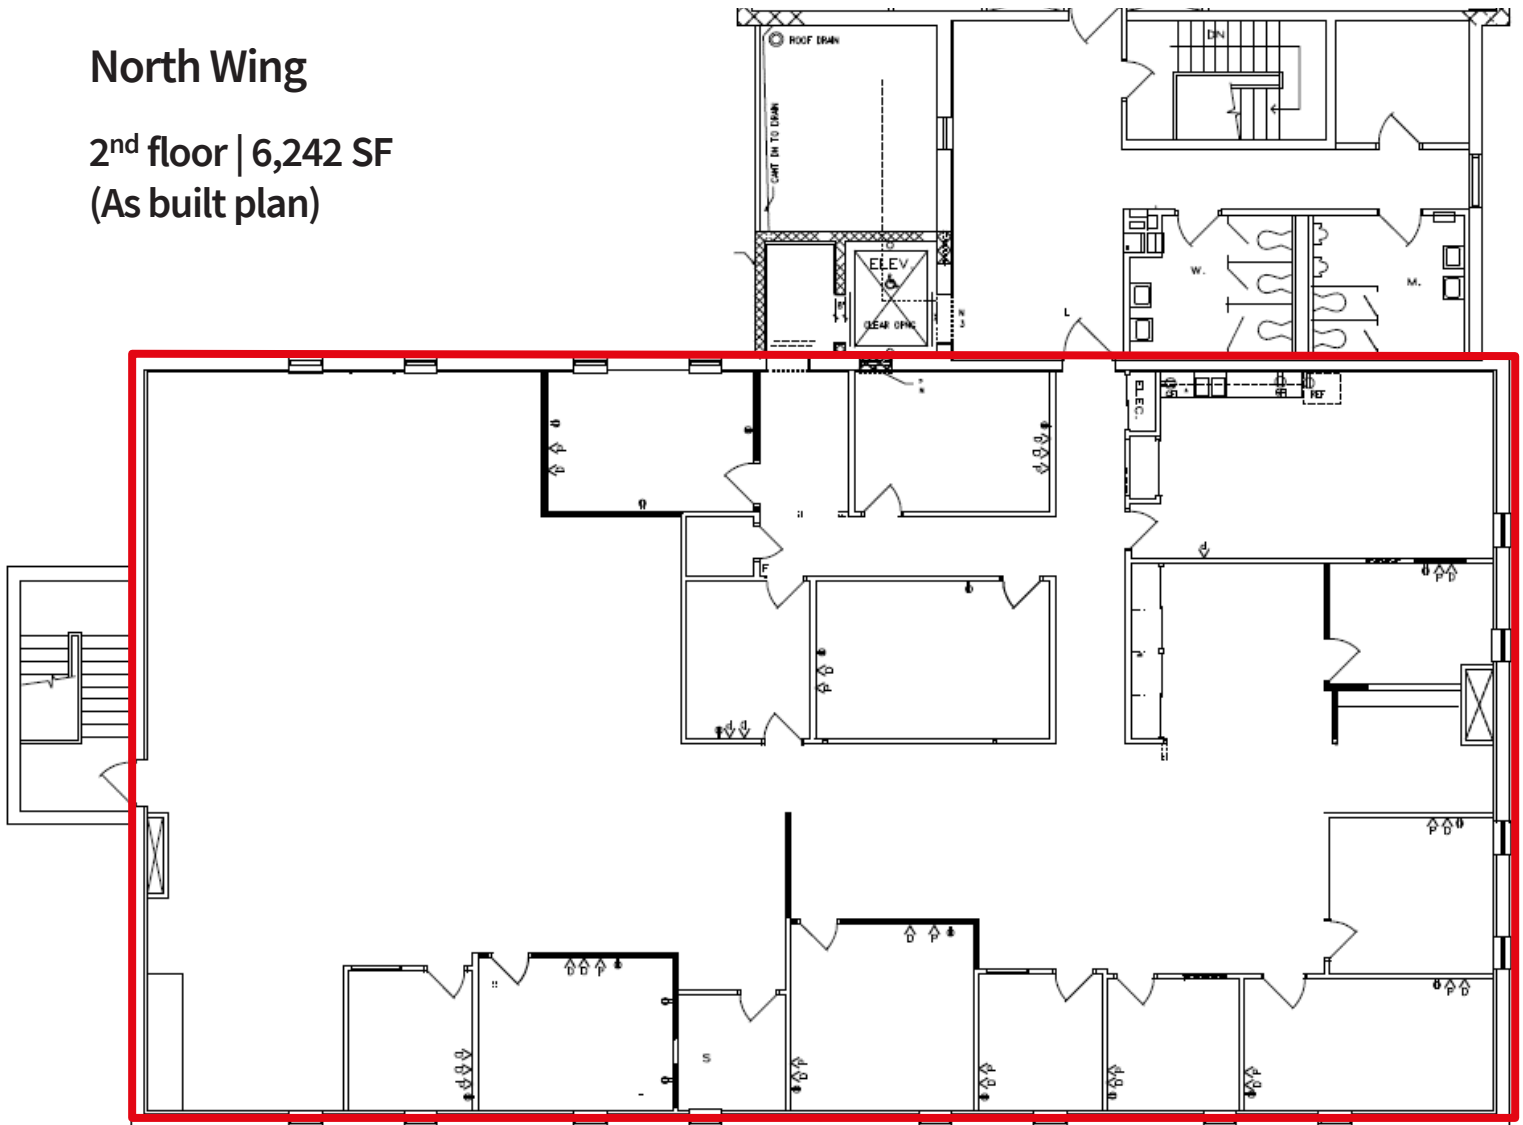

Contact

Cindy Fleming
+1 302 356 2866
cindy.fleming@am.jll.com

Blaise Fletcher
+1 302 356 2861
blaise.fletcher@am.jll.com



Although information has been obtained from sources deemed reliable, JLL does not make any guarantees, warranties or representations, express or implied, as to the completeness or accuracy as to the information contained herein. Any projections, opinions, assumptions or estimates used are for example only. There may be differences between projected and actual results, and those differences may be material. JLL does not accept any liability for any loss or damage suffered by any party resulting from reliance on this information. If the recipient of this information has signed a confidentiality agreement with JLL regarding this matter, this information is subject to the terms of that agreement. ©2021. Jones Lang LaSalle IP, Inc. All rights reserved.


Jones Lang LaSalle Brokerage, Inc. | 1007 N. Orange Street, Suite 400, Wilmington, DE 19801 | +1 302 356 2858

Concord Professional Center

1010 Concord Pike, Wilmington, DE 19802

South Wing 2nd Floor

Suite 203 | 1,538 SF
(As built plan)

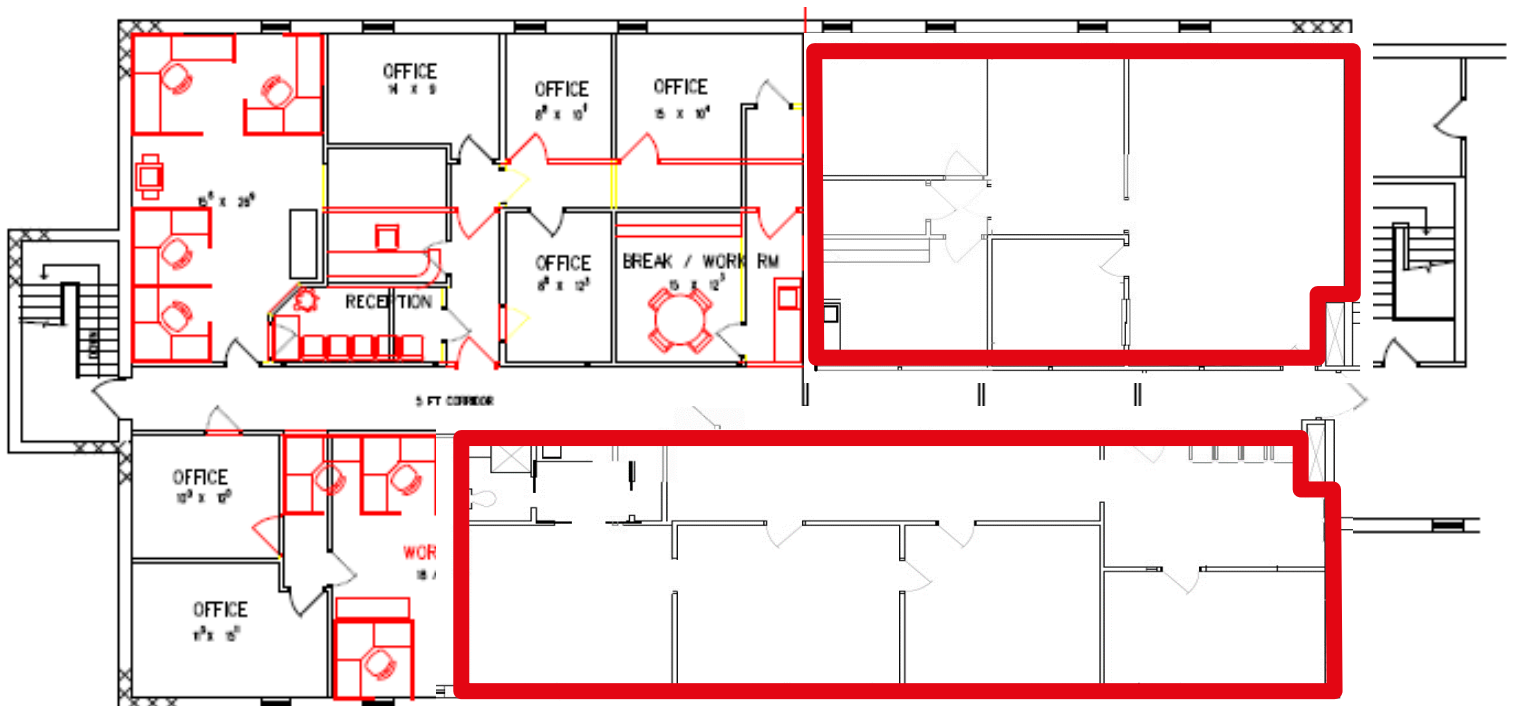

Suite 201 | 1,783 SF
(As built plan)

Contact

Cindy Fleming
+1 302 356 2866
cindy.fleming@am.jll.com

Blaise Fletcher
+1 302 356 2861
blaise.fletcher@am.jll.com




Although information has been obtained from sources deemed reliable, JLL does not make any guarantees, warranties or representations, express or implied, as to the completeness or accuracy as to the information contained herein. Any projections, opinions, assumptions or estimates used are for example only. There may be differences between projected and actual results, and those differences may be material. JLL does not accept any liability for any loss or damage suffered by any party resulting from reliance on this information. If the recipient of this information has signed a confidentiality agreement with JLL regarding this matter, this information is subject to the terms of that agreement. ©2021. Jones Lang LaSalle IP, Inc. All rights reserved.

Jones Lang LaSalle Brokerage, Inc. | 1007 N. Orange Street, Suite 400, Wilmington, DE 19801 | +1 302 356 2858


Concord Professional Center

1010 Concord Pike, Wilmington, DE 19802

South Wing Suite 201 | 1,783 SF (As built plan)

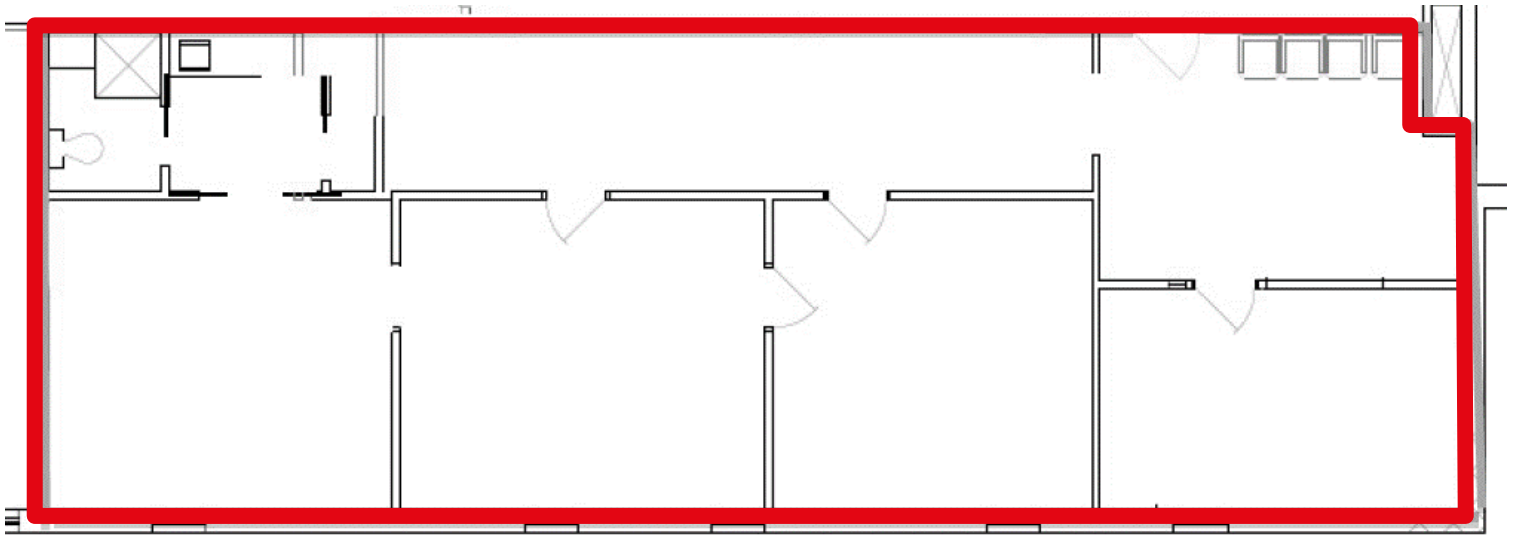

South Wing Suite 203 | 1,538 SF (As built plan)

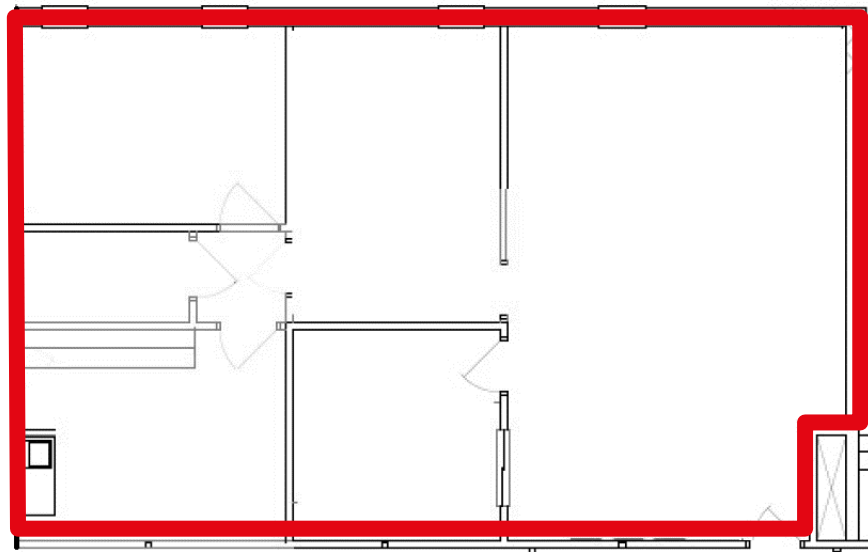

Contact

Cindy Fleming
+1 302 356 2866
cindy.fleming@am.jll.com

Blaise Fletcher
+1 302 356 2861
blaise.fletcher@am.jll.com



Although information has been obtained from sources deemed reliable, JLL does not make any guarantees, warranties or representations, express or implied, as to the completeness or accuracy as to the information contained herein. Any projections, opinions, assumptions or estimates used are for example only. There may be differences between projected and actual results, and those differences may be material. JLL does not accept any liability for any loss or damage suffered by any party resulting from reliance on this information. If the recipient of this information has signed a confidentiality agreement with JLL regarding this matter, this information is subject to the terms of that agreement. ©2021. Jones Lang LaSalle IP, Inc. All rights reserved.

Jones Lang LaSalle Brokerage, Inc. | 1007 N. Orange Street, Suite 400, Wilmington, DE 19801 | +1 302 356 2858