


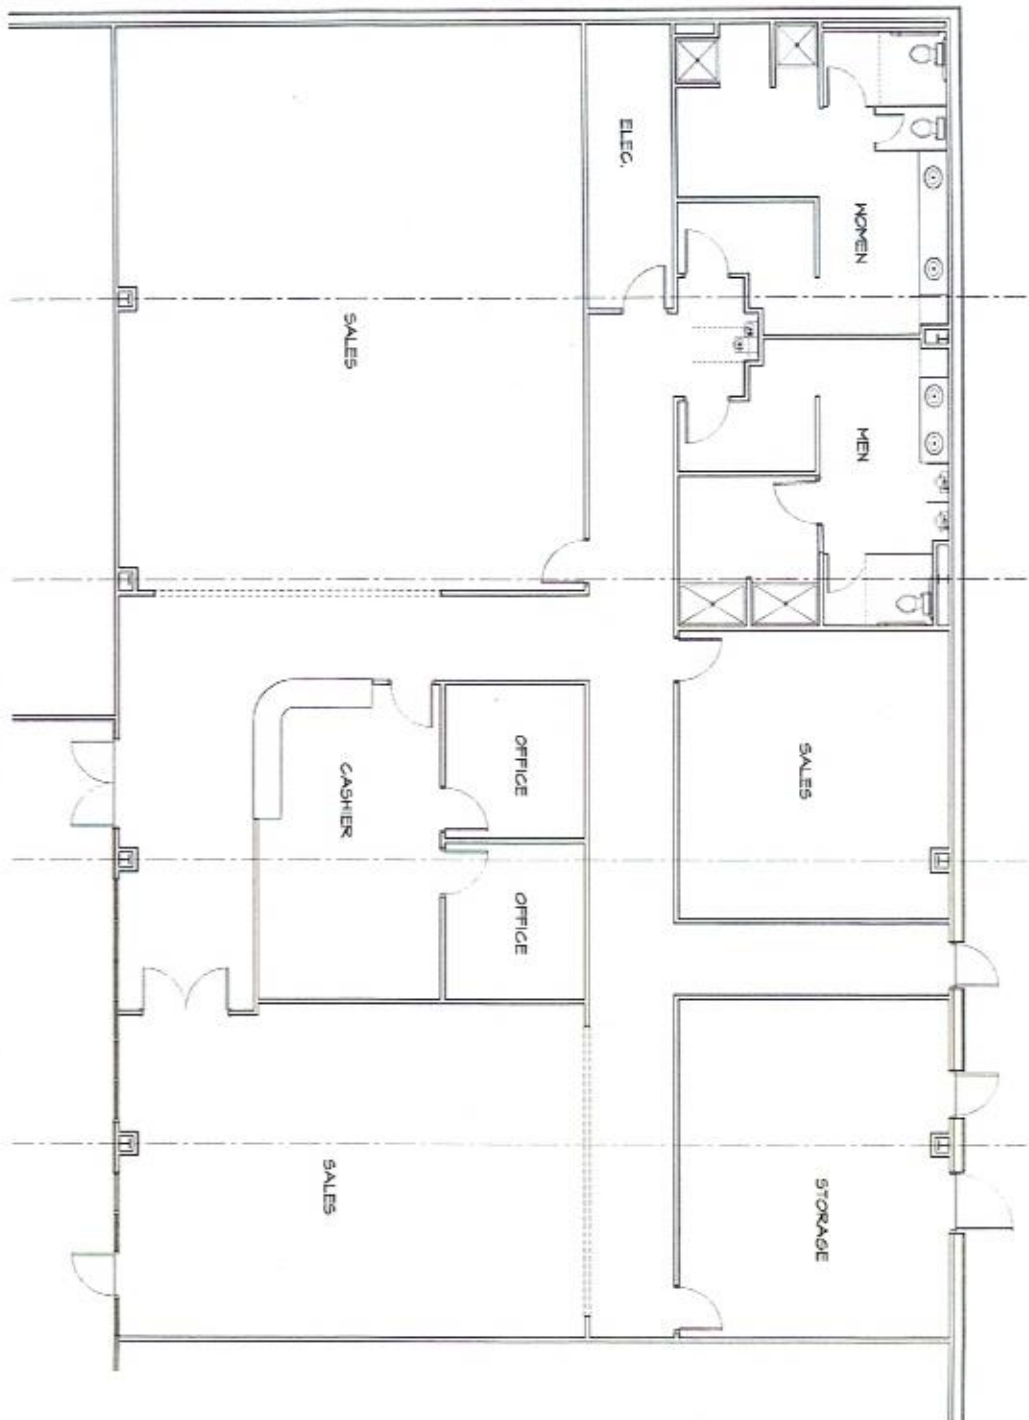

AS-BUILT FLOOR PLAN  
SCALE: 1/8" = 1'-0"

5,615 SQ. FT.

|                         |                                                                                              |                                                                                |                                                                                               |
|-------------------------|----------------------------------------------------------------------------------------------|--------------------------------------------------------------------------------|-----------------------------------------------------------------------------------------------|
| <b>A-1.1</b><br>SHEET # | PROJECT TITLE<br><b>RUSTIC VIBES</b><br>4470 WASHINGTON ROAD SUITE 8<br>EVANS, GEORGIA 30804 | PREPARED FOR<br><b>S.A.L.L.C.</b><br>122 DAVIS ROAD<br>MARTINEZ, GEORGIA 30057 | <b>DEFINITIVE<br/>DESIGNS<br/>GROUP INC.</b><br>1514 FOWLER RD. SUITE 100<br>AUSTIN, TX 78741 |
|                         | FLOOR PLAN                                                                                   | DATE: 11-1-2011<br>DRAWN BY: JPM<br>CHECKED BY: JPM                            |                                                                                               |
|                         | 10' X 10' SCALE<br>1/8" = 1'-0"                                                              |                                                                                |                                                                                               |
|                         |                                                                                              |                                                                                |                                                                                               |