

AOSE/PE Inspection Report and Completion Statement

Commonwealth of Virginia
State Department of Health

Health Department Identification Number: 115-18-0224 Tax Map: 20B-2-1

CAMPBELL Health Department

Name of AOSE/PE: CHARLES M. ALLISON, JR Certification Number: 1055

Address: 1695 COLONY HEIGHTS RD, GOODE, VA Telephone: 540-587-7125

Contractors Name: SONNY'S SEPTIC 24556

Owner's Name: RAIL ROAD DINER c/o REGGIE RUSSELL 24551

Owner's Address: 3714 WATERLICK RD. LYNCHBURG, VA 24502

Location of Installation: Subdivision: N/A Section: — Block: — Lot: 2.4 AC

Other: DRIVE-THRU DINER WATERLICK RD. AT SMITH RD.

Component	Inspection Results		Date Approved
	Comments, Materials, Etc.	Deficiencies Observed, Date Deficiencies Observed Corrective Action Required	
Water Supply Location and Construction	PUBLIC EXISTING		—
Building Sewer	STUB-OUT 10' 4" SCH 40 TO SIT. 3' 4" SCH 40 TO GREASE TRAP		
Septic Tank	1000 GALLON GREASE TRAP W/ RISERS 1000 GALLON CONCRETE SIT W/ FILTER & RISER		4-17-20 5-8-20
Inlet-Outlet Structure	4" SCH 40		
Pump and Pump Station	N/A		N/A
Conveyance Method	58' 4" SCH 40		4-17-20
Distribution Box or Pressure Manifold	8 PORT CONCRETE		"
Header, Conveyance, Return, etc. Lines	4" SCH 40		"
Percolation Lines, Drip, Chambers, etc.	GRAVEL		"
Absorption Trenches and Dispersal Field	2 90' x 3' LINES		"
(Other Components: treatment unit, etc.)	100" DEEP		"
	OWNER CHOSE TO INSTALL SHALLOW		4-27-20
	ROAD DITCH		VIA AC
	FRENCH DRAIN RATHER THAN 6 GRADING		5-25-20

COMMONWEALTH OF
C. M. ALLEN
CHARLES M. ALLEN

Attach observed deficiencies and corrective actions taken on a separate completion statement as necessary

Pg 1 of 4



Completion Statement

Commonwealth of Virginia
State Department of Health

Health Department
Identification Number: 115-18-0224
CAMPBELL Health Department

Name of Company/Corporation/Individual: SONNY'S SEPTIC TANK SERVICE
Address: 197 RODEO DR. AMHERST, VA 24521 Telephone: 434-528-5249
Owner's Name: RAIL ROAD DINER REGGIE RUSSELL
Owner's Address: 3714 WATERLICK RD. LYNCHBURG, VA 24502-24551
Location of Installation: Lot: FOREST Block: —
Section: — Subdivision: —
Other: T.M. 203-2-1

I hereby certify that the onsite sewage disposal system has been installed and completed in accordance with the construction permit issued.
(Date) 10-11-18 and is in compliance with Part D of the Sewage Handling and Disposal Regulations and when appropriate the plans and specifications for the project. EXTENDED DUE TO COVID.

Date 4/17/2020

Date

Signature and Title

Pg 2 of 4

OSE/PE Completion Statement: As-Built Drawing

Commonwealth of Virginia
State Department of Health


Health Department Identification Number: 115-18-0224

Tax Map: 20B-2-1

Triangulate critical system components to fixed reference points.

SMITH RD.
EDGE P'MENT

AS-BUILT
1" = 20'

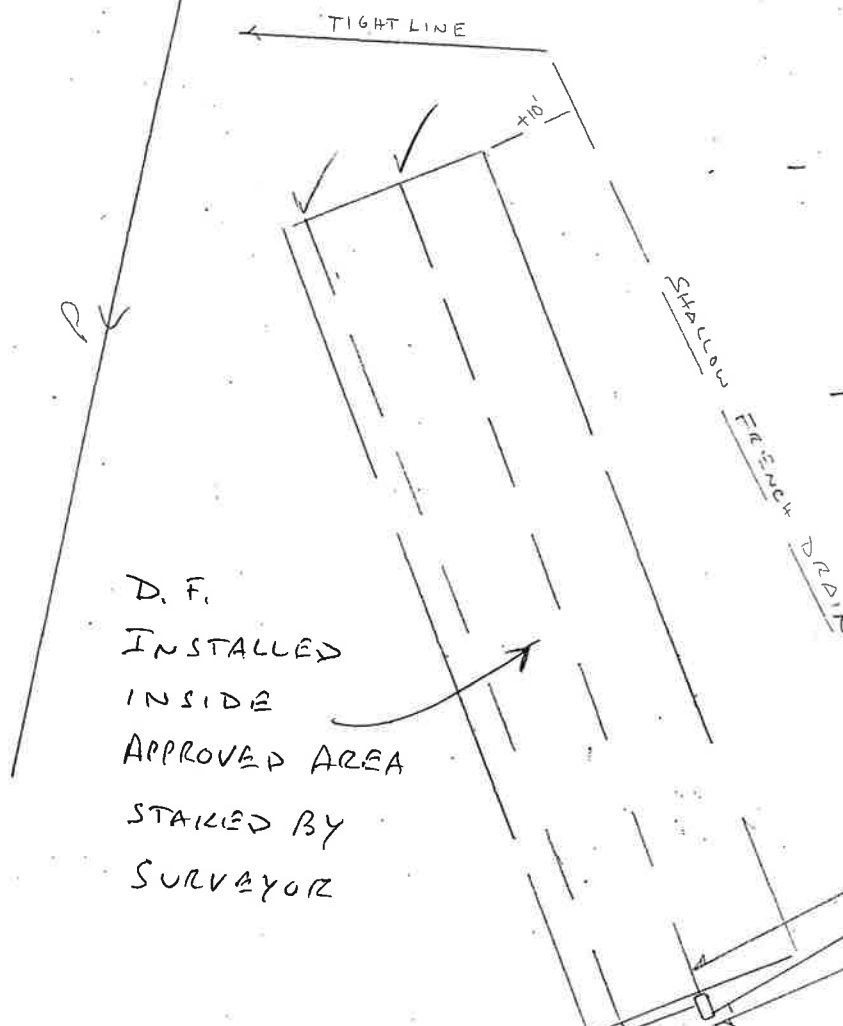

- OWNER INSTALLED SHALLOW FRENCH DRAIN (30" TO 36") RATHER THAN DITCH LINE AND GRADING.
- GREASE TRAP ABUTS BUILDING AS PER DESIGN

D.F.
INSTALLED
INSIDE
APPROVED AREA
STAKED BY
SURVEYOR

☐ Check here if as-built drawing is on a separate page attached to this form
(Attachment must display Health Dept. Identification Number, tax map number, and must be signed and dated by AOSE/PE).

I hereby certify that on 4-16, 4-17, 4-27-20 (date), I, or an employee under my direct supervision, inspected this sewage system's construction. The onsite sewage system has been installed and completed in accordance with the construction permit issued on 10-11-18 (date) and is in compliance with the *Sewage Handling and Disposal Regulations* (12 VAC 5-610 et seq), *Private Well Regulations* (12 VAC 5-630 et seq), when applicable, and the plans and specifications for the project.

OSE/PE Signature: C.M. Allison, Jr.

Date: 5-25-20

Print Name: C.M. Allison, Jr.

COMMONWEALTH OF VIRGINIA
5-25-20
CHARLES M. ALLISON, JR.
No. 1940001053

OSE Form BB: Revised 7/2/2009

PS. 3 of 4

LICENSED
ALTERNATIVE 2
ON-SITE SOIL EVALUATOR

N 59°03'40"W

351.35

2.305 Acres

TM. #20B-2-1

SOURCE OF TITLE & OWNER
REGINALD RANDOLPH russell
Instr.# 040002740

ROUTE 1549

ROAD

CALL 714

CENTERLINE

STATE ROUTE NO. 622

REGINALD RANDOLPH RUSSELL

COLLEGE DISTRICT, CAMPBELL CO. VI.
SCALE 1" = 200' 11/2" 10" 200'

DOUGLAS A. LEE
1128 TWO CHURCH LN
FOREST VA 24551

191-434-942-9130

REVISED DEC. 02, 2009
REVISED JUNE 02, 2011

REVISED FEB. 23, 2017 TO SHOW REVISED ENTRANCE
WATERLICK ROAD AS PER VDOT
REVISED 9-13-2017
REVISED 12-27-2017
REVISED 5-12-2020

COMMONWEALTH OF MASSACHUSETTS
DOUGLAS A. LEE
No. 1691
5-12-20
JANIS R. RYBON

COMMONWEALTH OF VIRGINIA
5-25-20
CHARLES M. ALLISON, JR.
No. 1940001055
LICENSED
ALTERNATIVE
ON-SITE SOIL EVALUATOR

BUILDING LOCATION
REVISION
SEPTIC AS-BUILT

Pg. 4 of 4