


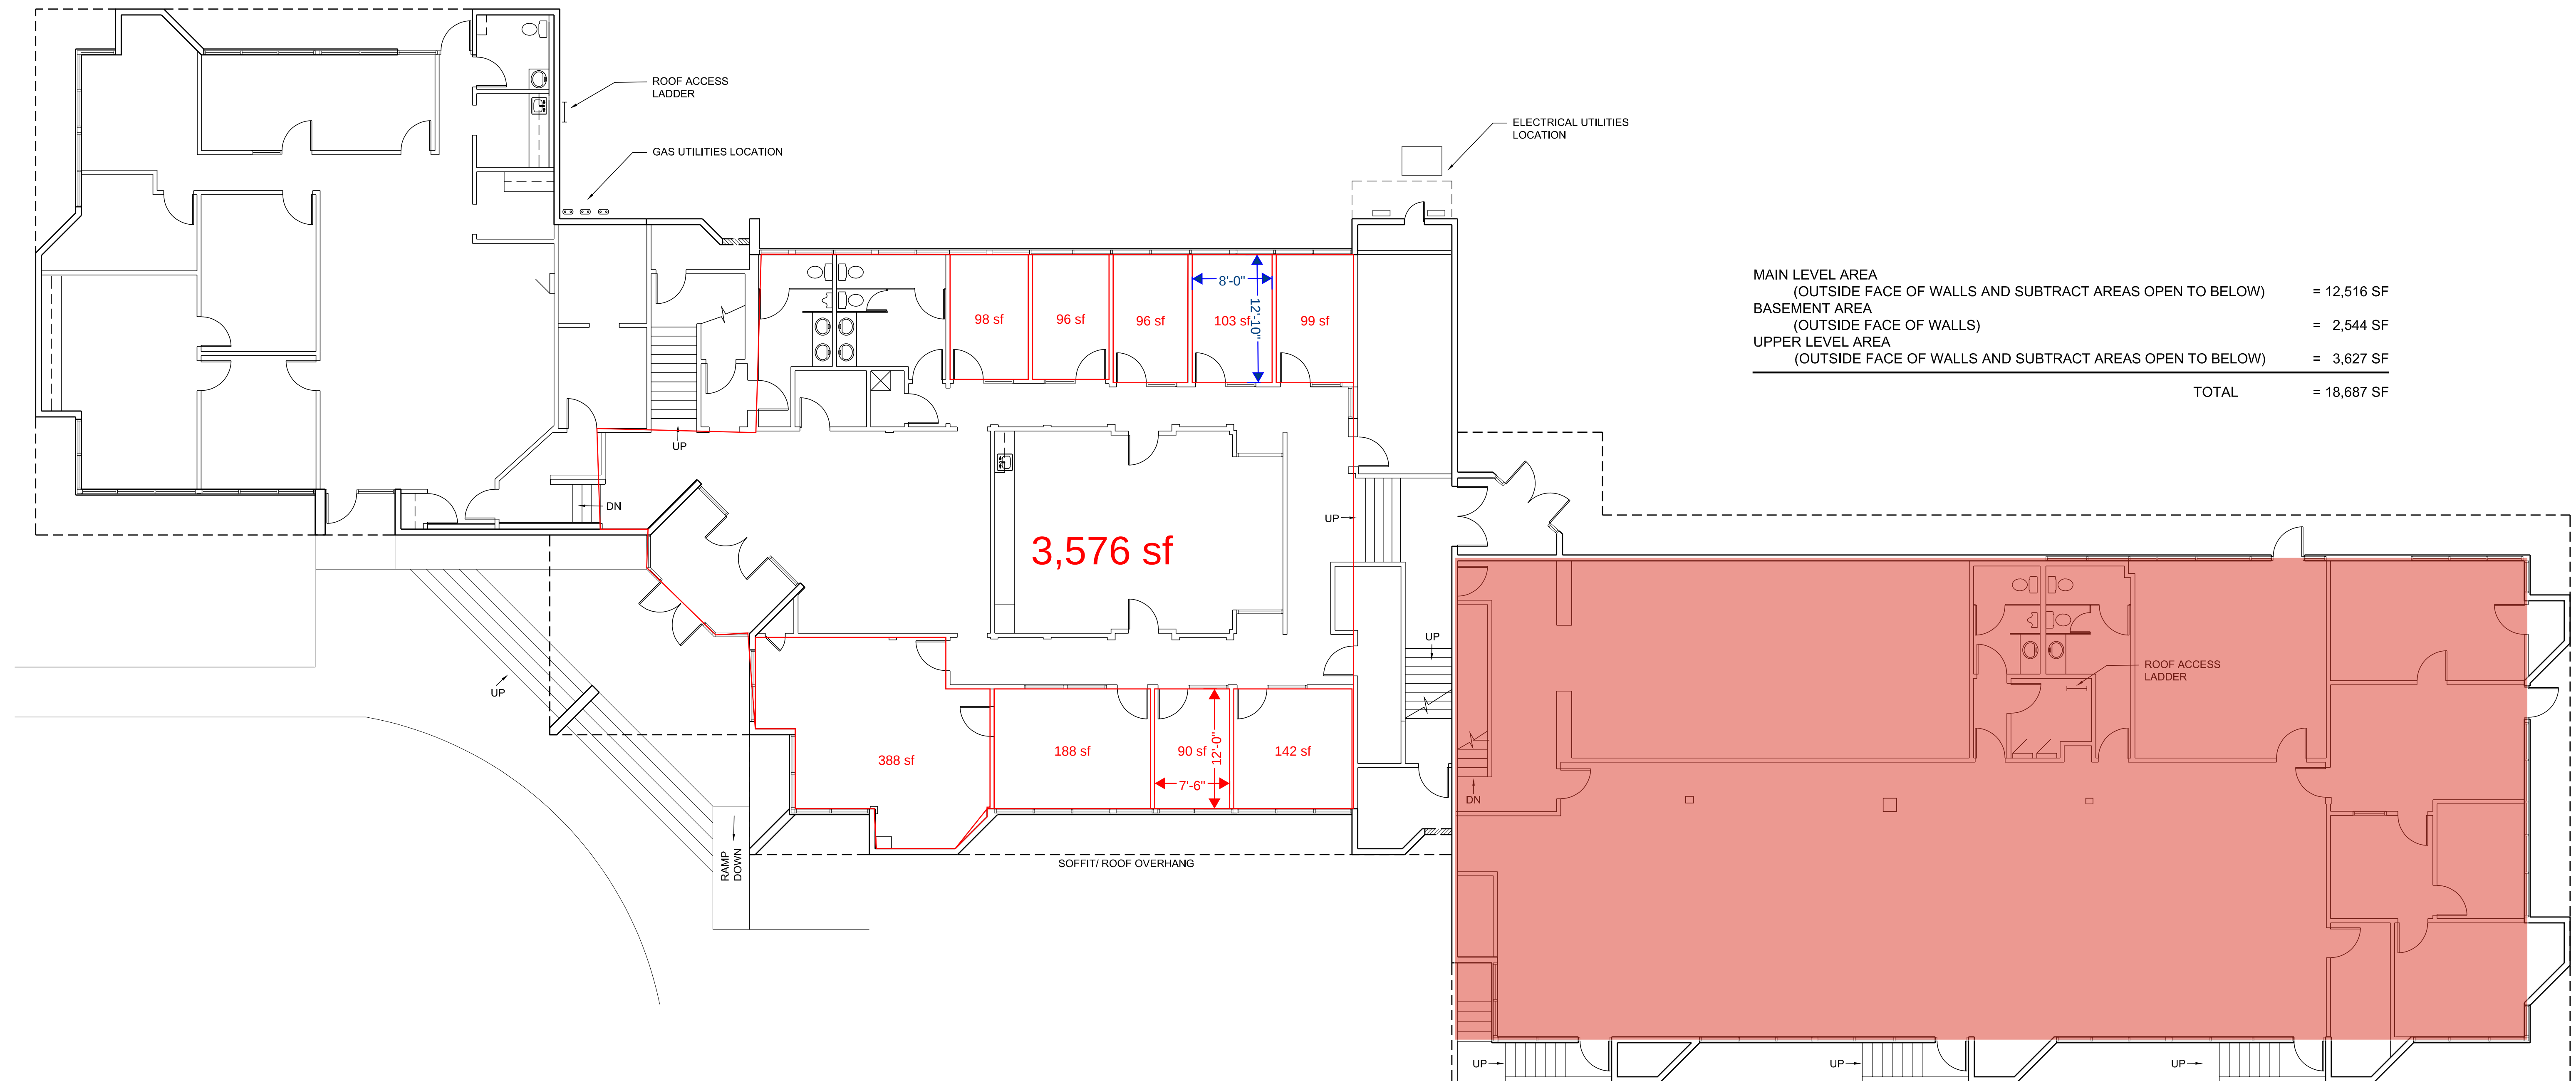

1 FIRST FLOOR PLAN

SCALE: 1/8" = 1'-0"

SCALE: 1/8" = 1'-0"




BASE CAMP
18050 BASE CAMP RD

18930 BASE CAMP RD,
MONUMENT, CO 80132

DATE	DESC.
4.10.2023	AS-BUILT


A1

MAIN FLOOR

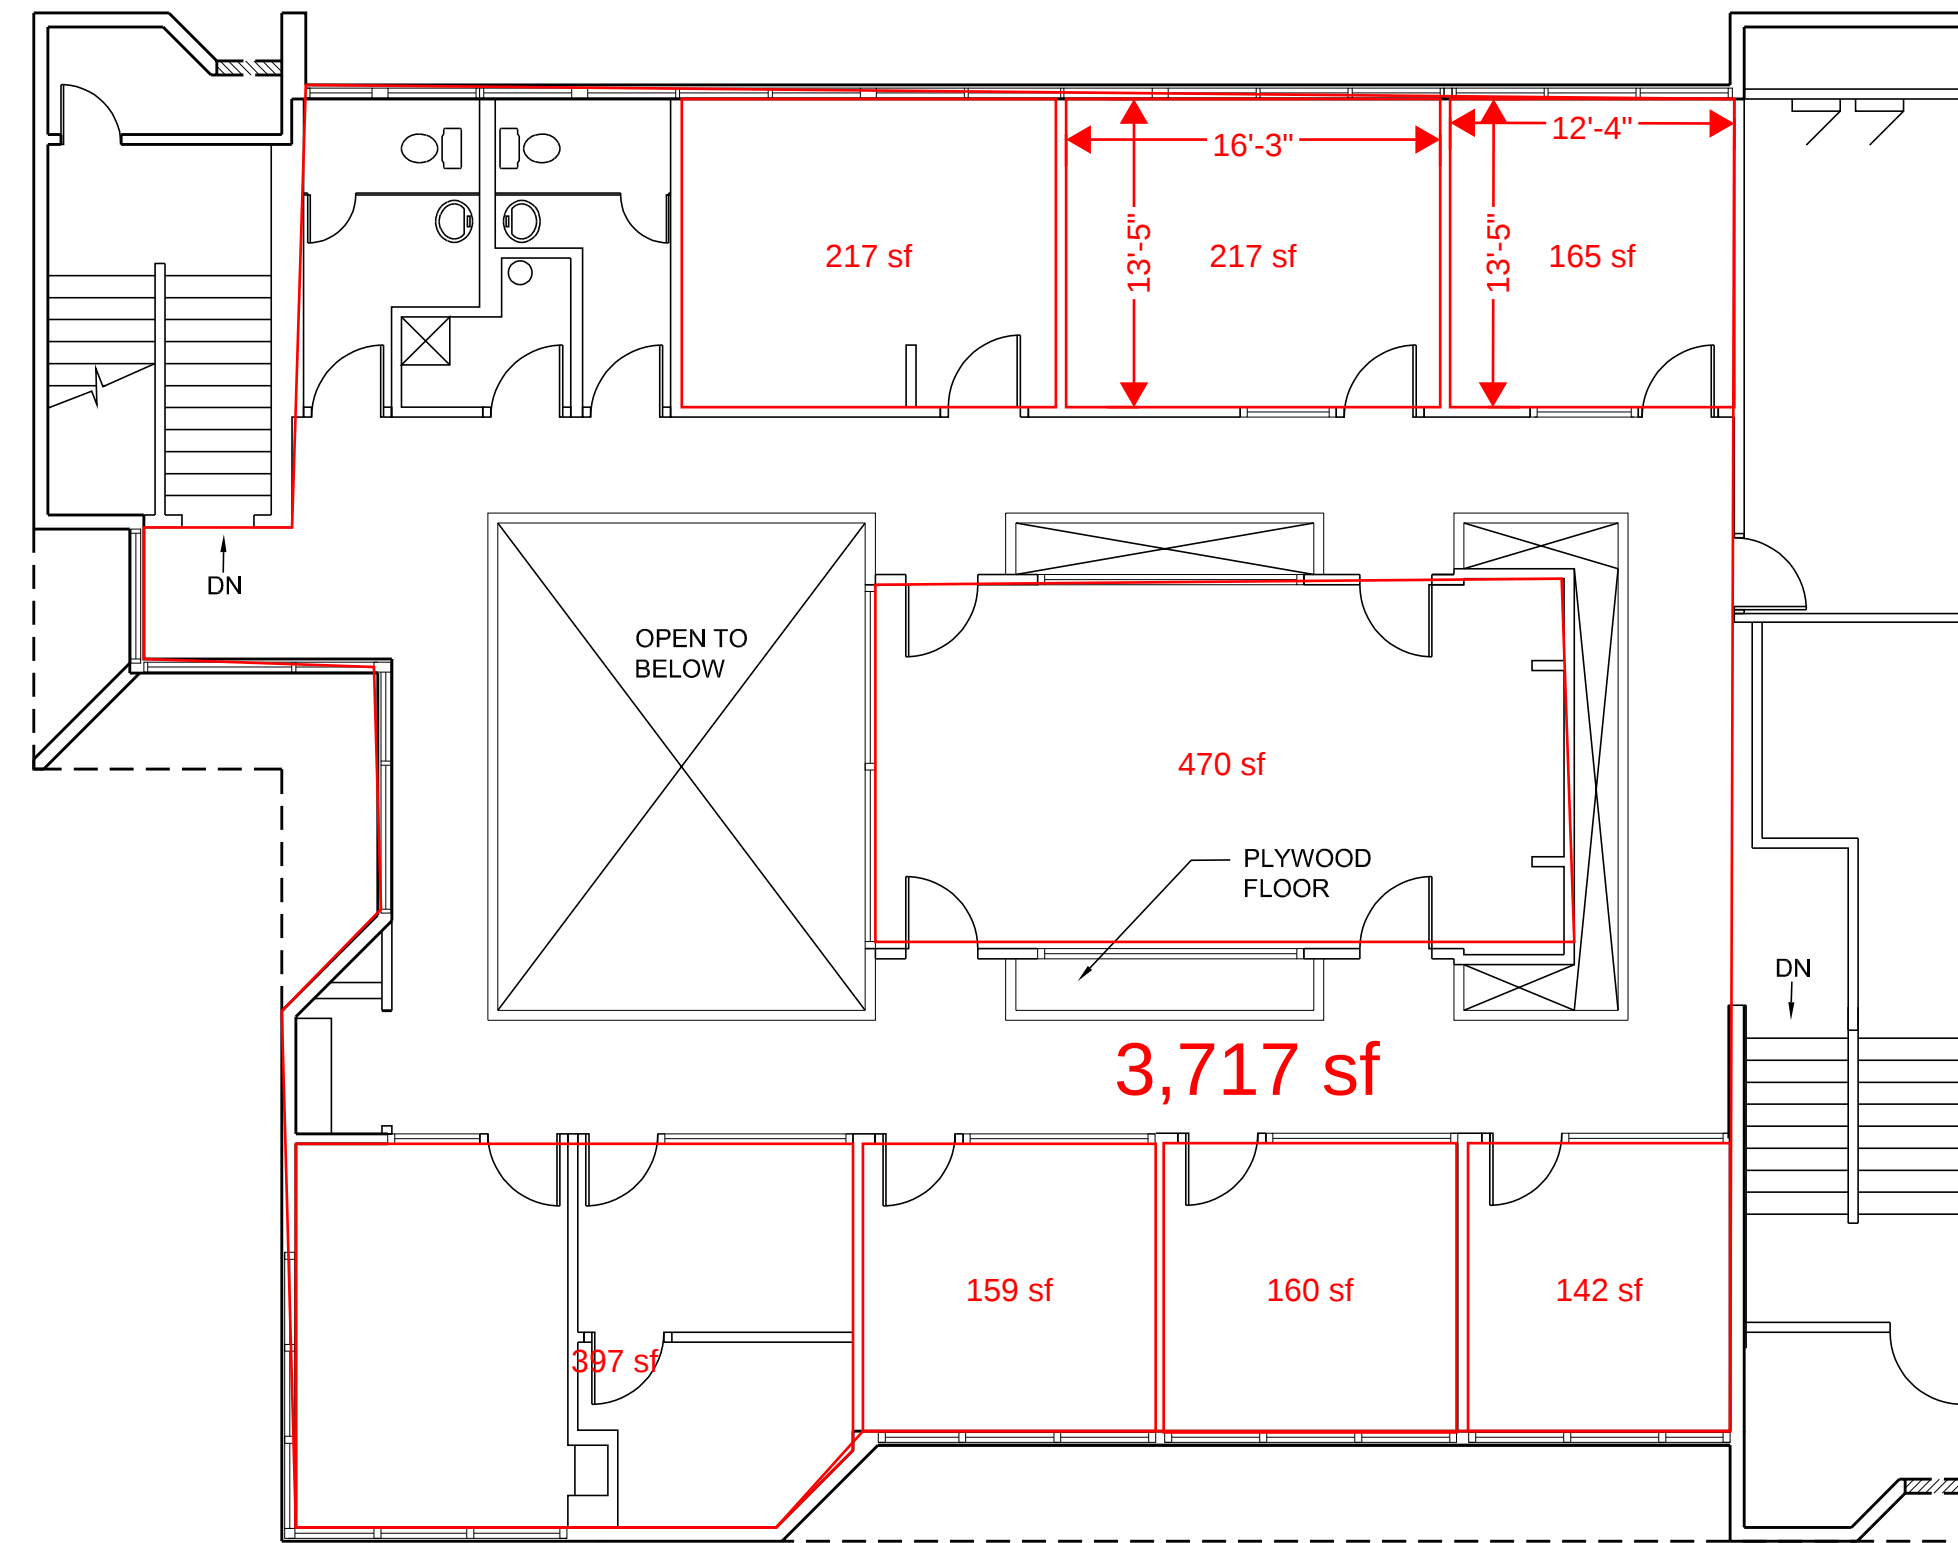[illegible]

2 SECOND FLOOR PLAN


SCALE: 1/8" = 1'-0"

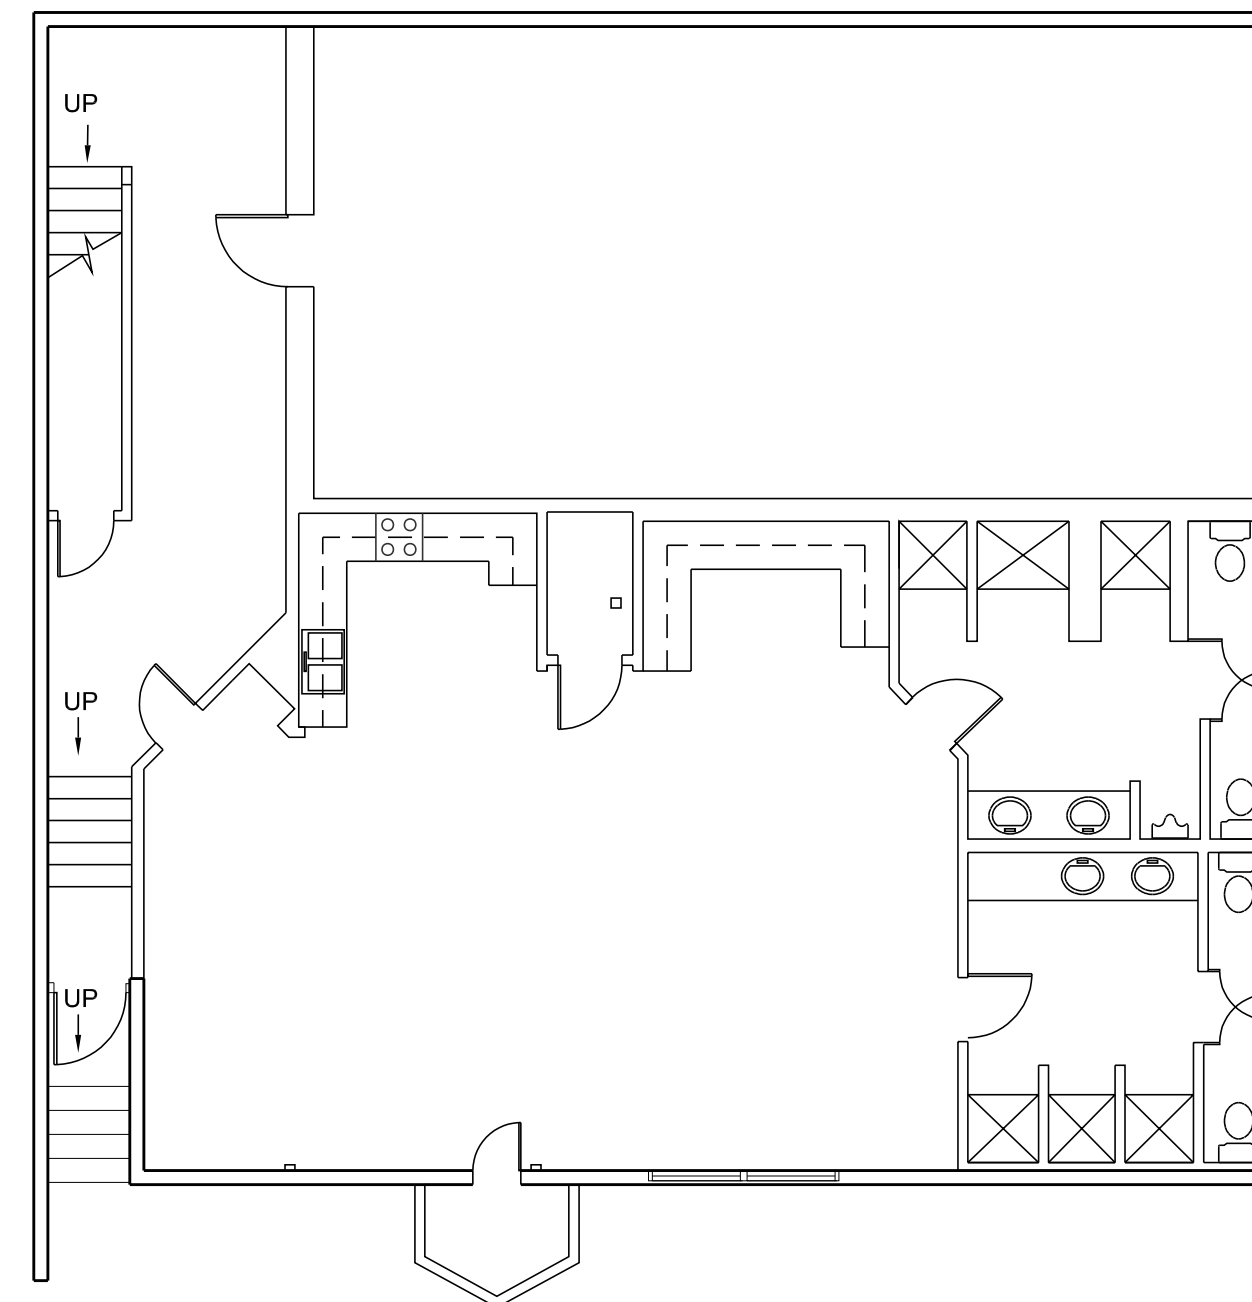

1 BASEMENT FLOOR PLAN

SCALE: 1/8" = 1'-0"

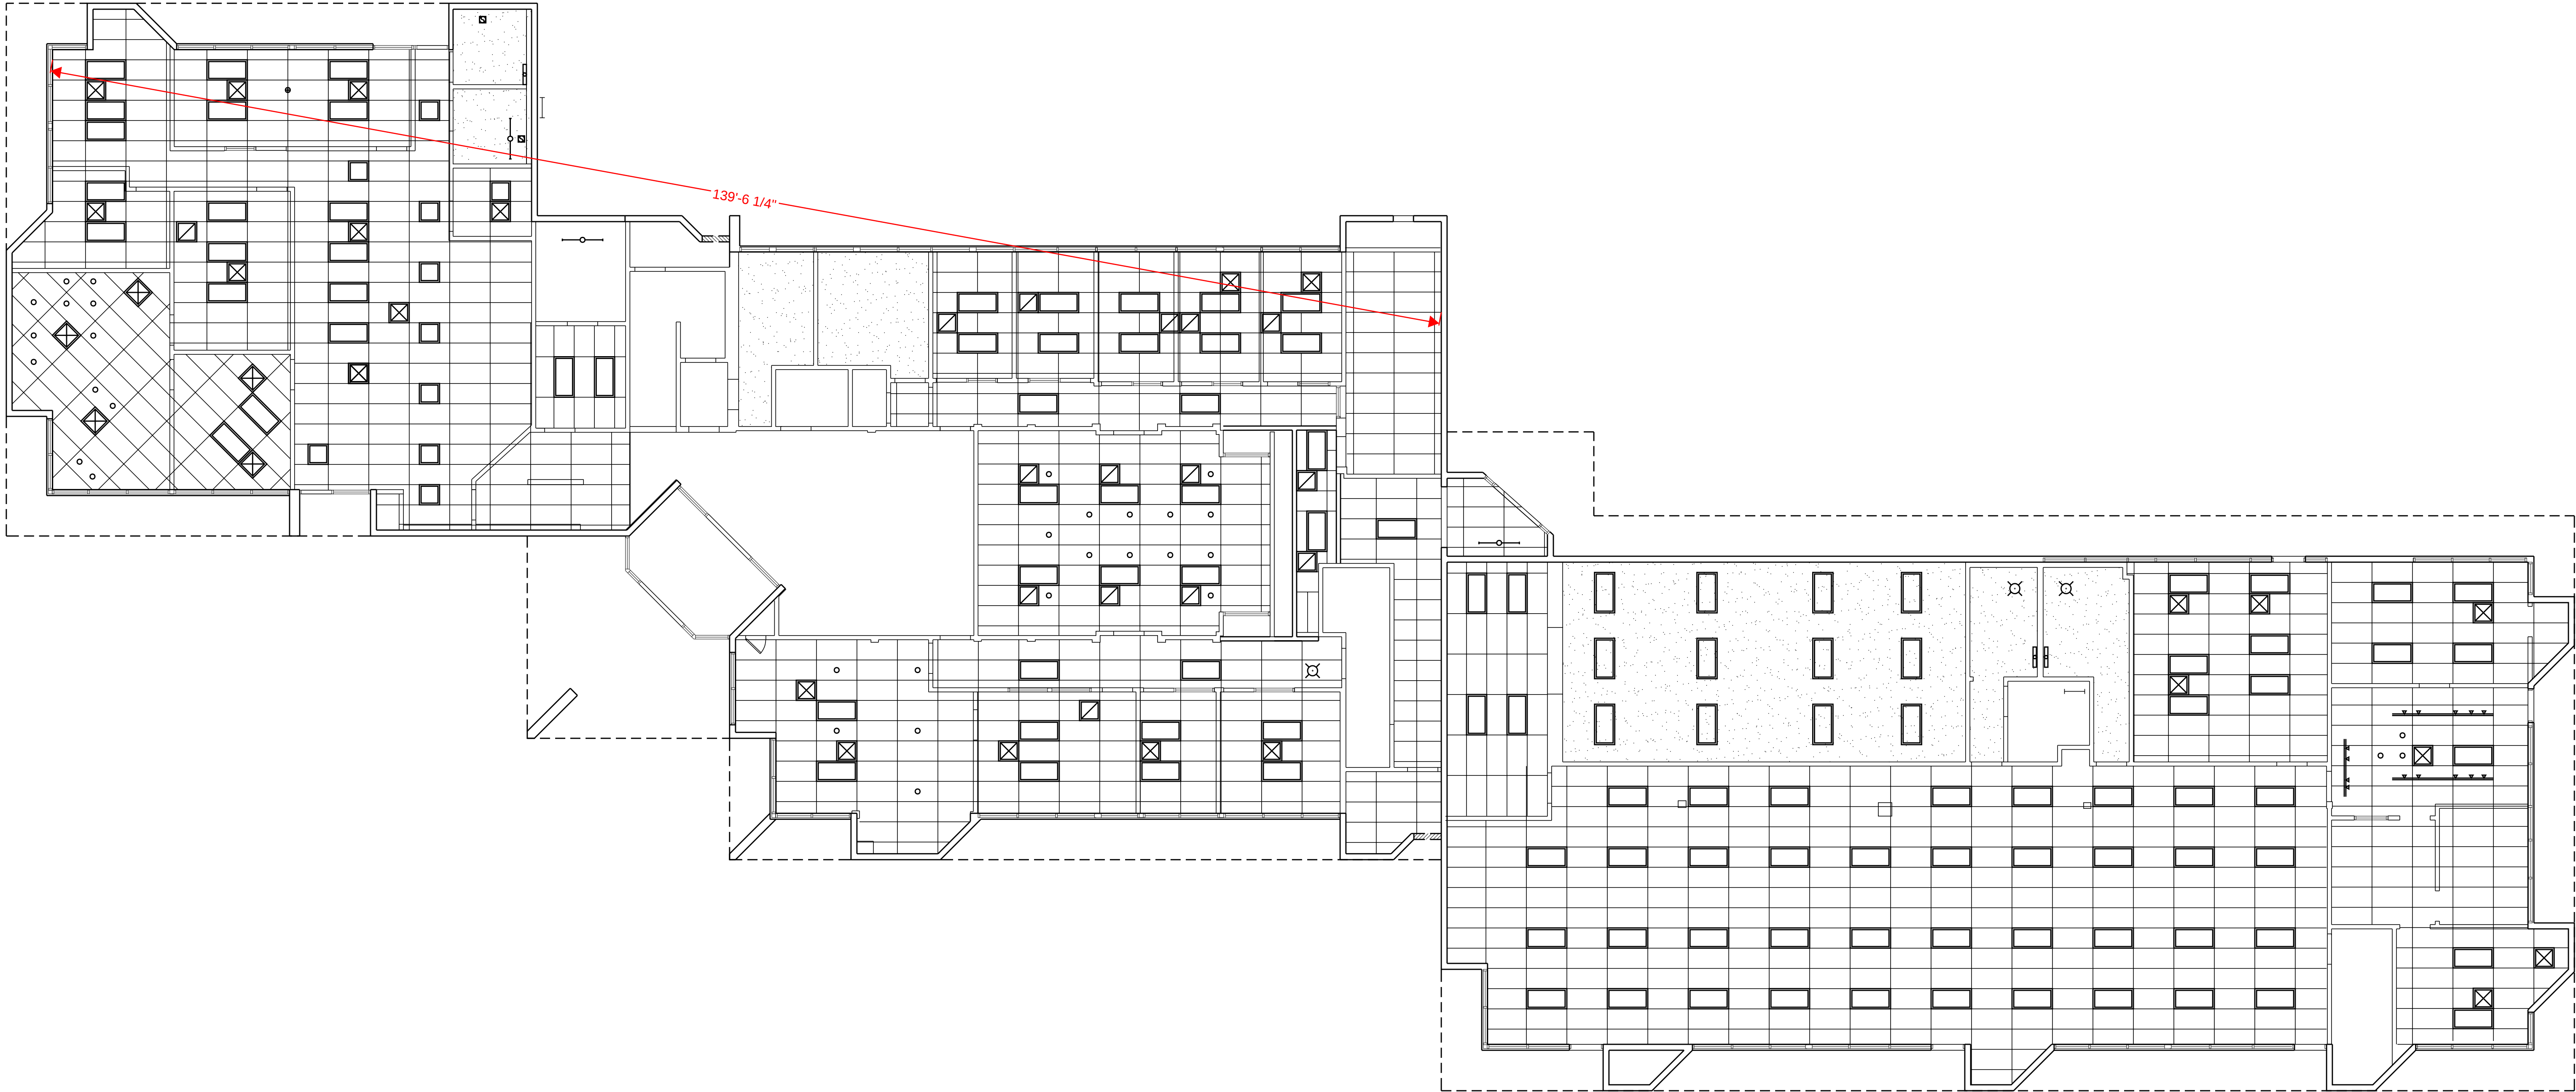


[illegible]

1 FIRST FLOOR REFLECTED CEILING PLAN


SCALE: 1/8" = 1'-0"

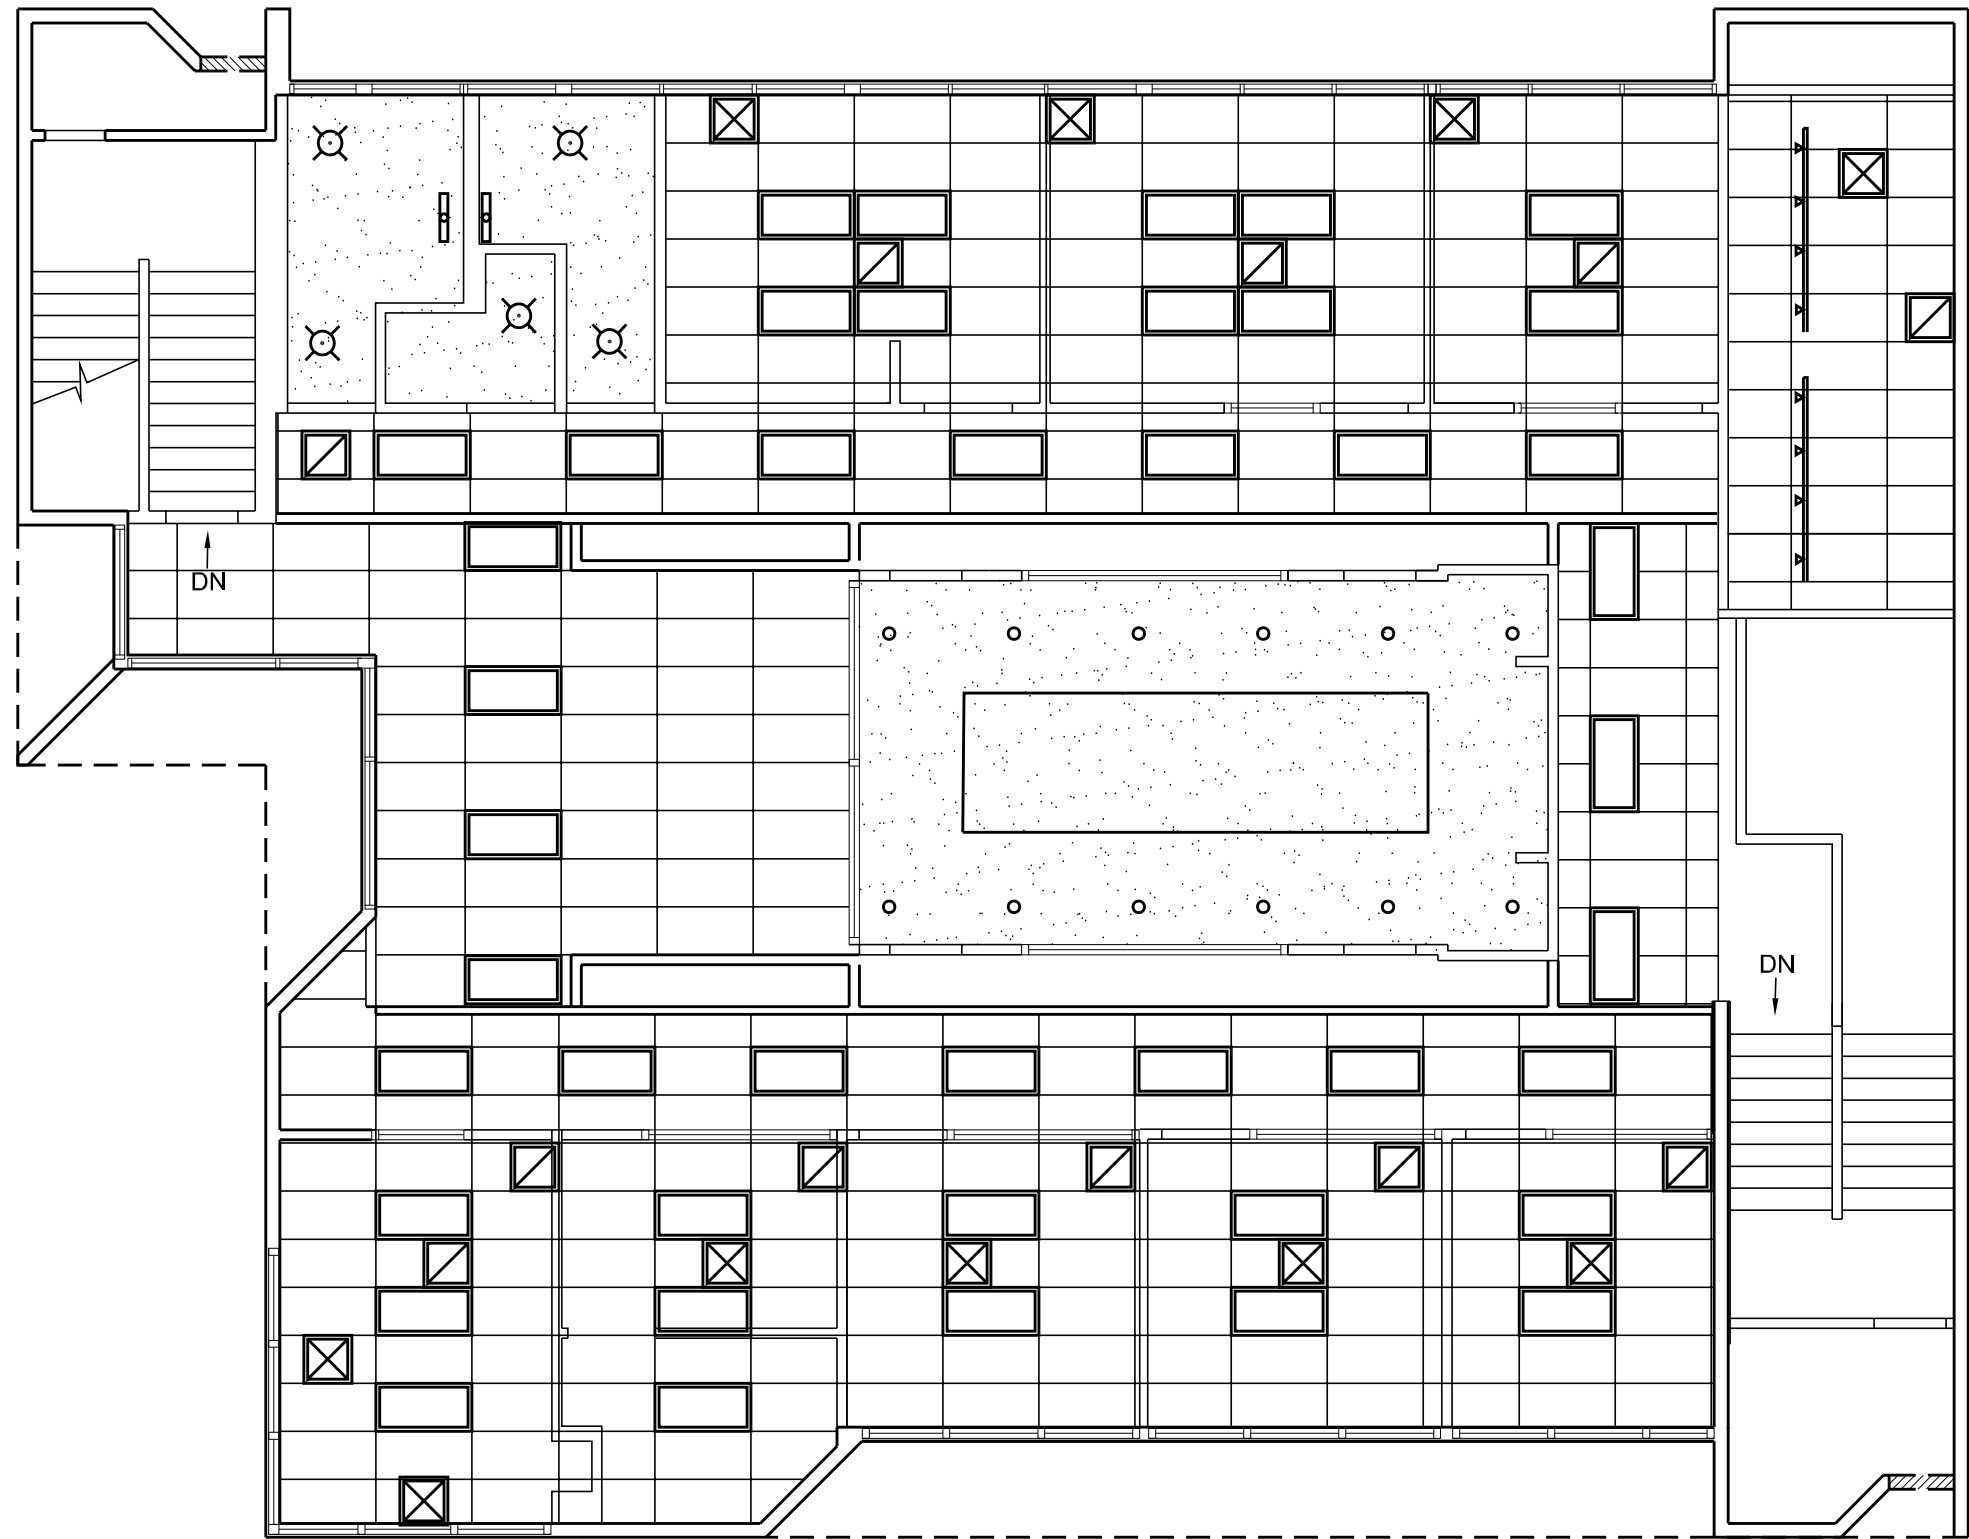

[illegible]

2 SECOND FLOOR REFLECTED CEILING PLAN

SCALE: 1/8" = 1'-0"

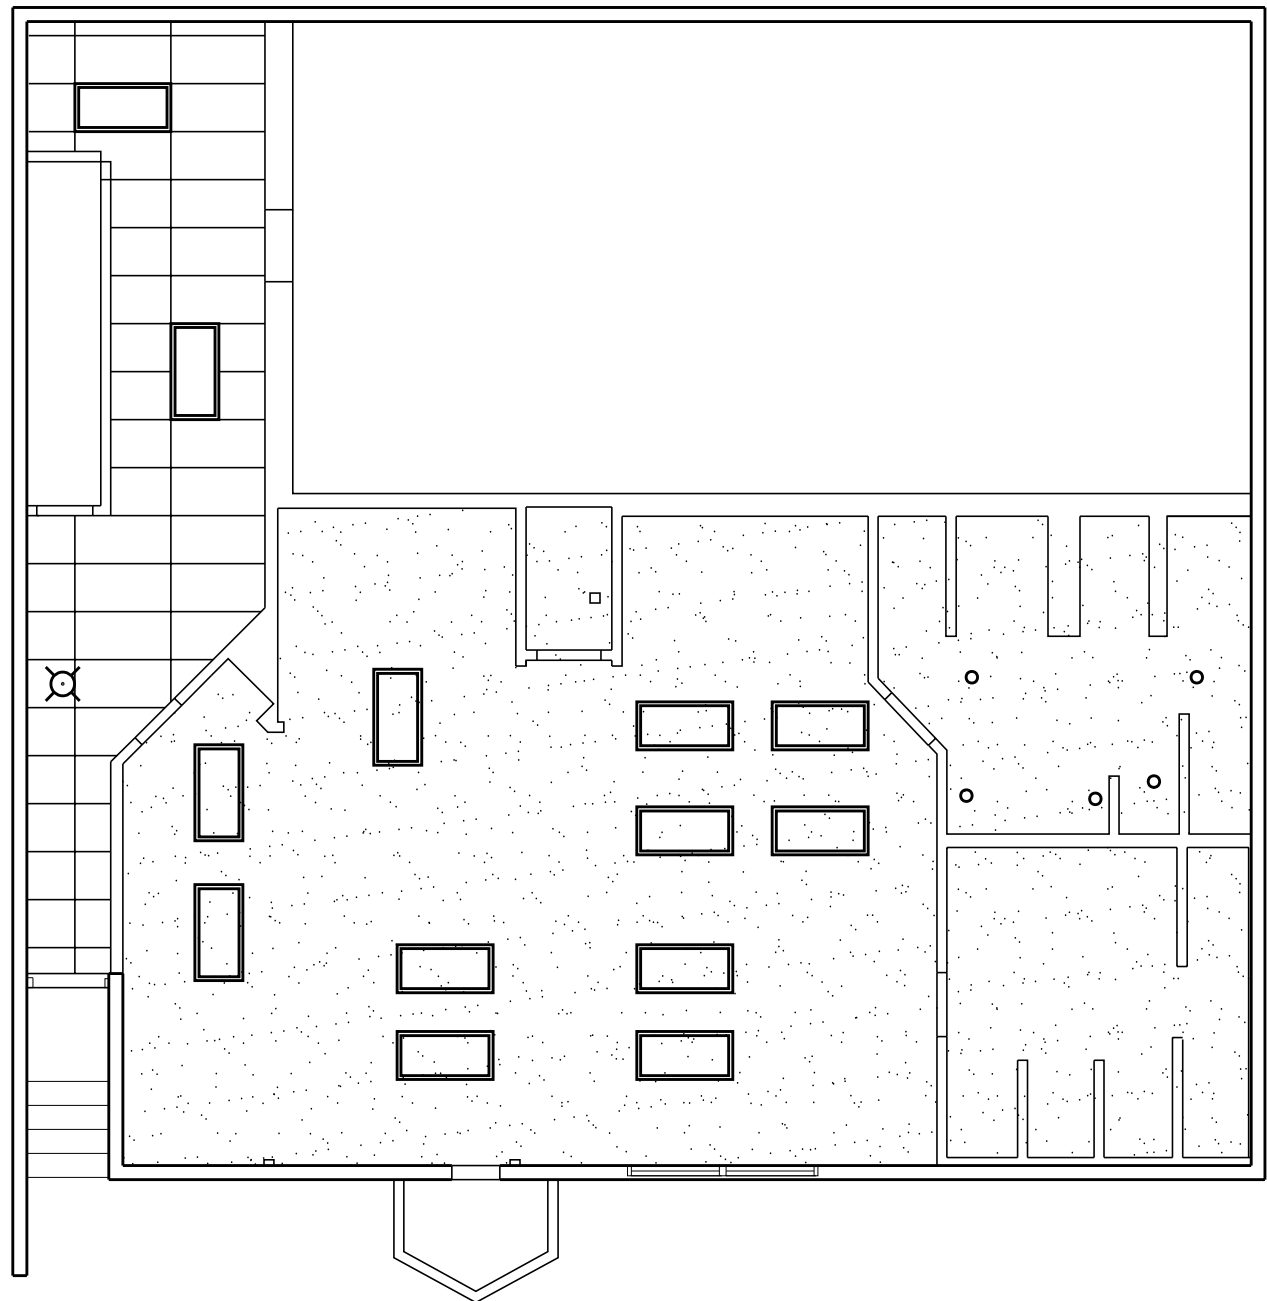

1 BASEMENT REFLECTED CEILING PLAN

SCALE: 1/8" = 1'-0"

