
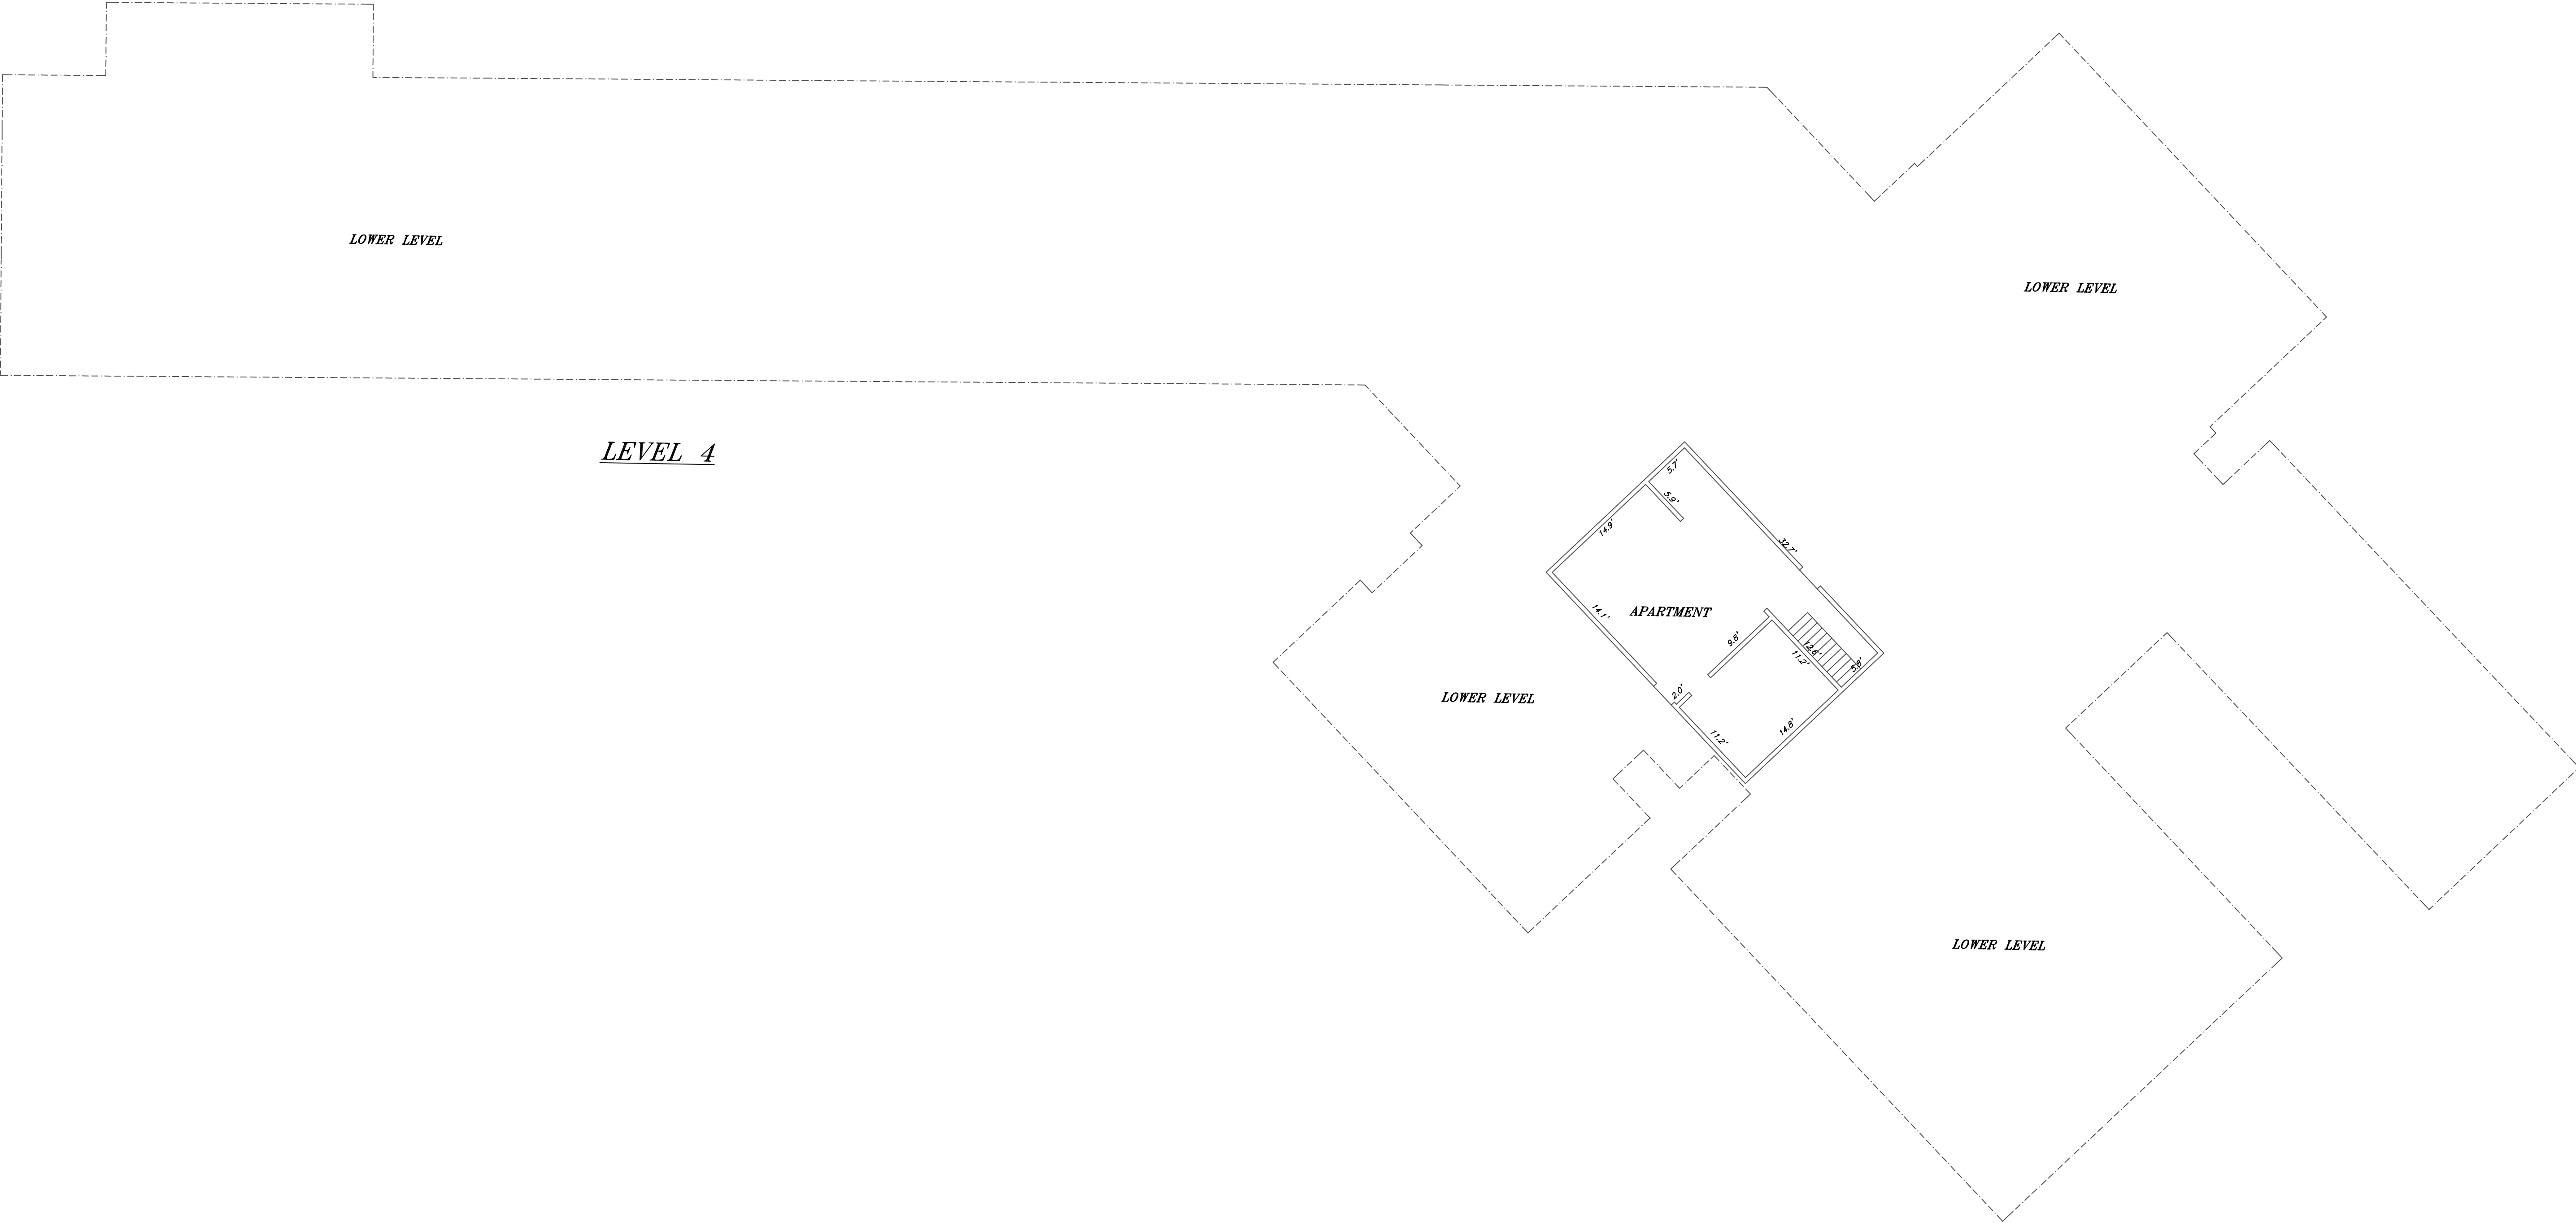


LODGE BY THE BLUE
UNIT ASBUILTS
SUMMIT COUNTY, COLORADO

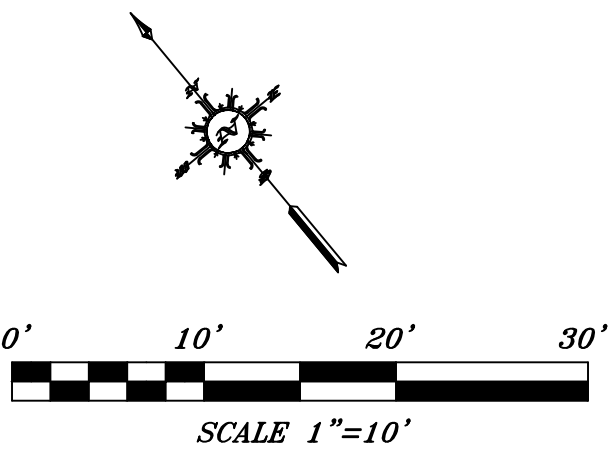

<i>Baseline Surveys LLC</i>		P.O.BOX 7578 13541 COLO.HWY #9 BRECKENRIDGE, CO 80424 (970) 453-7155	
<i>LODGE BY THE BLUE UNIT ASBUILTS SUMMIT COUNTY, COLORADO</i>			
<i>Date</i>	<i>Revisions</i>		
		<i>Date:</i> <i>6/26/2024</i>	<i>Scale Horiz:</i> <i>1" = 10'</i>
		<i>Drawn By:</i> <i>R.D.G.</i>	<i>Checked By:</i> <i>N.P.O.</i>
		<i>DWG File:</i> <i>4675 asb</i>	<i>Job File:</i> <i>4675</i>