


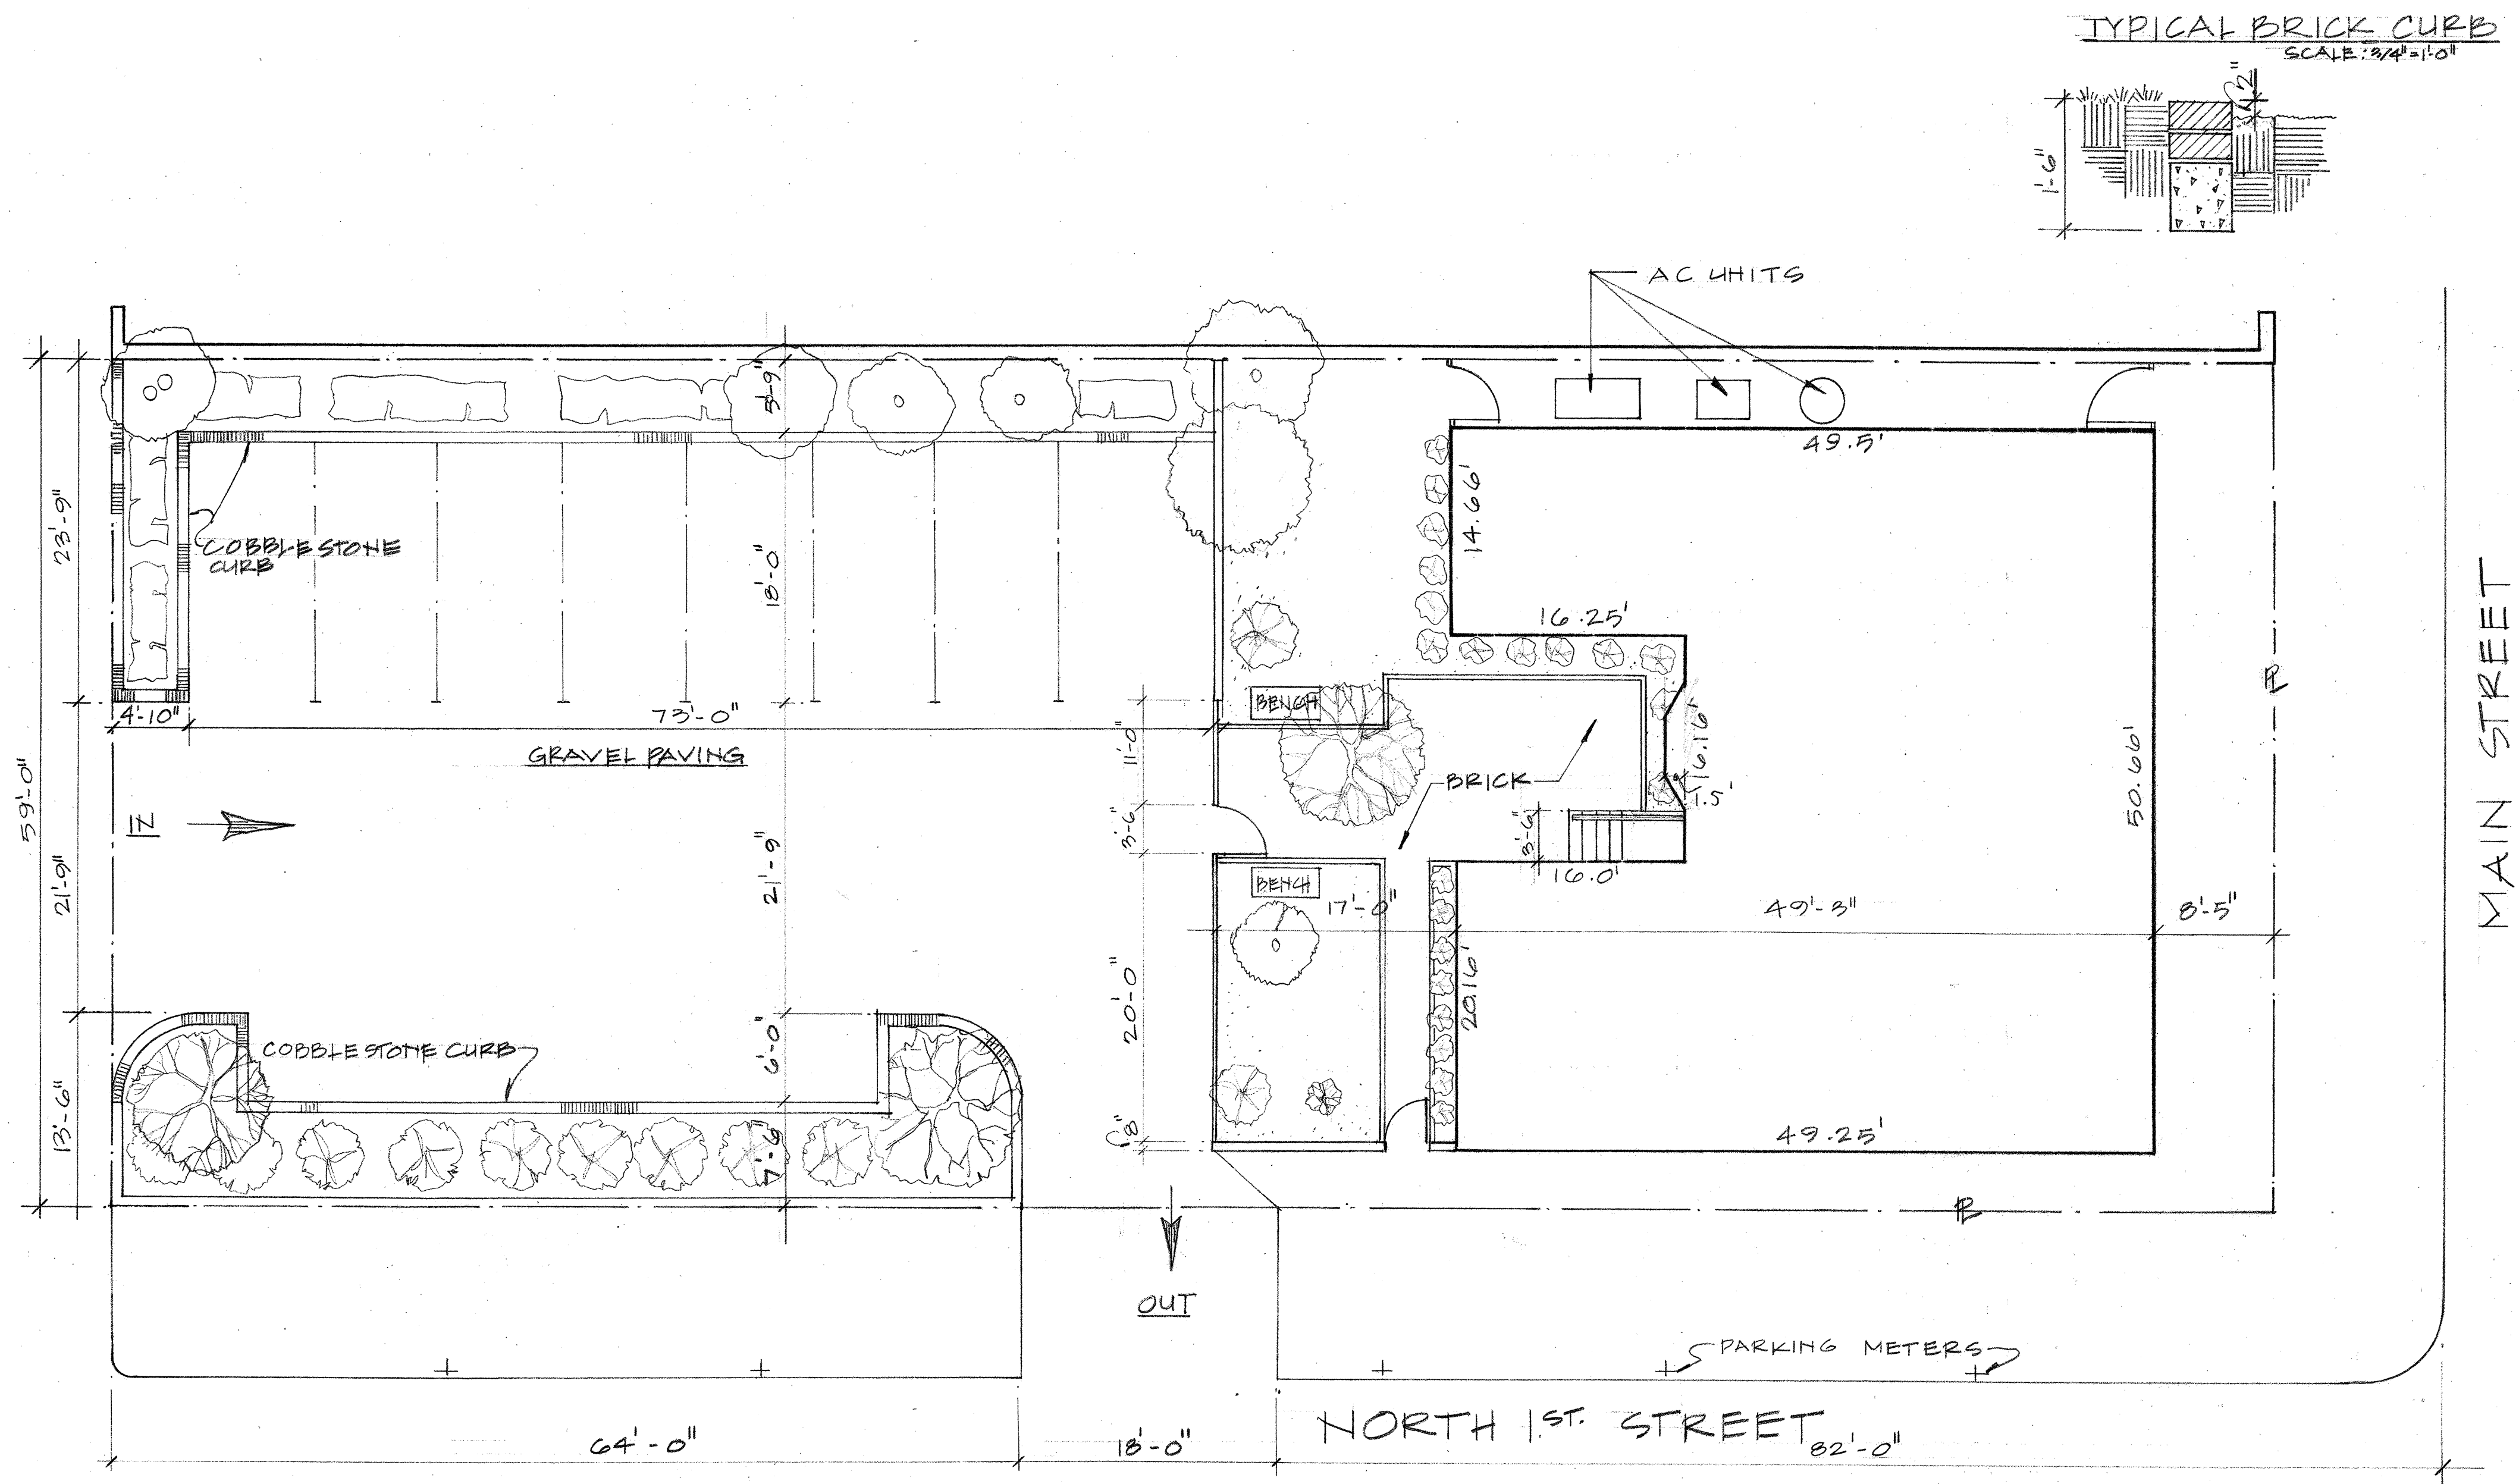

site plan/crozet house

SCALE: 1/8" = 1'-0"

as-built drawings

THE CROZET HOUSE

100 E. MAIN ST.
RICHMOND, VIRGINIA 23219

OWNER:
V. CASSEL ADAMSON, JR.
6510 THREE CHOPT RD.
RICHMOND, VA 23233

DATE: DECEMBER 1997

BAXTER BAILEY
& ASSOCIATES
ARCHITECTS
THE CROZET HOUSE • 100 E. MAIN STREET • RICHMOND, VA 23219
(804) 361-8033 • FAX (804) 775-2509