


BUILDING NUMBER	AREA (SQ. FT.)
BUSINESS SPACE	
842	925
844	214
846	706
850	236
860	214
862	519
864	439
RESIDENTIAL UNITS	
848	848-02 432
	848-03 476
850	850-03 629
	850-04 697
	850-05 699
	850-06 632
852	852-03 623
	852-04 693
	852-05 695
	854-06 614
854	854-03 639
	854-04 702
	854-05 699
	854-06 624
856	856-01 453
	856-02 438
	856-03 431

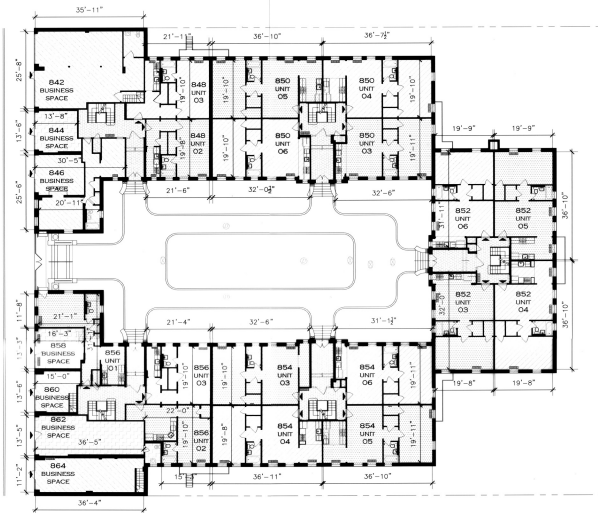

LEGEND:

-  Unit Area
-  Unit Area
-  Unit Exclusive Common Area
-  Unit Storage Area
-  Laundry Area
-  Business Area
-  Business Area

**842-864
MASSACHUSETTS AVE**

FLOOR LEVEL
FIRST FLOOR



**860 MASSACHUSETTS AVE.
CONDOMINIUM
842-864 MASSACHUSETTS AVE.
CAMBRIDGE, MASSACHUSETTS**

I CERTIFY THAT THIS PLAN, AS BUILT, AS OF THIS DATE, FULLY AND ACCURATELY DEPICTS THE UNIT BEING CONVEYED AND THE IMMEDIATELY ADJOINING UNITS, THE LAYOUT OF THE UNIT, ITS LOCATION, DIMENSIONS, APPROXIMATE AREA, MAIN ENTRANCE, AND IMMEDIATE COMMON AREA TO WHICH IT HAS ACCESS.

I CERTIFY THAT THESE PLANS ARE IN COMPLIANCE WITH THE RULES AND REGULATIONS OF THE REGISTRY OF DEEDS.



PREPARED BY:
BRIAN HEALY ARCHITECTS
51 MELCHER ST.
BOSTON, MASSACHUSETTS
02210

PLANNED 247 (417) BY P403
RECORDED 25524 PAGE 308

REGISTRY USE ONLY