

MEDICAL OFFICE FOR LEASE

1233 HIGHWAY 54, FAYETTEVILLE, GEORGIA 30214



SPACE DETAILS

- 1,462 RSF Medical Office Suite
- Breakroom and Private Restroom
- Highly Visible to Highway 54
- Adjacent to Piedmont Fayette Hospital
- Surrounded by numerous Medical and Retail Tenants
- 2.5 miles to Trilith Studios
- 29 Minutes to Hartsfield Jackson Int. Airport
- Current Furniture, Fixtures and Equipment can be purchased

THIS INFORMATION HAS BEEN SECURED FROM SOURCES WE DEEM RELIABLE, BUT WE MAKE NO REPRESENTATIONS OR WARRANTIES, EXPRESSED OR IMPLIED AS TO THE ACCURACY OF THE INFORMATION.

BARRY GARNER
VICE PRESIDENT
770-294-4027
bgarner@stcom.us

SEAN RAWSON VICE PRESIDENT 678-920-1222 srawson@stcom.us



STCOM.US




770-631-0499



AS-BUILT FLOOR PLAN

1233 HIGHWAY 54, FAYETTEVILLE, GA 30214

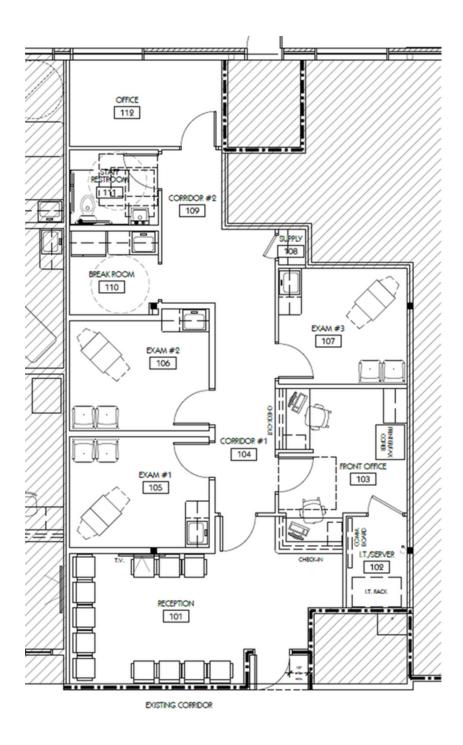













PROXIMITY MAP

1233 HIGHWAY 54, FAYETTEVILLE, GA 30214





BARRY GARNER VICE PRESIDENT 770-294-4027 bgarner@stcom.us SEAN RAWSON VICE PRESIDENT 678-920-1222 srawson@stcom.us







770-631-0499



201 PROSPECT PARK, SUITE A, PEACHTREE CITY, GA 30269