



SUITE 245
AS BUILT - 1 OF 1
5600 VANGUARD - LEVEL 2
590 RSF
SCALE: 1/8"=1'-0"
DATE: APRIL 11, 2019

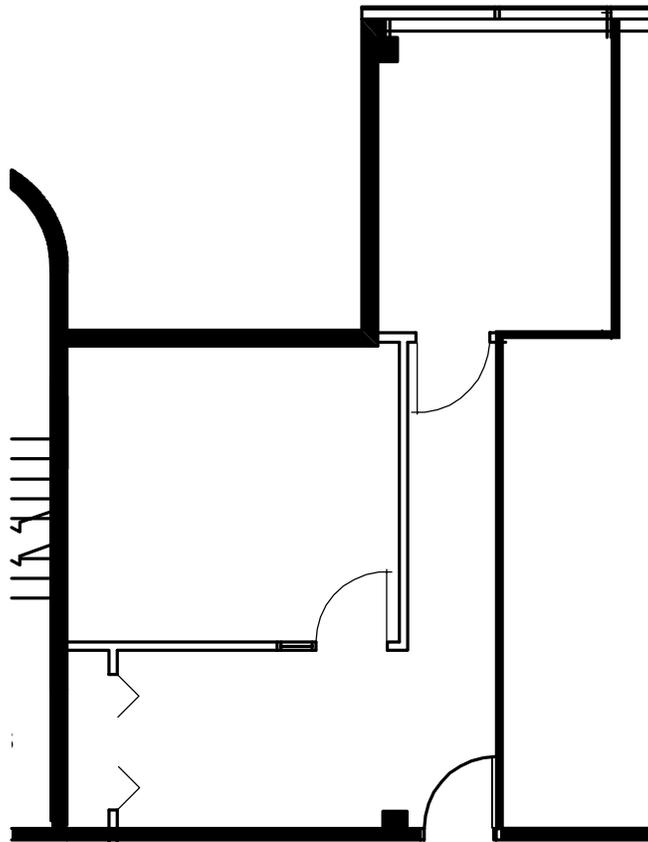

CBRE

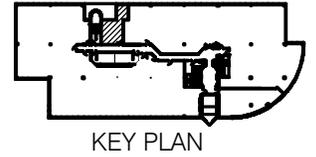