
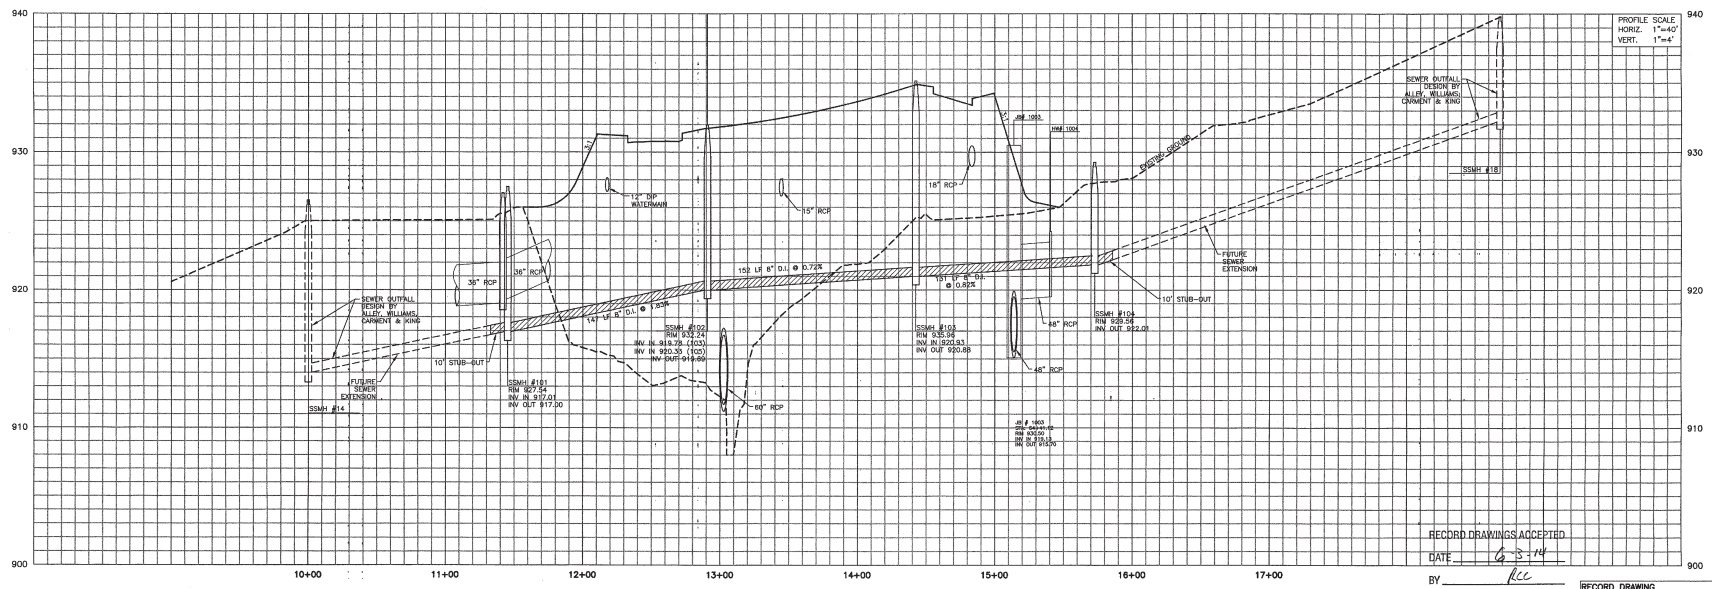


**NOTES**  
 1. SEE SHEET C-2.1 FOR NOTES RELATED TO SANITARY SEWER

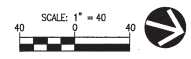

RECORD DRAWINGS ACCEPTED  
 DATE 6-3-14  
 BY *RC*

**RECORD DRAWINGS**  
 DATE: 5/5/14  
 BY: *J. J. Neel*

**ENGINEER'S STATEMENT**  
 I, J. Neel Carter, P.E., a Professional Engineer, duly registered in the State of North Carolina, hereby state, based upon review of the records herein, that to the best of my knowledge, information, and belief, all public and private infrastructures required for the construction of the project herein have been installed in general conformance with the approved plans and current City and State standards and are ready to be placed into service.  
 Signature: *J. Neel Carter* Date: 5/5/14  
 Registration Number: 14285

**RECORD DRAWING**  
 NOT A CERTIFIED DOCUMENT AS TO THE ORIGINAL DOCUMENT SET ONLY AS TO THE DRAWING. SANITARY SEWER AND WATER INFRASTRUCTURE DOCUMENT ORIGINALLY DESIGNED AND SCALED BY J. NEEL CARTER, P.E. #14880, ON 8/22/2010. THIS DOCUMENT IS ONLY CERTIFIED AS TO THE DRAWING. SANITARY SEWER AND WATER INFRASTRUCTURE.  
 The herein Engineer has performed PERIODIC CONSTRUCTION OBSERVATION AND HAS NOT FIELD VERIFIED THE INFORMATION PROVIDED BY OTHERS AND MAKES NO REPRESENTATION WHATSOEVER AS TO ITS ACCURACY.  
 RECORD INFORMATION PROVIDED BY: REGIONAL LAND SURVEYORS, INC. 1642 W. MARKET STREET, SUITE 100 GREENSBORO, NC 27409 PHONE: 336-862-8156

**Stimmel**  
**Stimmel Associates, PA**  
 Landscape Architecture  
 Civil Engineering  
 Land Planning  
 601 N. Trade Street, Suite 200  
 Winston-Salem, NC 27103-2818  
 P: 336.723.1007 F: 336.723.1009  
 SEALS:



PROJECT:

**KERNERSVILLE MEDICAL PARKWAY  
 PHASE II**  
 To Serve Kernersville MEDICAL CENTER  
 Kernersville, North Carolina

CLIENT:  
 Trade Street Development Corp.  
 607 N. Trade Street  
 Winston-Salem, NC 27101  
 (336) 931-9377

DRAWN: *DKI, TEM*  
 DATE: 5/24/12  
 REVISIONS:  
 05/21/12 FOR REVIEW COMMENTS  
 05/14/12 RECORD DRAWINGS  
 05/14/12 RECORD DRAWING REVISION

JOB NO.: 08-002  
 SHEET TITLE:  
**SEWER OUTFALL  
 STA 10+00 -  
 STA 18+68**

SCALE: AS SHOWN  
**C-4.13**  
 © STIMMEL ASSOCIATES, P.A.

No warranty or representation (express or implied) is made as to the accuracy or completeness of the information set forth herein. All information is submitted subject to errors, omissions, change of price, prior lease or sale, and withdrawal without notice. All marketing material produced by the Meridian Realty Group is proprietary. Any reproduction is expressly prohibited.

**Kernersville Medical  
 Parkway At Brookford Rd**



**Sewer Map**