




SHELTER ARCHITECTURE
 MN 612.870.4081
 WI 715.495.0623
 shelterarchitecture.com

HUGE Theater
 Birch Roy
 2728 Lyndale Ave. S.
 Minneapolis, MN 55408
 project no.22029


ISSUES
 NO. DESCR. DATE

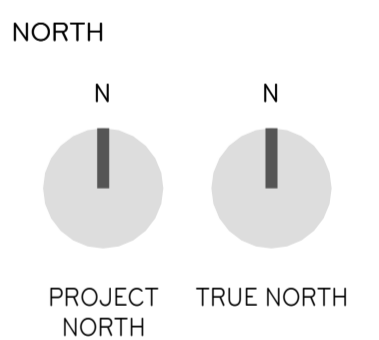

DRAWN BY SL
 CHECKED BY KG
 DATE 03/27/24

AS-BUILT PLAN

AB1.0

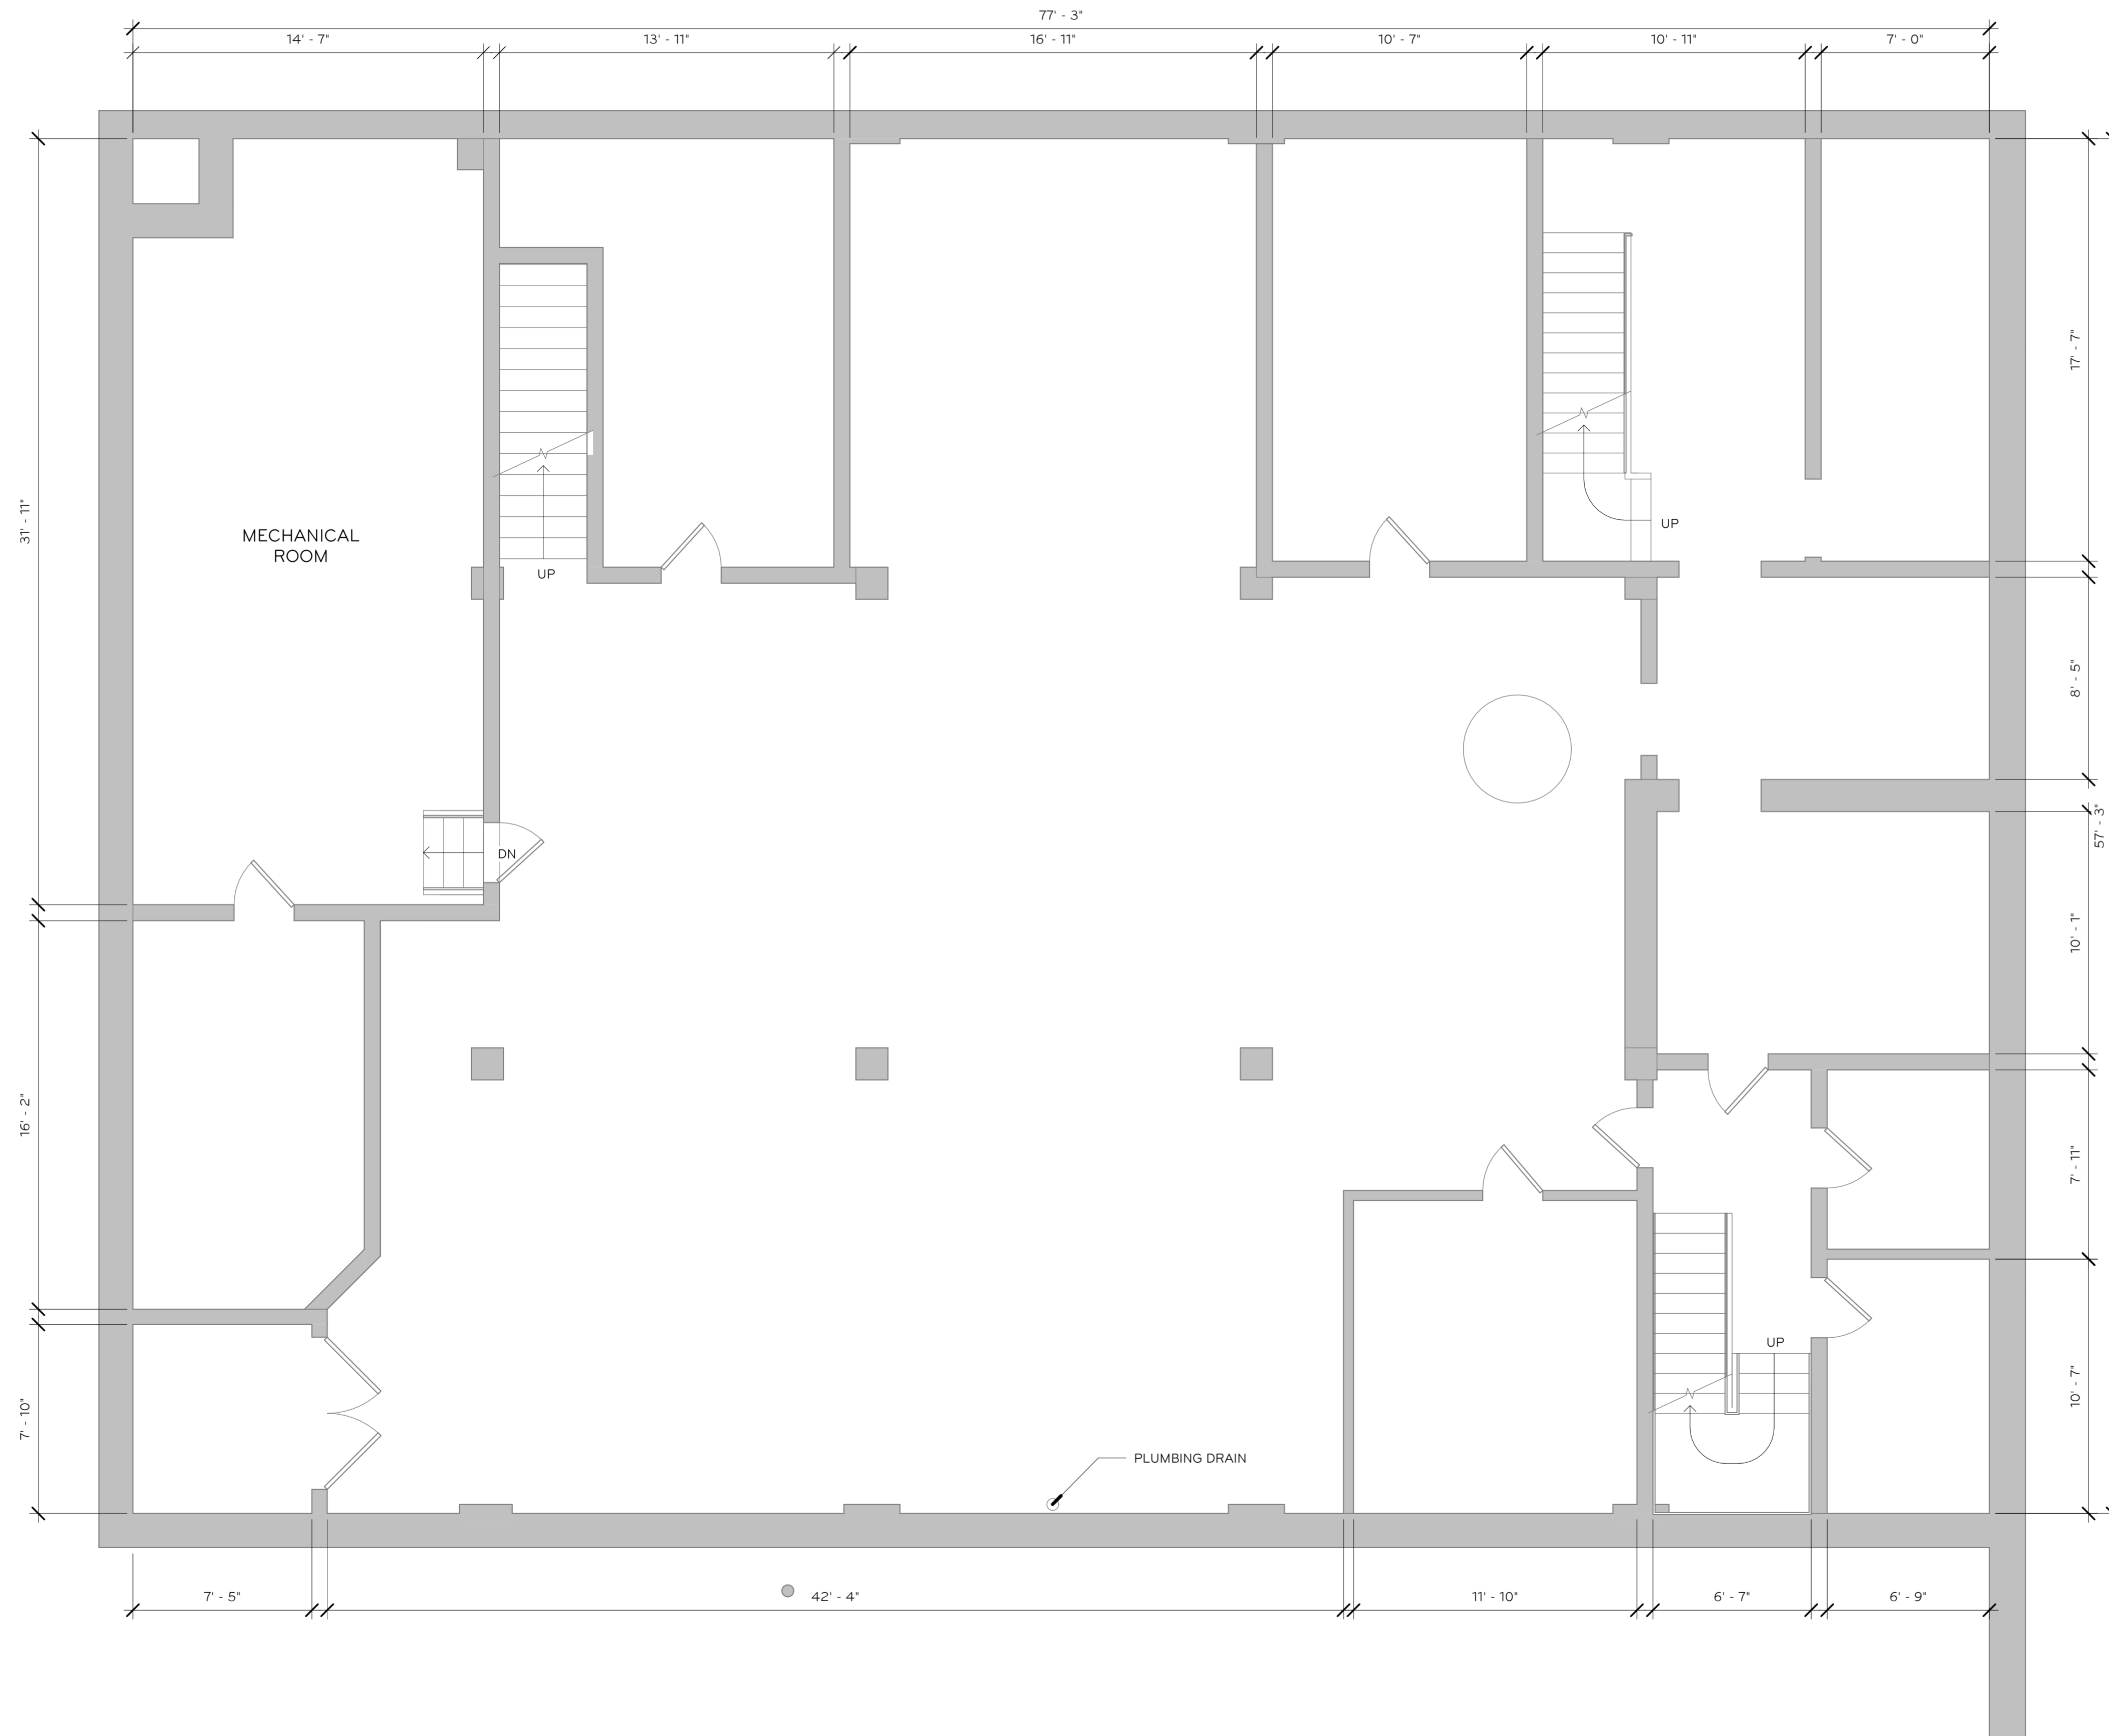

1 Lower Level - As-Built Plan
 1/4" = 1'-0"

NOT FOR CONSTRUCTION




SHELTER ARCHITECTURE
 MN 612.870.4081
 WI 715.495.0623
 shelterarchitecture.com

project no.22029

HUGE Theater
 Birch Roy
 2728 Lyndale Ave. S.
 Minneapolis, MN 55408


ISSUES
 NO. DESCR. DATE

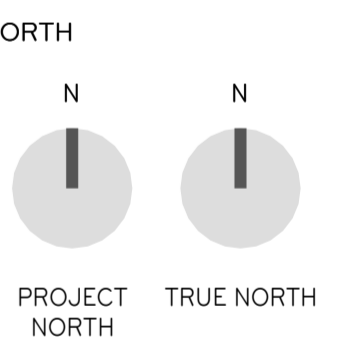

DRAWN BY SL
 CHECKED BY KG
 DATE 03/27/24

AS-BUILT PLAN

AB1.2

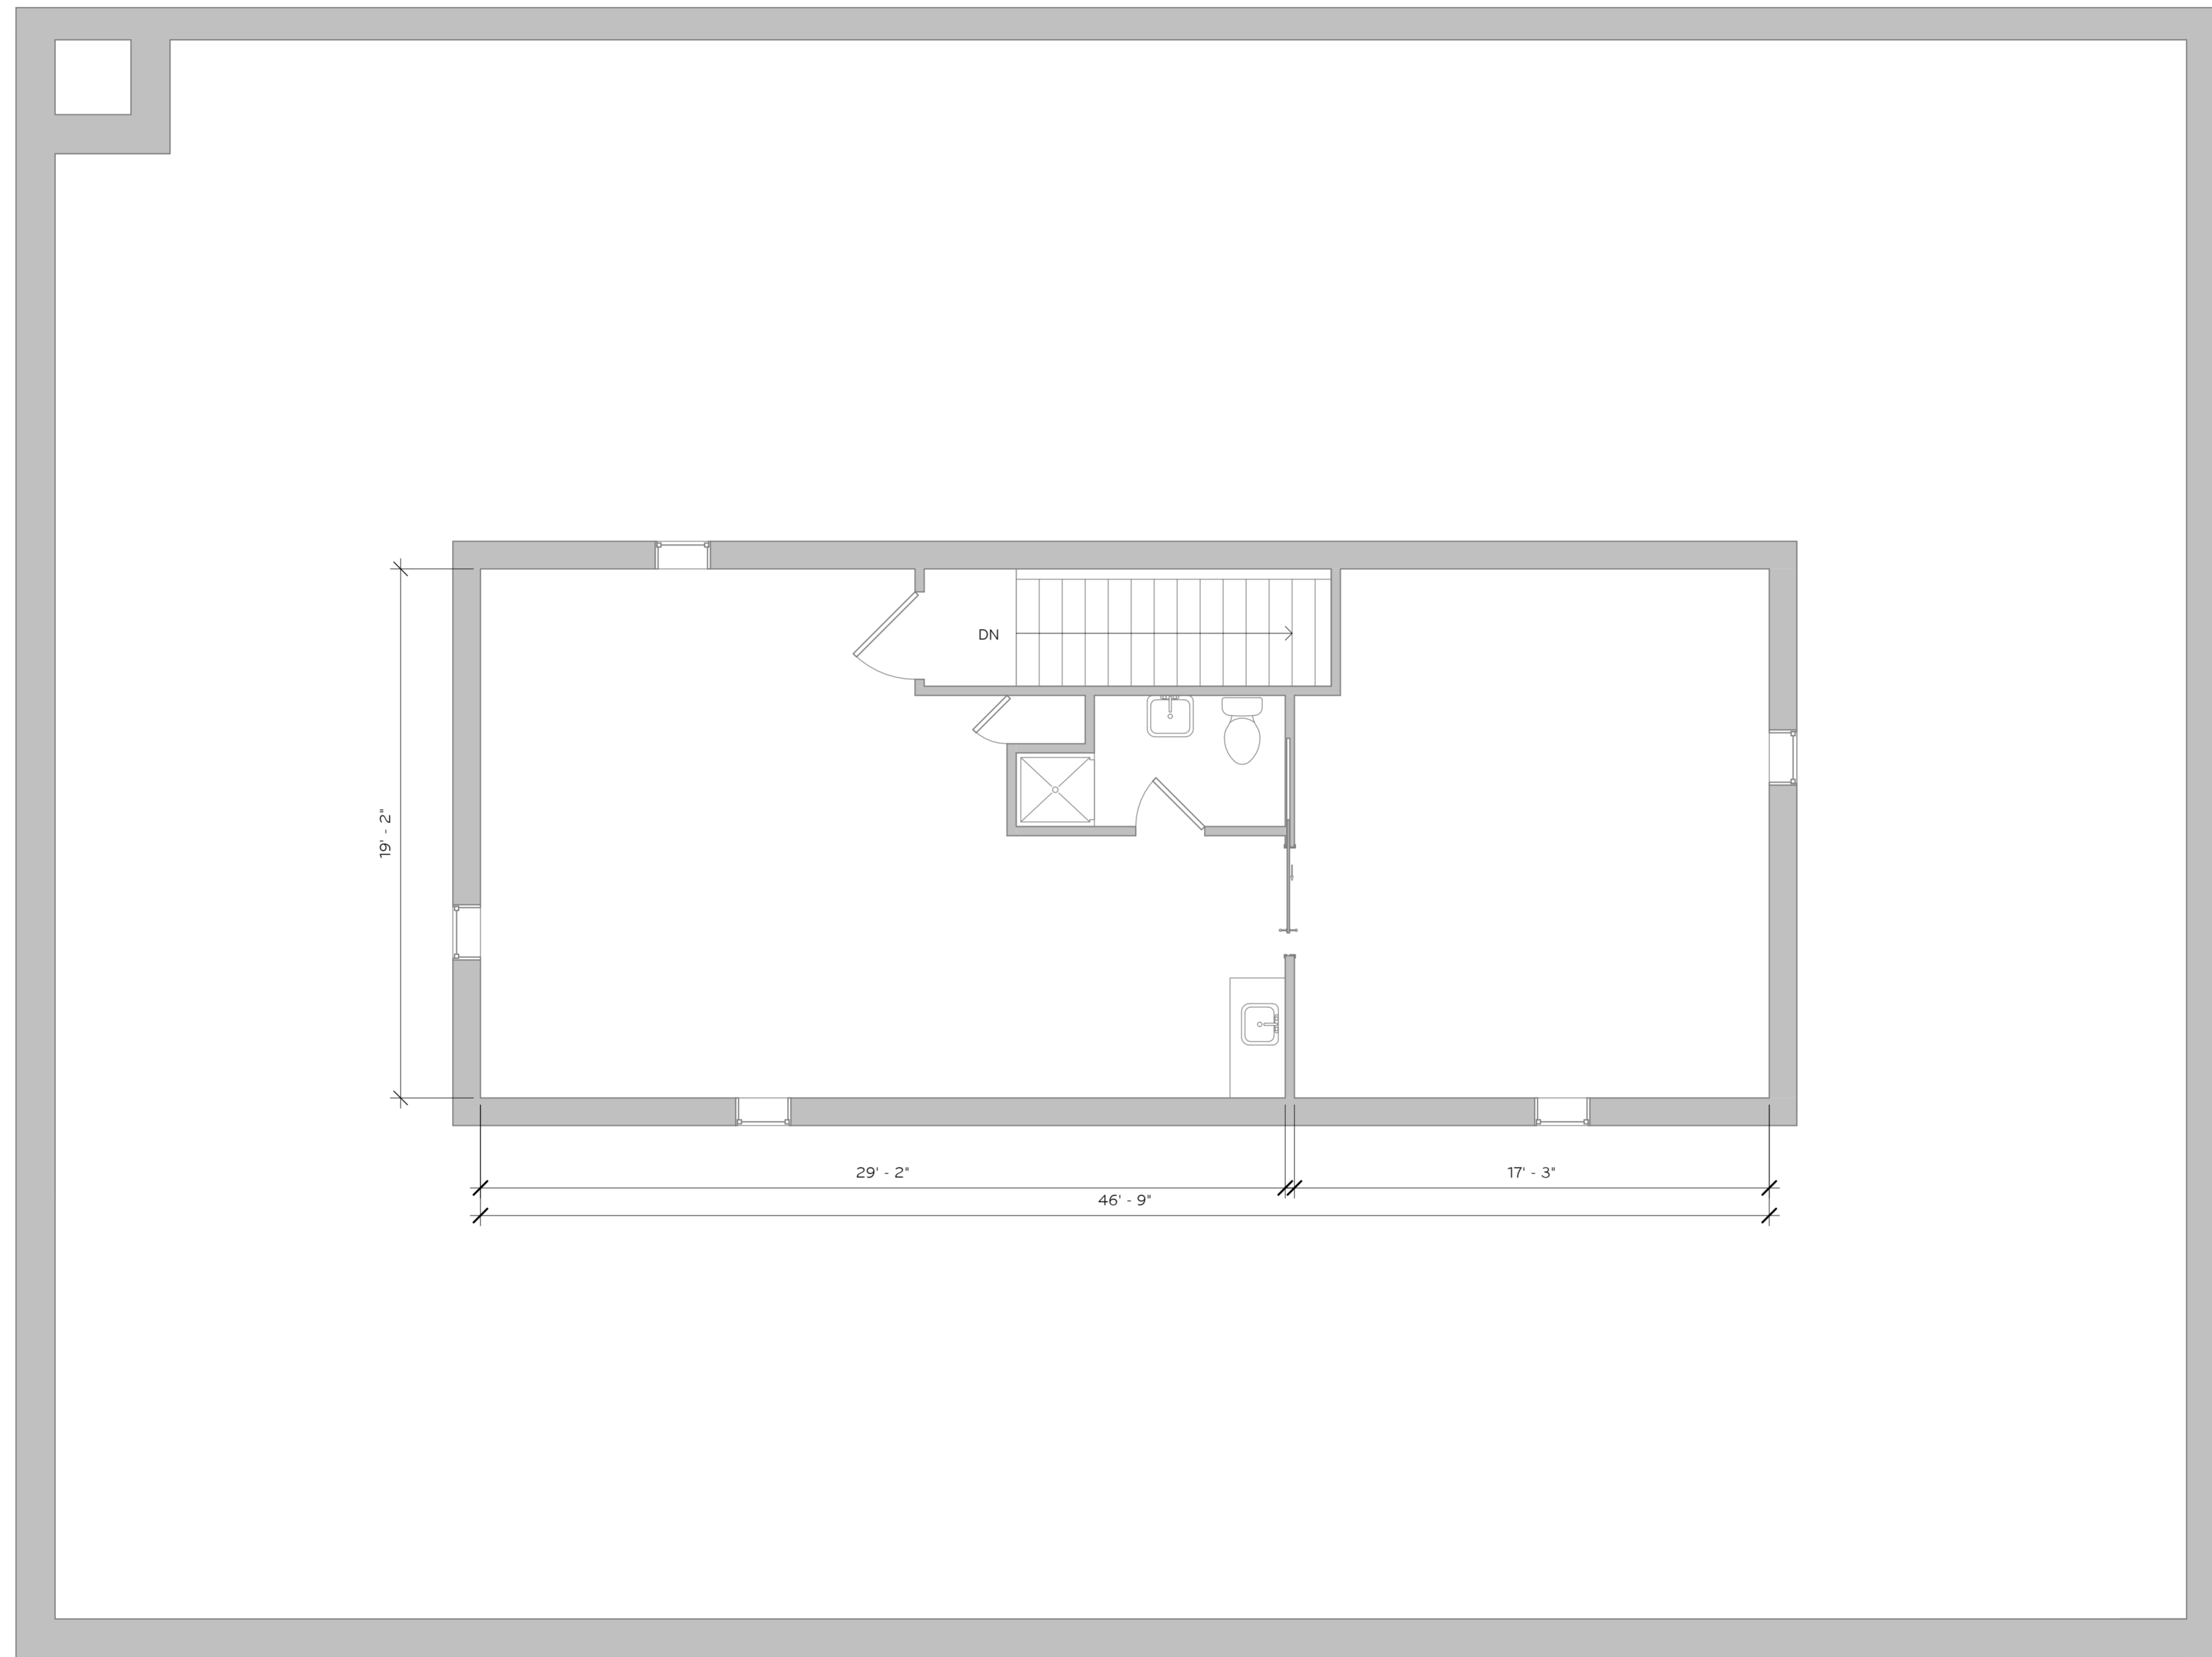

1 Upper Level - As-Built Plan
 1/4" = 1'-0"

NOT FOR CONSTRUCTION

These documents are instruments of service and do not constitute the property of SHELTER ARCHITECTURE. Use or publication requires written approval from SHELTER ARCHITECTURE.