


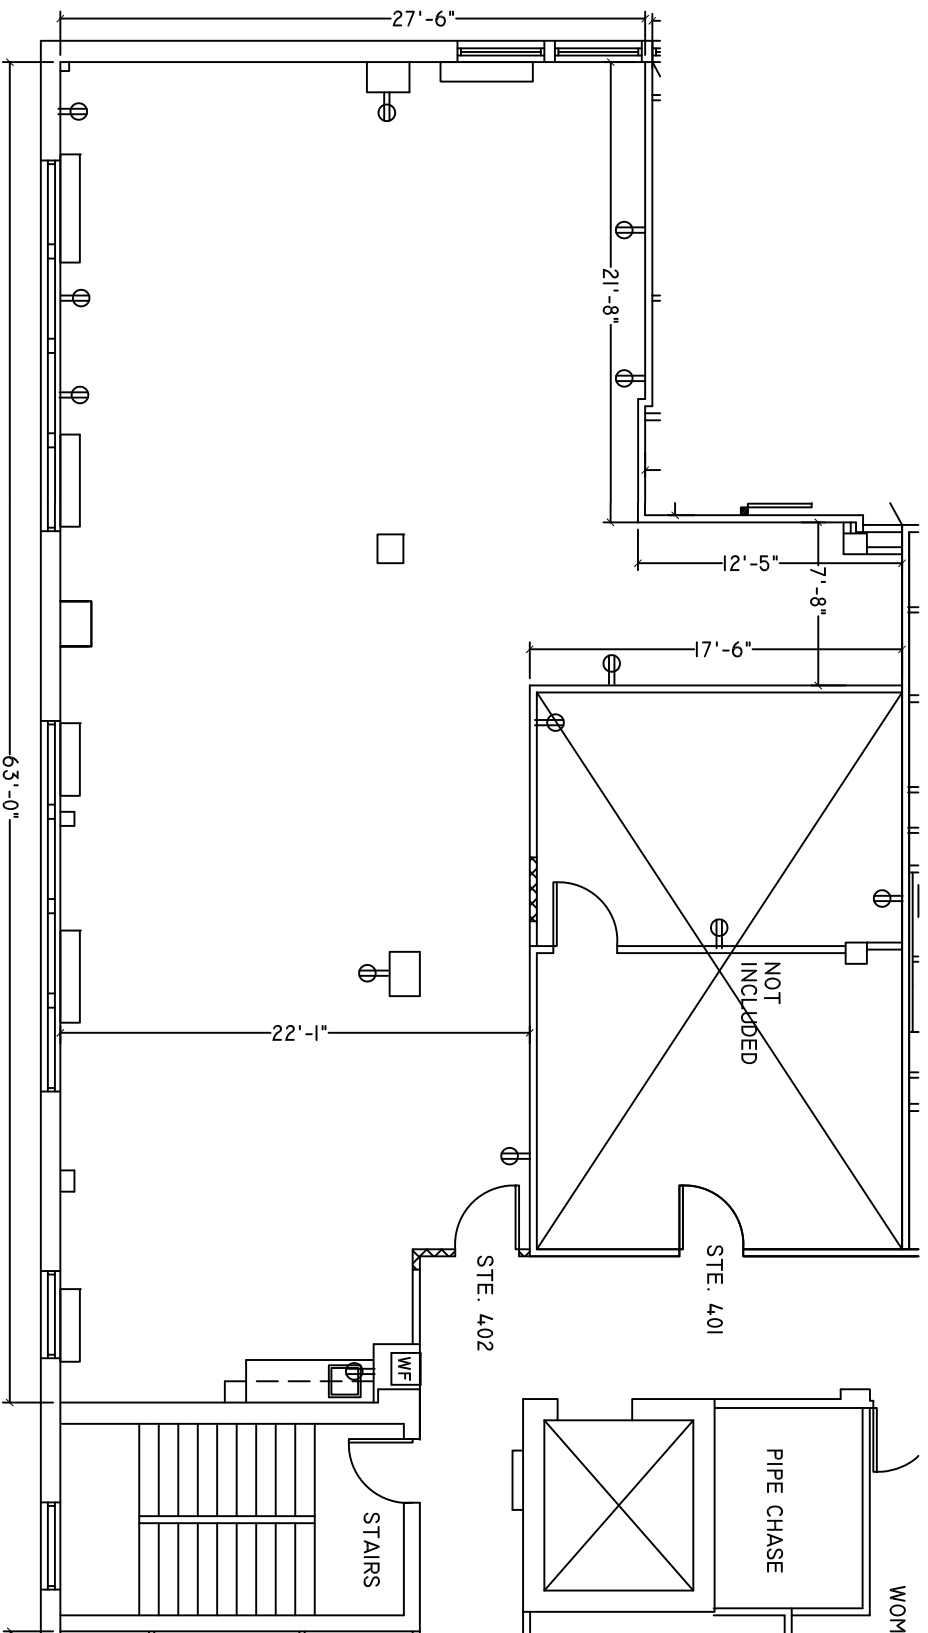

AS-BUILT

SHELL BUILDING
200 E. JOPPA ROAD
TOWSON, MD
SUITE 402 = 1,803 RENTABLE SQ.FT.

SCALE: N.T.S.
DATE: 4/7/09
REVISED:



Hill Management Services, Inc.
9640 Deeteco Road
Timonium, Maryland 21093
(410) 666-1000
www.hillmgt.com