




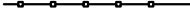


3920 CONDE STREET

INTERIOR RENOVATION

LEGEND


- (E) WOOD FENCE 
- (E) PERMEABLE LANDSCAPE 
- (E) IMPERVIOUS HARDSCAPE 

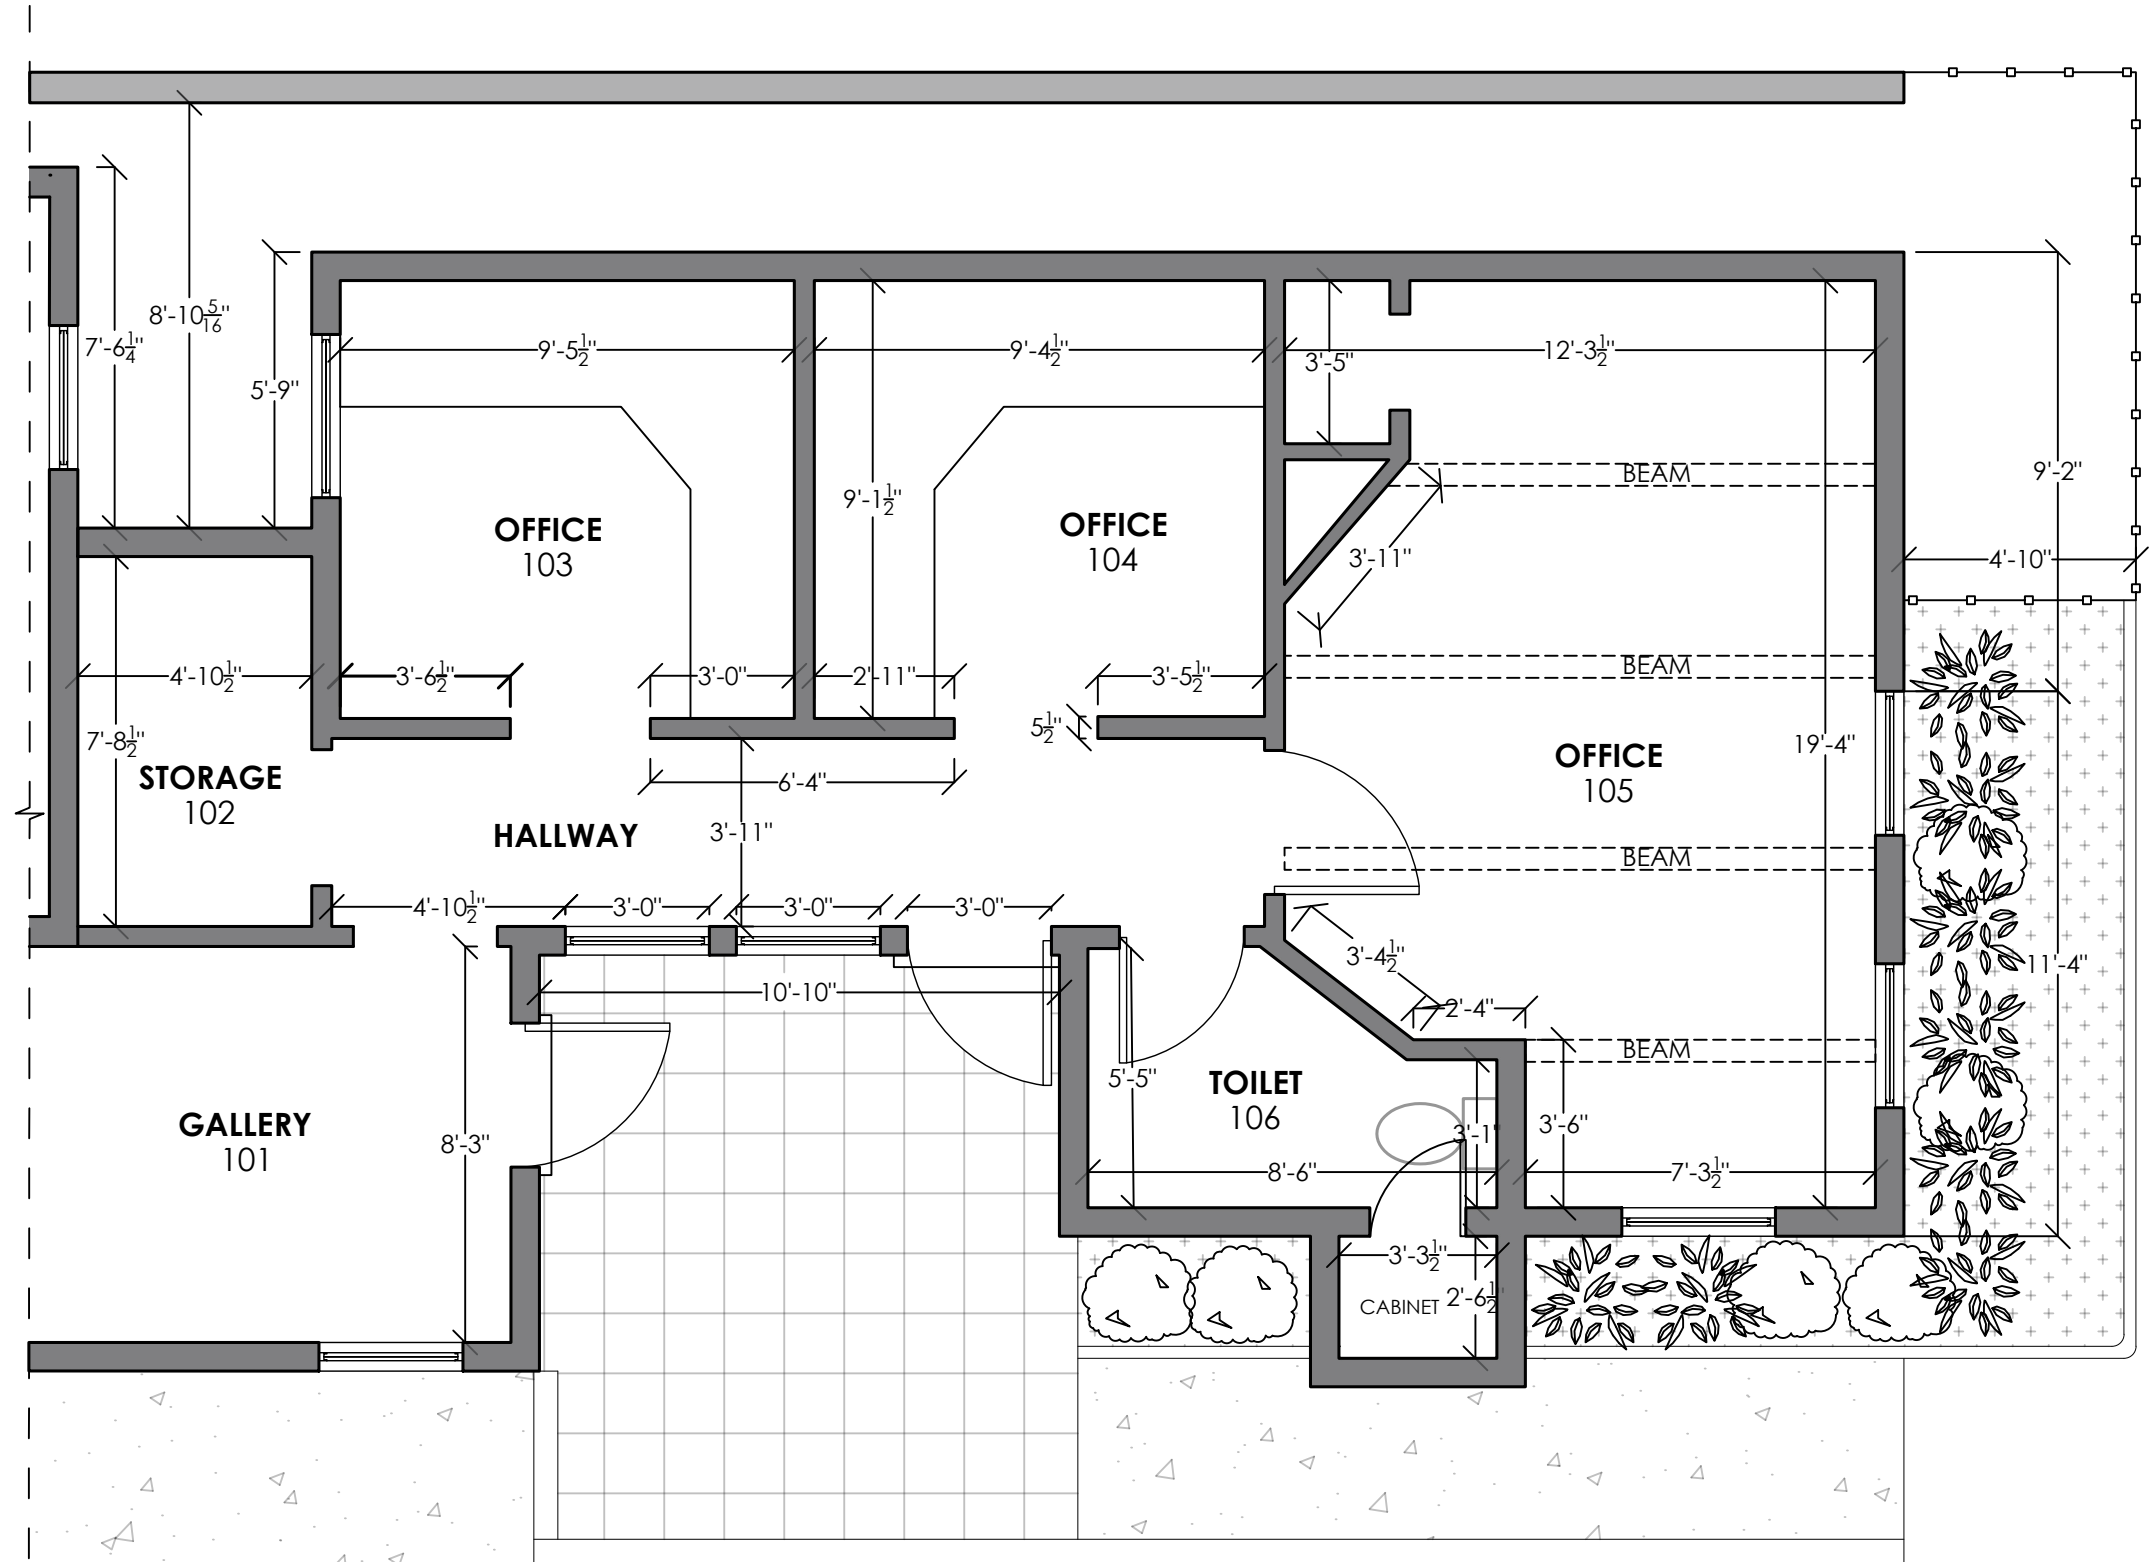

1 AS-BUILT FLOOR PLAN
SCALE: 1/4" = 1'-0"

LEGEND


(E) WALL TO REMAIN

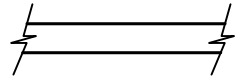

(N) WALL



NOTE: ALL DIMENSIONS SHOWN TO FACE OF FINISH

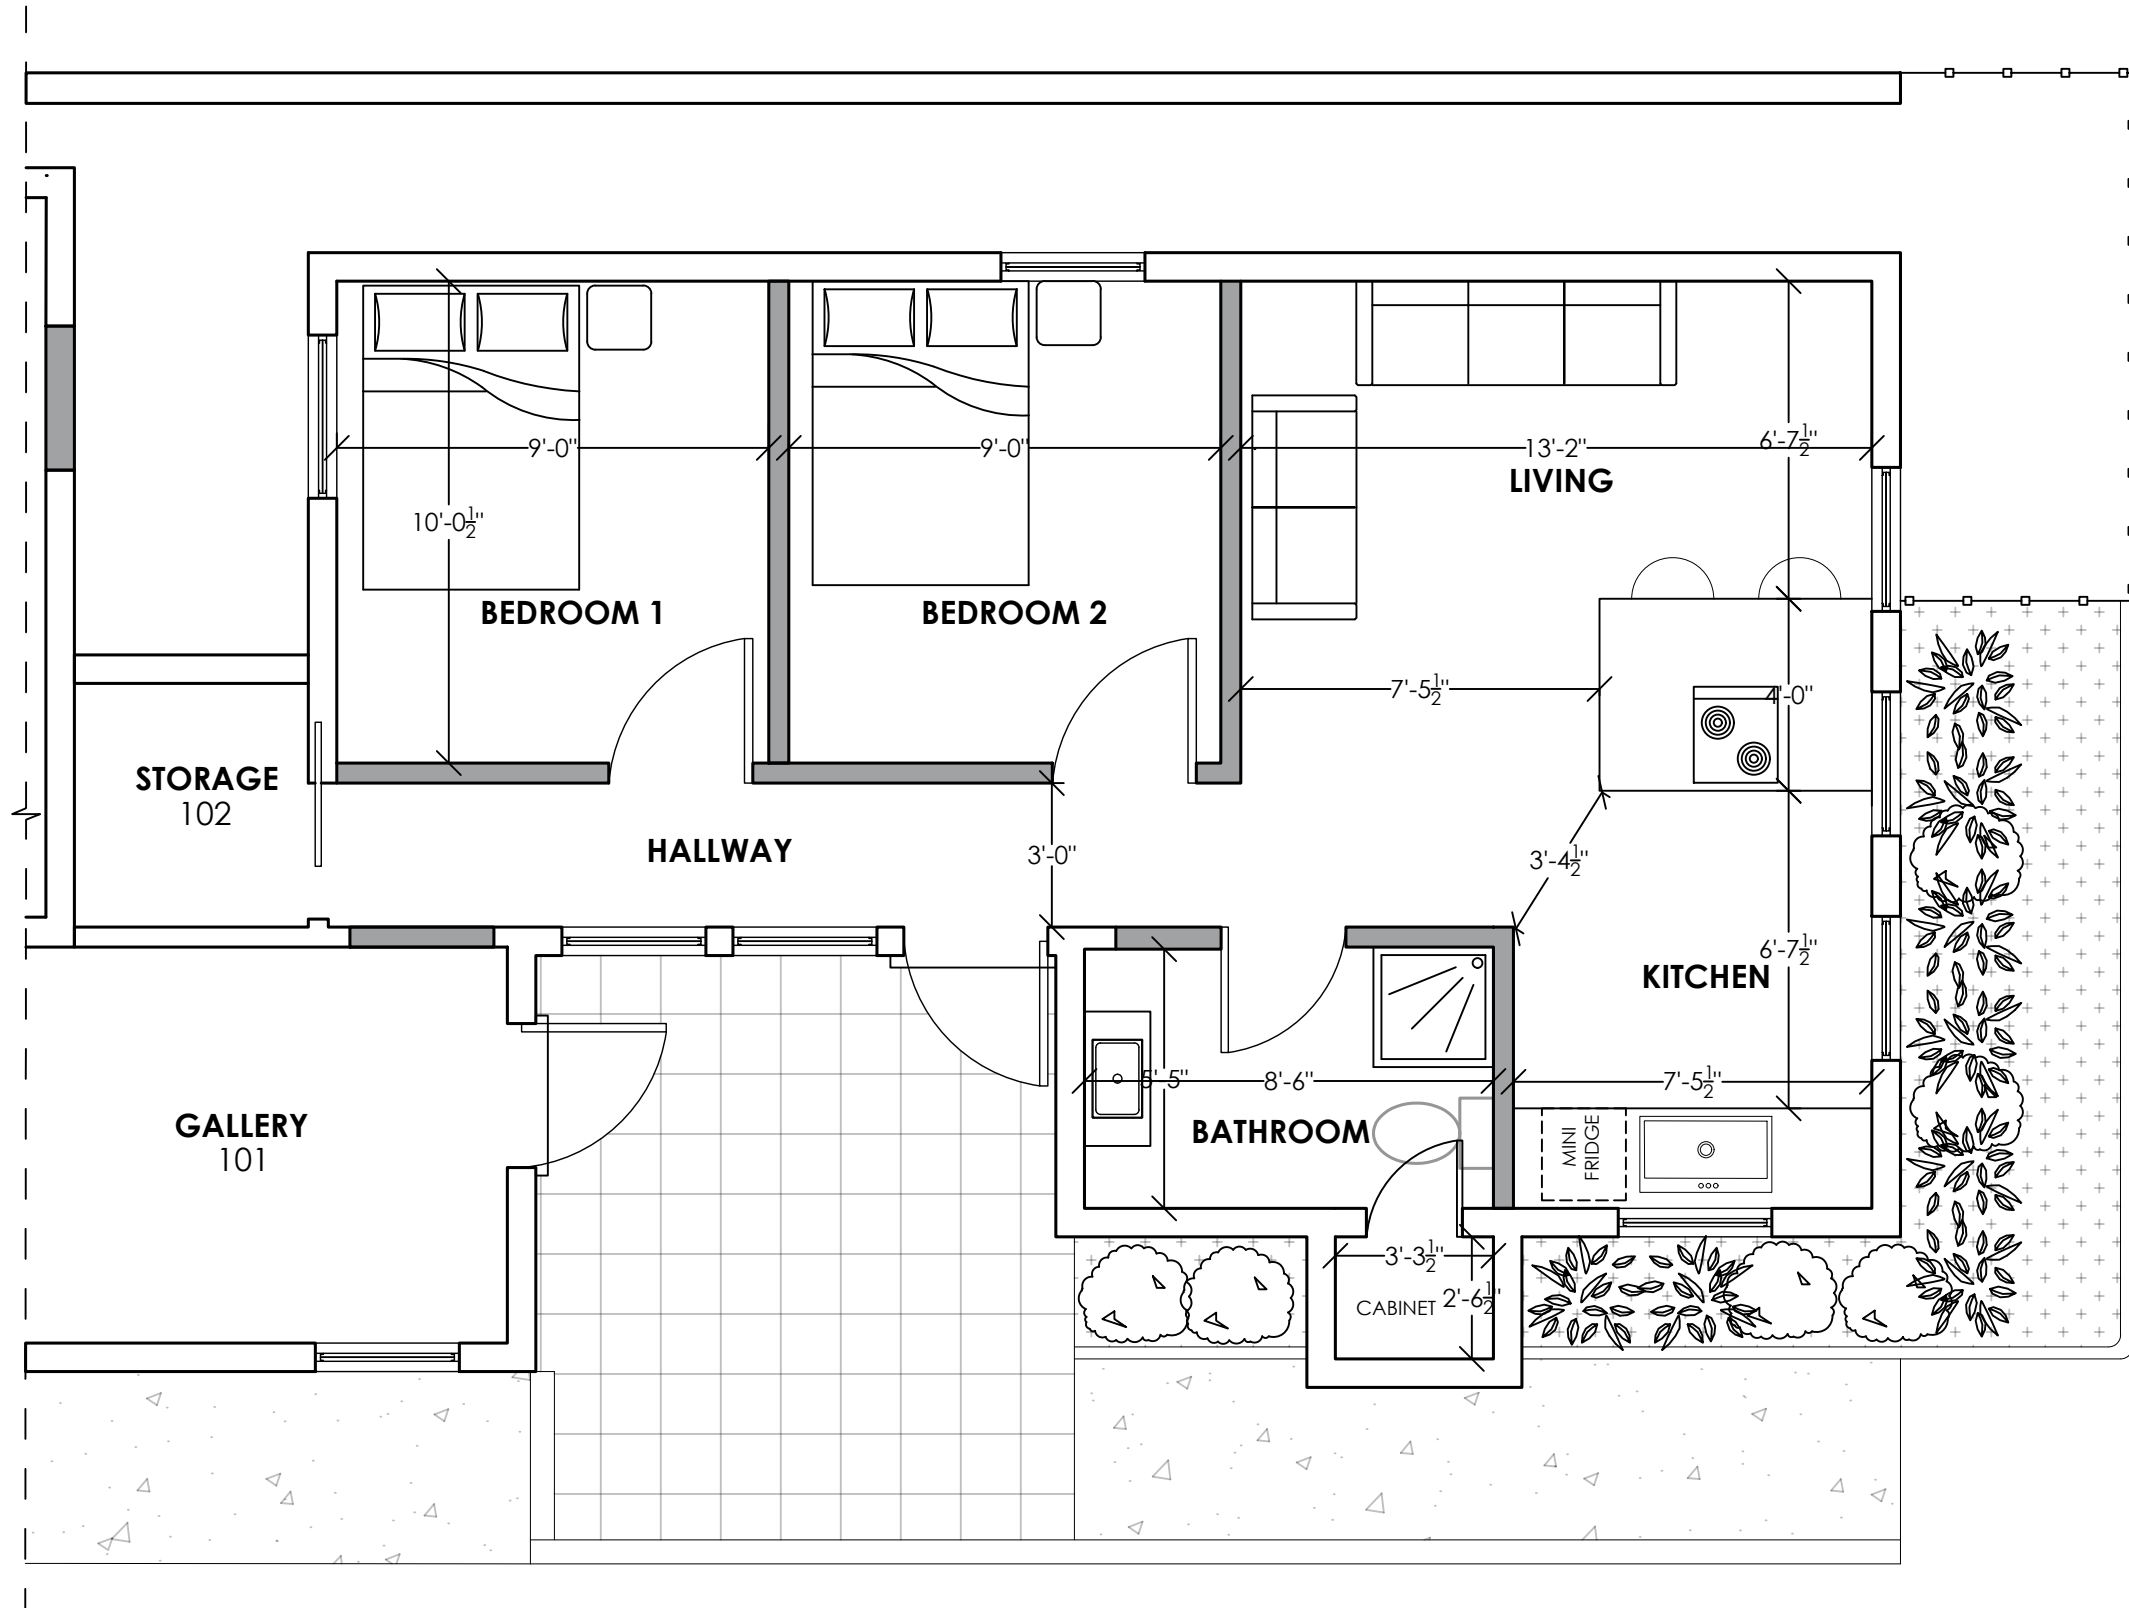


2

PROPOSED FLOOR PLAN - SCHEME A

SCALE: 1/4" = 1'-0"

LEGEND


(E) WALL TO REMAIN

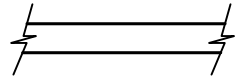

(N) WALL




NOTE: ALL DIMENSIONS SHOWN TO FACE OF FINISH

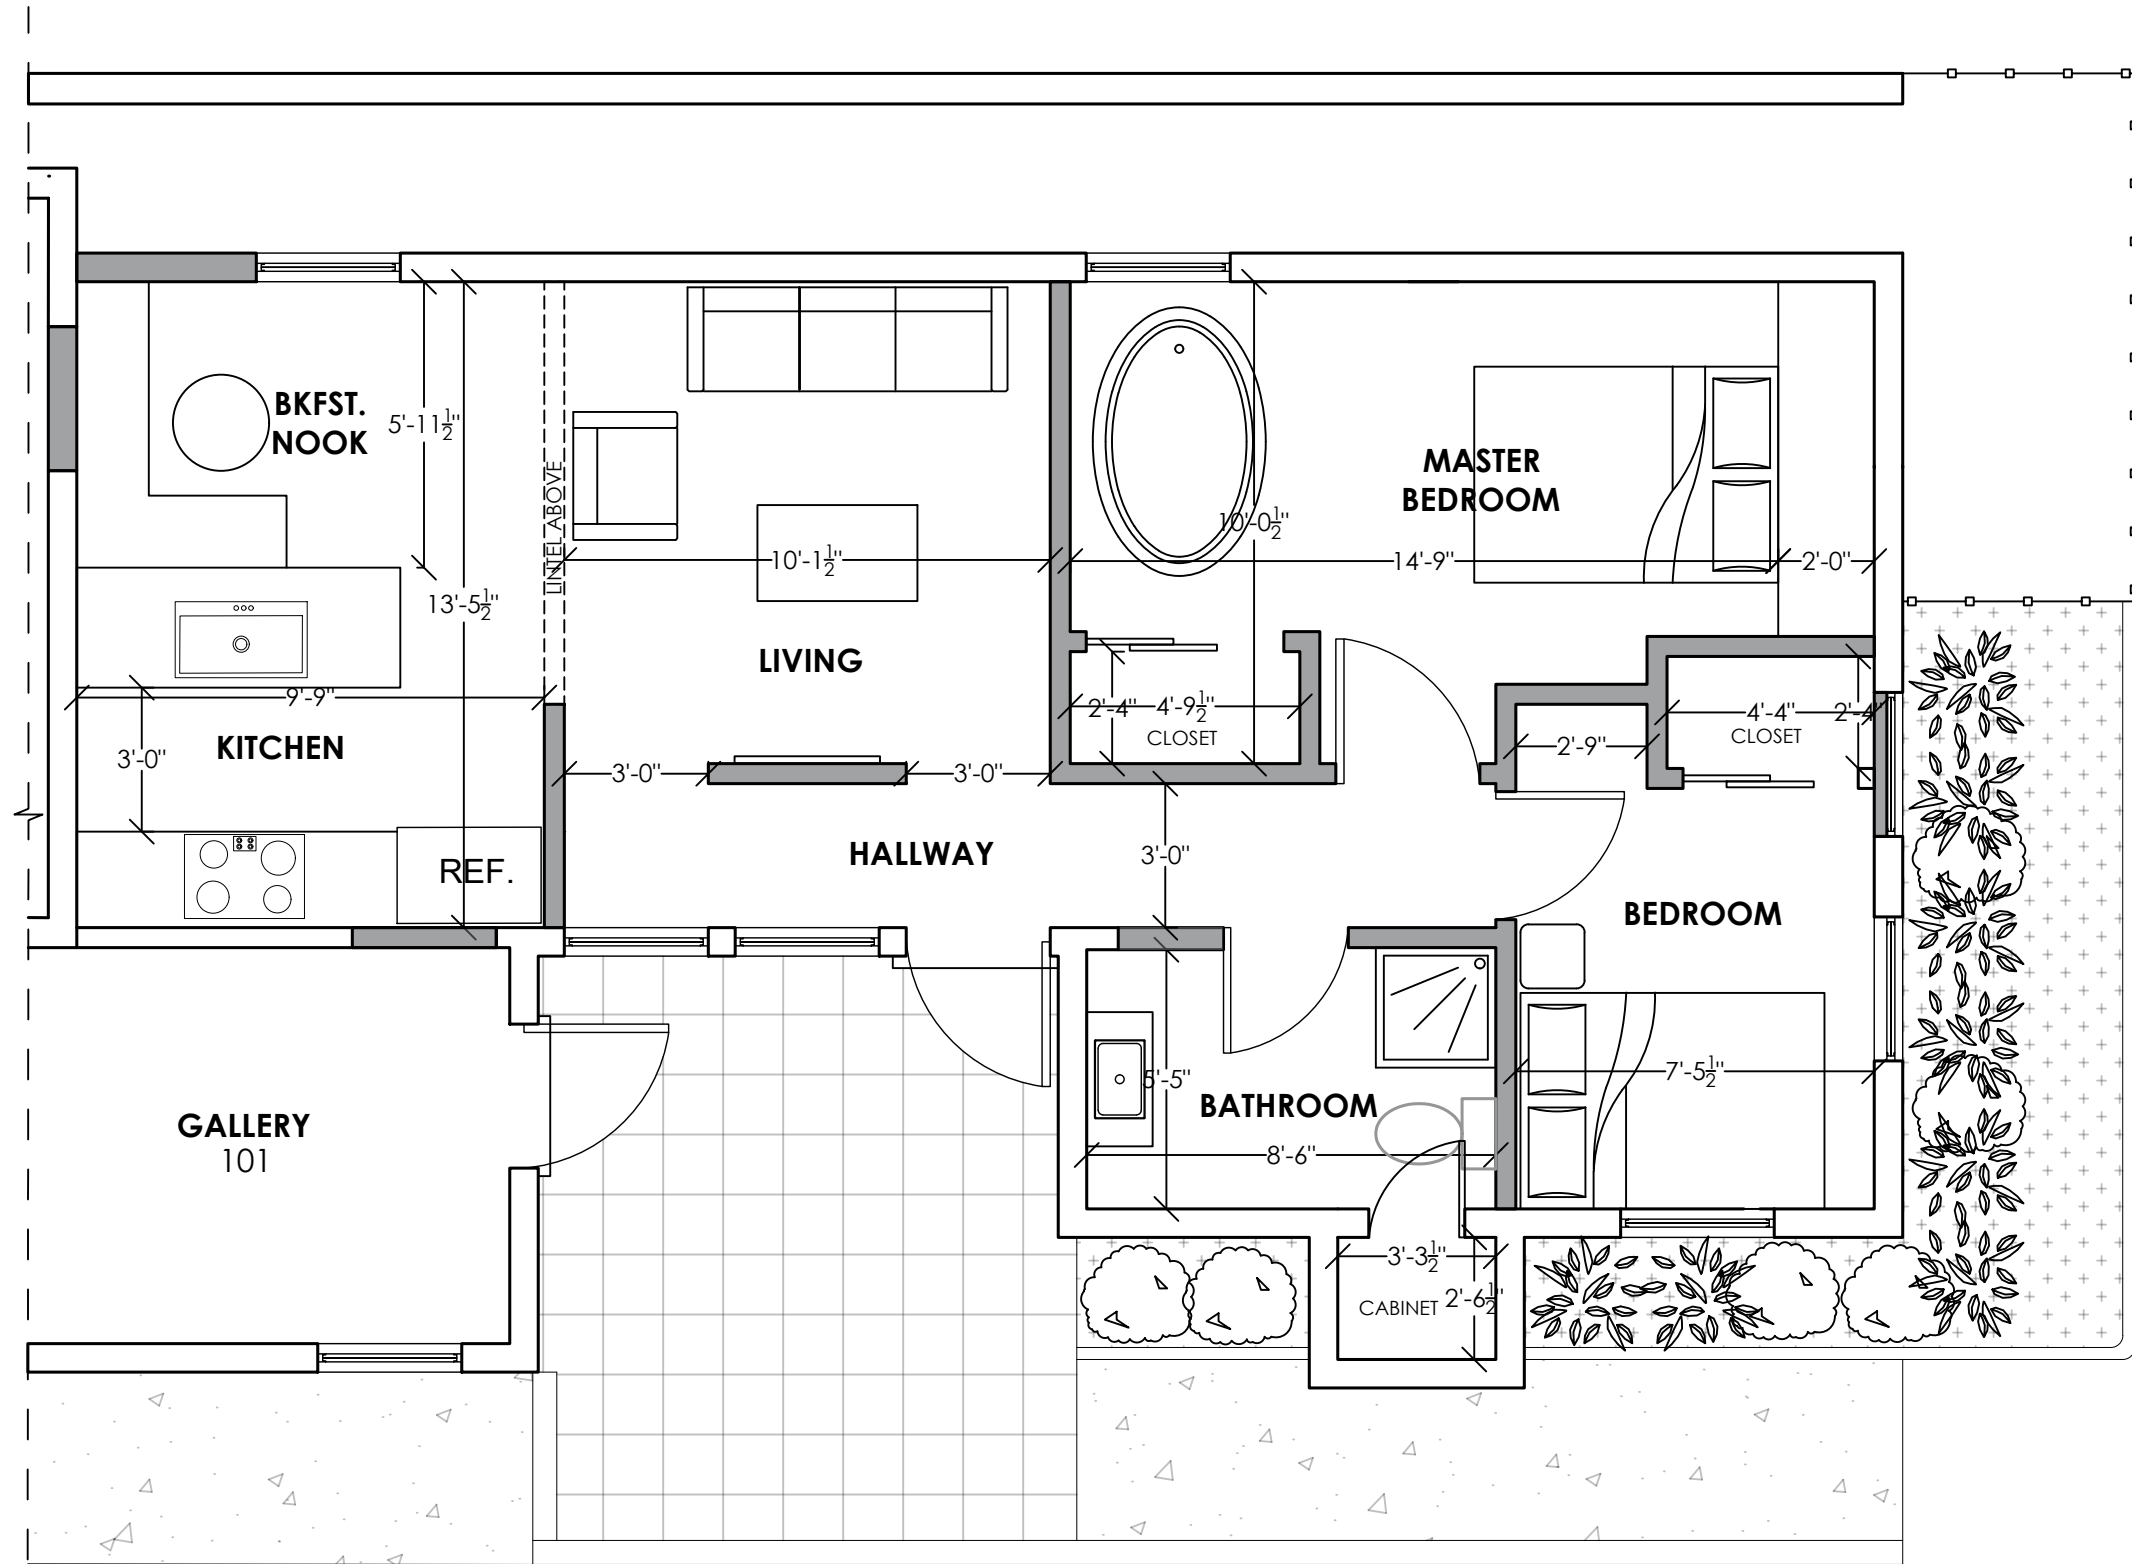

3 PROPOSED FLOOR PLAN - SCHEME B
SCALE: 1/4" = 1'-0"

LEGEND


(E) WALL TO REMAIN

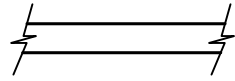

(N) WALL



NOTE: ALL DIMENSIONS SHOWN TO FACE OF FINISH

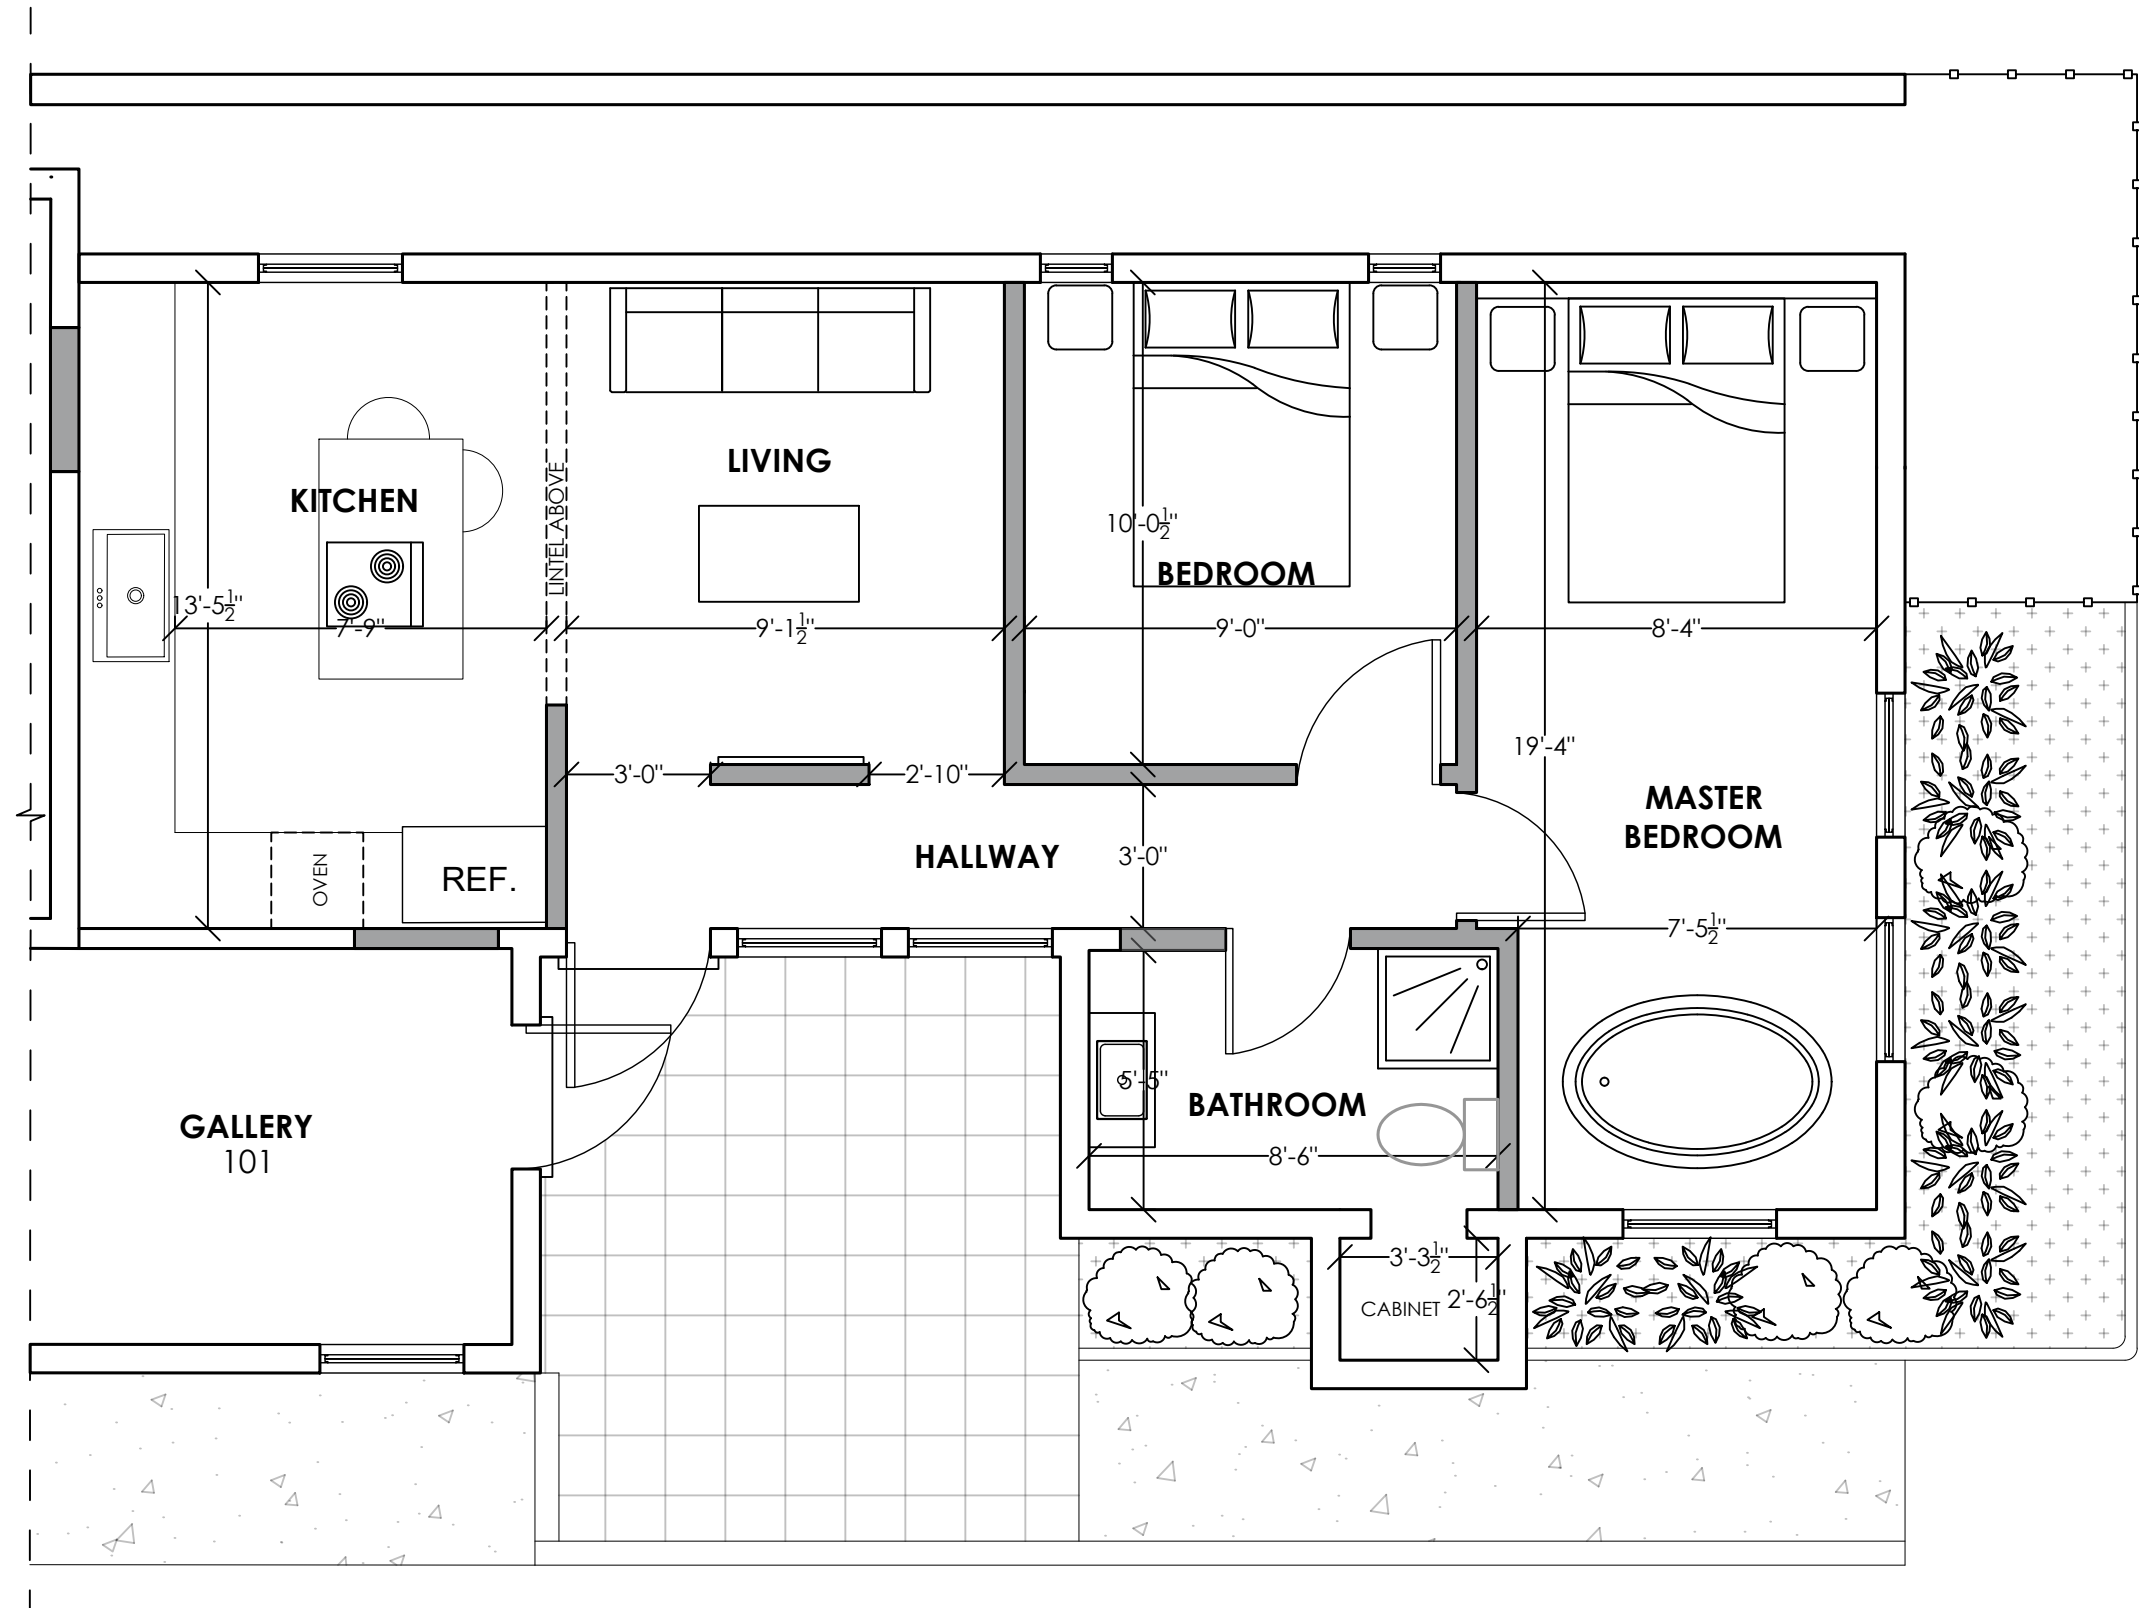

4 PROPOSED FLOOR PLAN - SCHEME C
SCALE: 1/4" = 1'-0"