


3148 EL CAMINO REAL

SANTA CLARA, CA 95051

STE 104

453 SQFT

AX-5

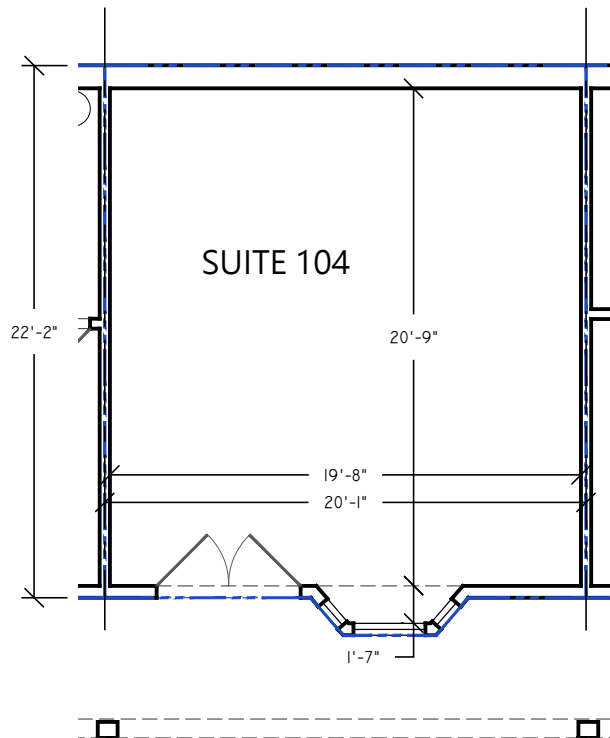

THIS DRAWING IS A RECORD OF REAL PROPERTY THAT IS GENERALLY ACCEPTED TO BE SUITABLE FOR USE IN PLANNING, DESIGN, LEASE, AND GENERAL ASSET MANAGEMENT. IT SHOULD NOT BE USED TO DETERMINE EXACT MEASUREMENTS OF SPACES OR ARTIFACTS FOUND HEREIN FOR ANY PURPOSE.


EXTERIOR ELEMENTS HAVE BEEN MEASURED AND DRAFTED FOR REFERENCE ONLY - THIS IS NOT A SURVEY.

REF: 3148SF-1_SantaClara_OFC
REV: 0

DRAWN BY: CS
AUDITED BY: TL

FIELD MEASURE:
2/03/2025

SCALE:
1/8"=1'-0"

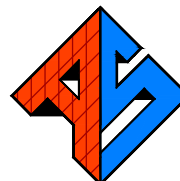

ASBUILT
SERVICES

FOR THE RECORD SINCE 1990

1-800-318-0099 ASBUILTSERVICES.COM