


1 EXISTING FLOOR PLAN - LOWER LEVEL
1/4" = 1'-0"

GENERAL FLOOR PLAN NOTES

- EXISTING FLOOR PLAN BASED ON LIMITED, NON-INVASIVE, SITE DOCUMENTATION.
- ALL ITEMS, MATERIALS, EQUIPMENT, WALL, DOORS, ETC. SHALL BE CONSIDERED 'EXISTING' AND SHOULD BE VERIFIED IN FIELD AS NEEDED.
- ALL DIMENSIONS AND SQUARE FOOTAGES INDICATED SHALL BE CONSIDERED +/- .
- THESE PLANS SHALL NOT BE USED FOR PERMITTING OR OTHER MUNICIPAL APPROVALS.

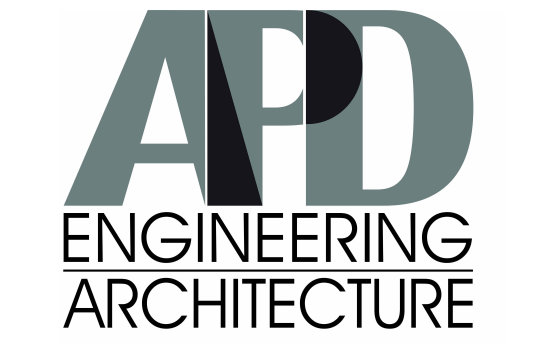

615 Fishers Run Victor, NY 14564
585.742.2222 - www.apd.com

Copyright © 2024
APD Engineering & Architecture

Drawing Alteration

It is a violation of law for any person, unless acting under the direction of licensed Architect, Professional Engineer, Landscape Architect, or Land Surveyor to alter any item on this document in any way. Any licensee who alters this document is required by law to affix his or her seal and to add the notation "Altered By" followed by his or her signature and the specific description of the alteration or revision.

DO NOT SCALE PLANS

Copying, Printing, Software and other processes required to produce these prints can stretch or shrink the actual paper or layout. Therefore, scaling of this drawing may be inaccurate. Contact APD E&A with any need for additional dimensions or clarifications.

3

Issued: _____ Date: _____

A	

Revisions: _____ Date: _____

2

PROJECT ARCHITECT/ENGINEER _____ DATE _____

PROJECT LEAD _____ DATE _____

NOT FOR CONSTRUCTION

Seal _____ Seal _____

1

293 West North Street
Geneva, NY 14456
Ontario County

Project Name & Location:

EXISTING FLOOR PLAN - LOWER LEVEL

Drawing Name:

Date: 10/25/2024 Project No. _____

Type: Record Set 24-0462

Drawn By: _____ MGJV EC-101

Scale: As Noted Drawing No. _____

D

C

B

A