
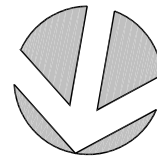


Adjacent Property

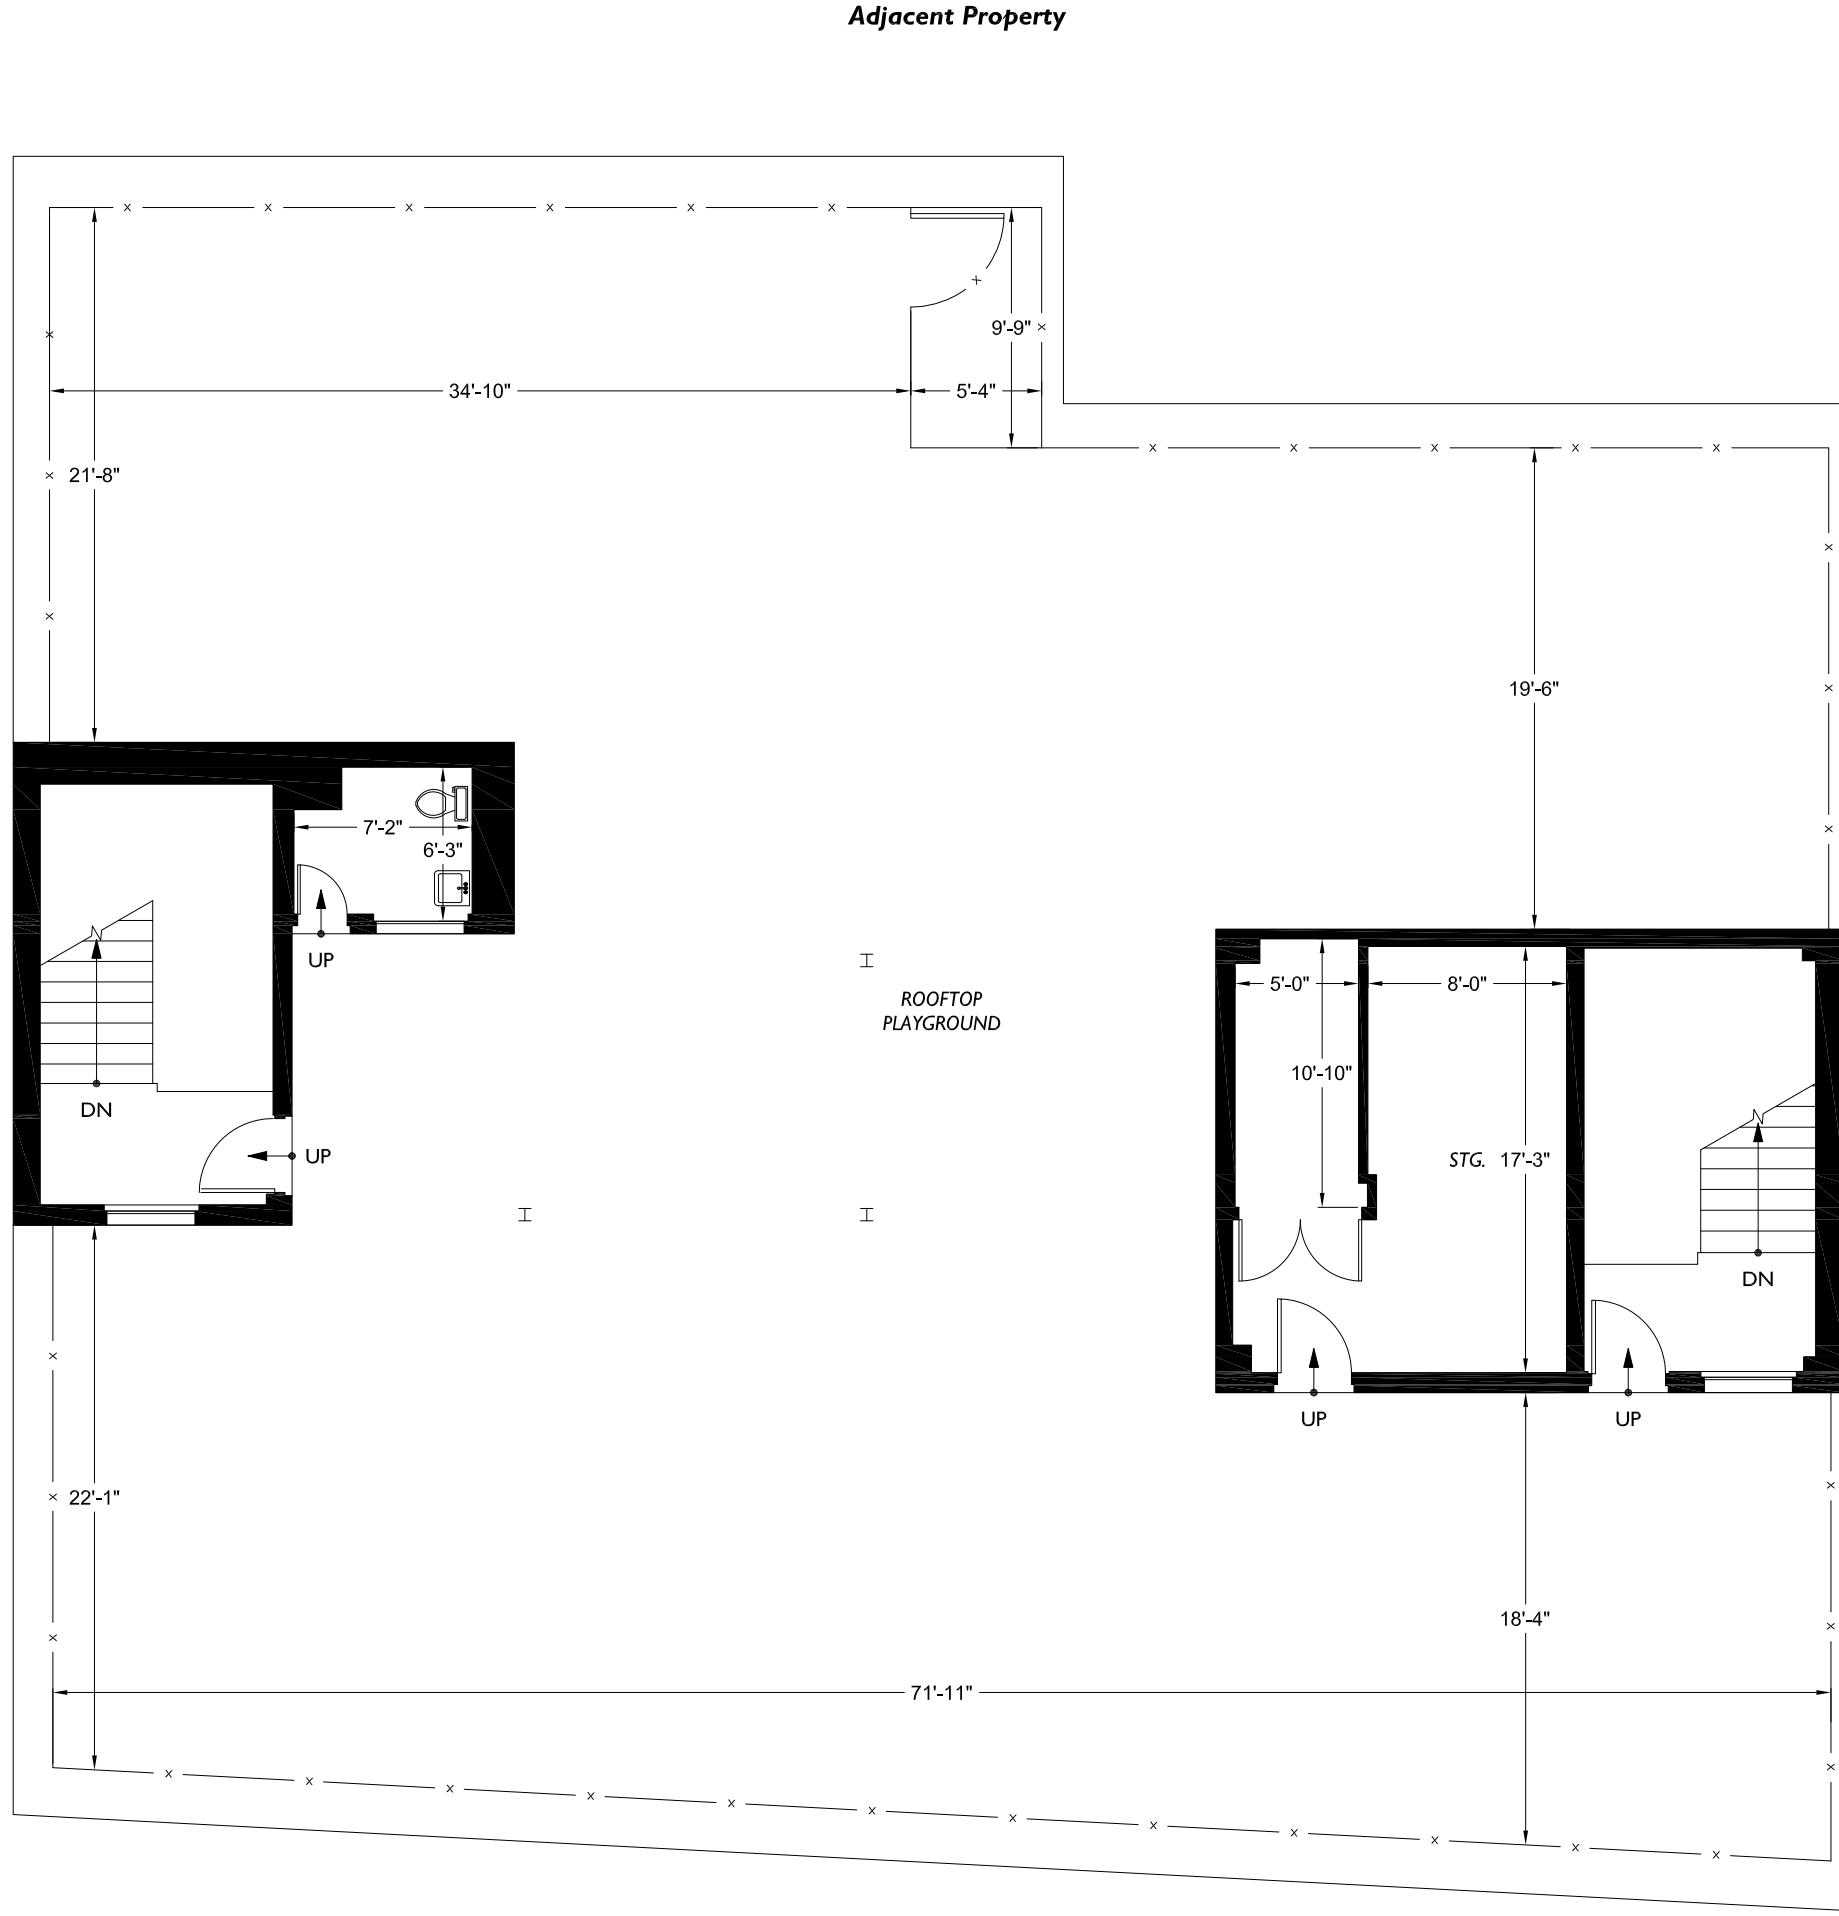

Braun Management Inc.
160 Broadway 1st Floor
New York, NY 10038

Malcolm X Day Care Center
111-12 Northern Boulevard
Corona, NY 11368

Floor Plan
ROOF
Floor

1/8" = 1'-0"
Scale

2DFLOORPLANS.COM
206-328-7410 fax 206-328-4764
AS-BUILT
FLOOR PLANS

1700 21st Avenue South Suite 100
Seattle, WA 98144
Measured: May 2015
Project: C15-530