




AS-BUILT ELEVATIONS
1/8" SCALE

EAST

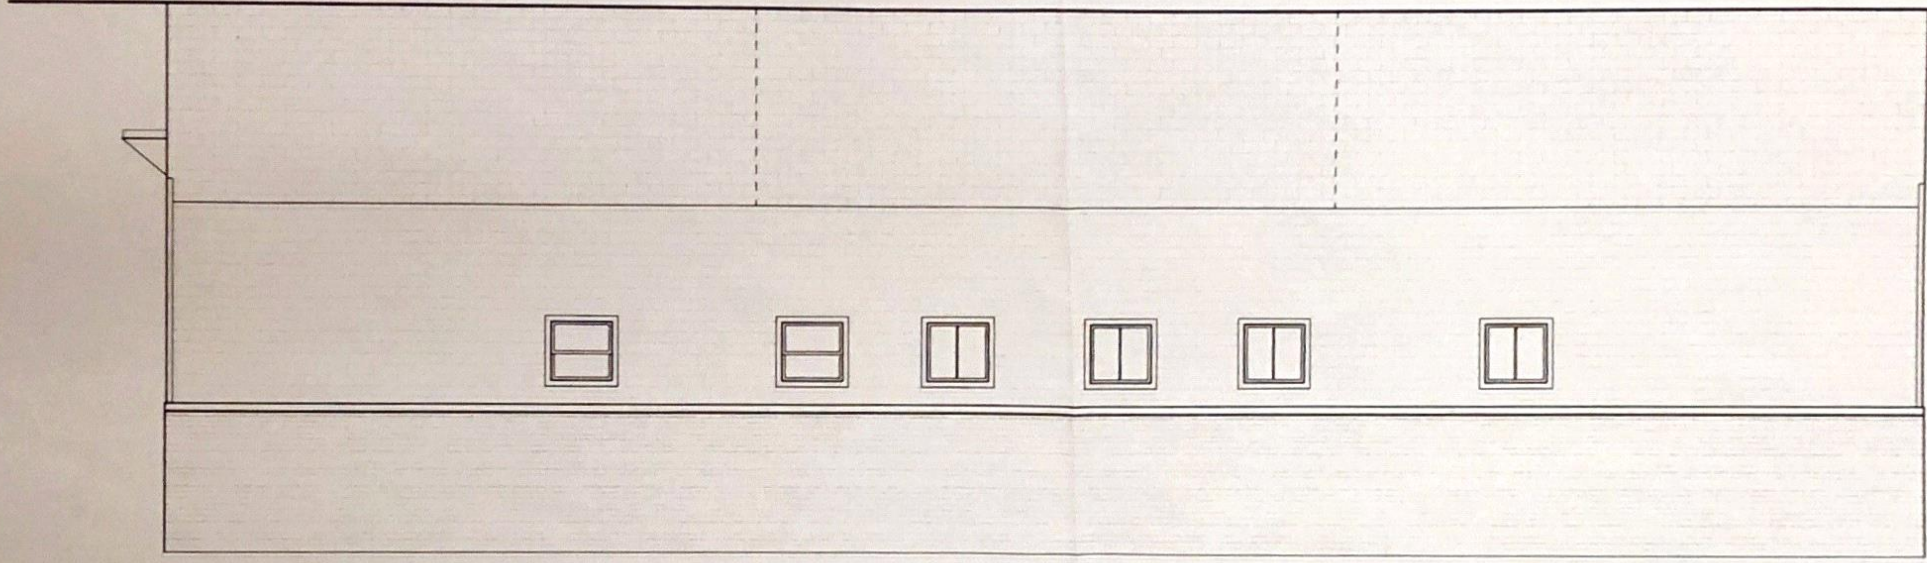


WEST

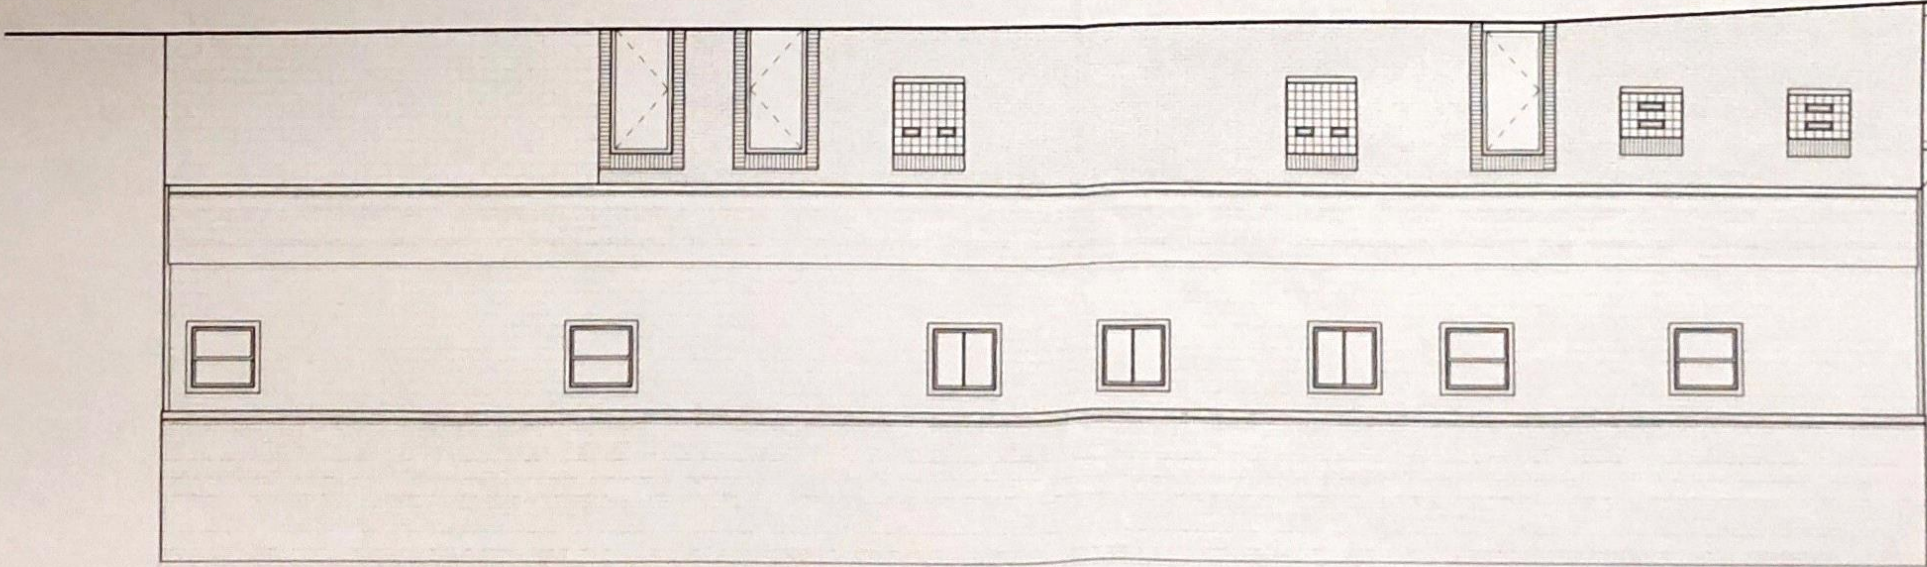

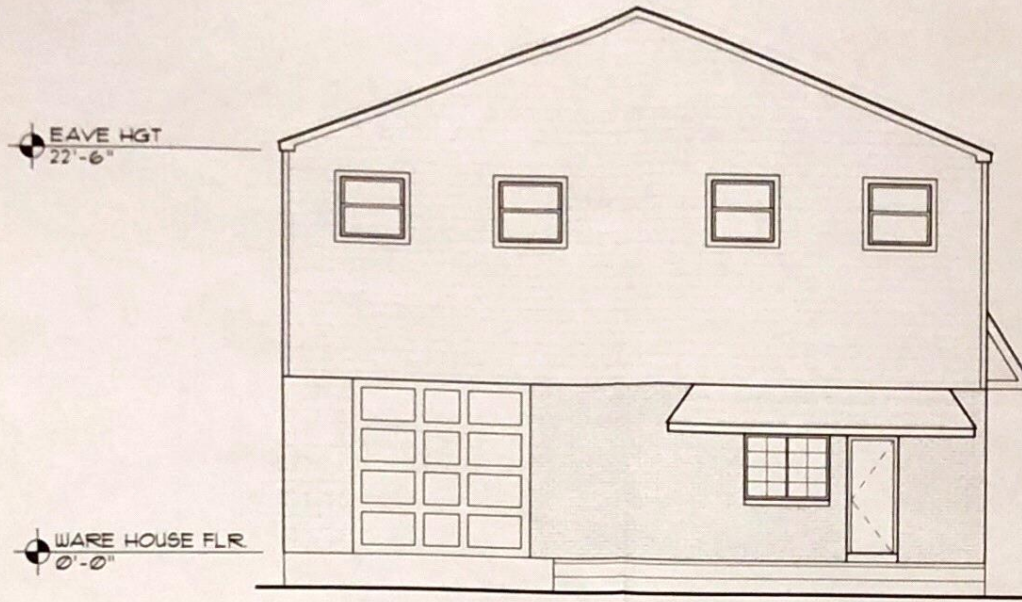

NORTH

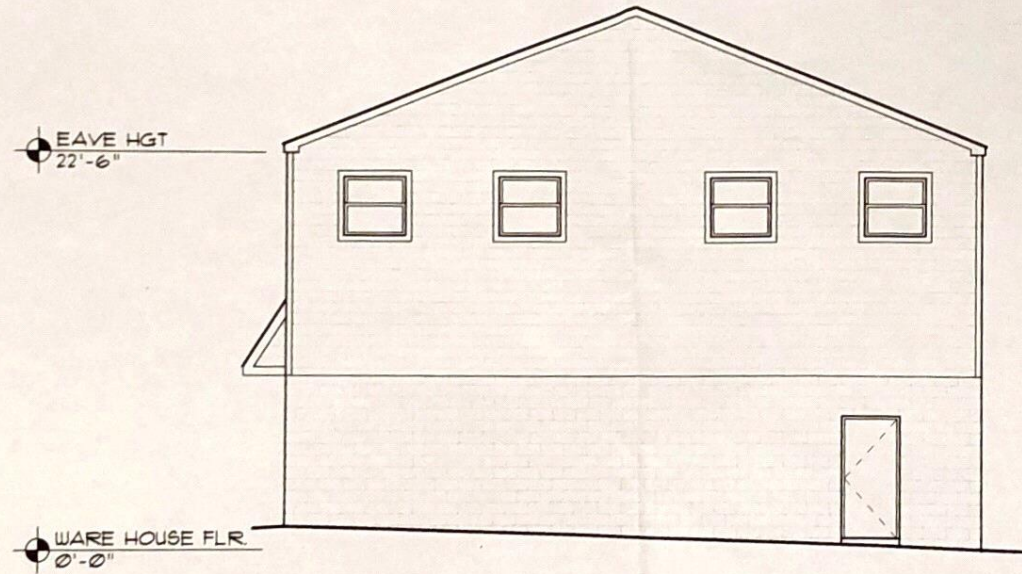

SOUTH

AS-BUILT ELEVATIONS
1/8" SCALE

226 W. MAPLE ST.,
DATE: 8-23-19