


As-Built

LEGEND

- SIDEWALL ADJUSTABLE REGISTER
- CEILING 2'x2' LAY-IN DIFFUSER
- CEILING EGGRATE RETURN
- UNIT HEATER
- FIRE DAMPER (FD)
- INSULATED DUCT
- TRANSFER GRILLE
- THERMOSTAT
- OPENING ABOVE CEILING

- NOTES:**
1. ALL DUCTWORK TO HAVE MAXIMUM 6' OF FLEX TO DIFFUSERS
 2. LINE RETURN DROP FIRST 6'

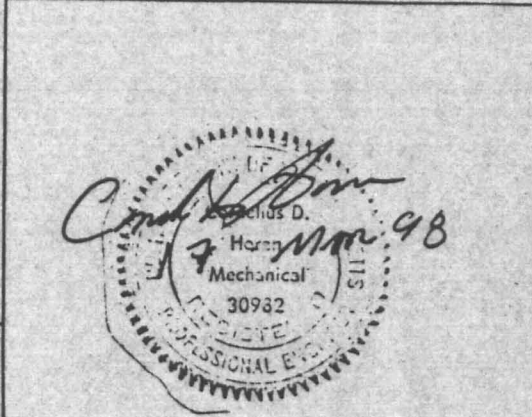

J.F. PLUMBING CO.
 2 CAUSEWAY STREET
 MEDFIELD, MA. 02052

HARRIS ENVIRONMENTAL SYSTEMS
 31 CONNECTOR ROAD
 ANDOVER, MASSACHUSETTS 01810
 TEL. (908) 478-0104

CUSTOMER: NEW BOSTON SEAFOOD

TITLE/SYSTEM	DATE	BY	CHKD
MECHANICAL DUCT LAYOUT (FIRST FLOOR)	01/28/98	SN	CH

PROJECT	DATE	BY	CHKD
BUILDING 1	D 3543	A1	