



4717-B South Mingo Road
Tulsa, OK



Office/Warehouse/Flex FOR LEASE

1,875 SF Office
250 SF Warehouse
2,125 SF Total

Open work area
2 rest rooms.

Climate -controlled warehouse
Easy Expressway Access


Call Dave Hall
918-665-2700

The information contained herein was obtained from sources deemed reliable, but is not guaranteed. All interested parties Are encouraged to thoroughly investigate the Property.



Kinslow, Keith & Todd, Inc.
architecture interiors engineering

tel 918.744.4270
fax 918.744.7849
2200 south ulica place, suite 200
tulsa, oklahoma 74114
www.kktarchitects.com

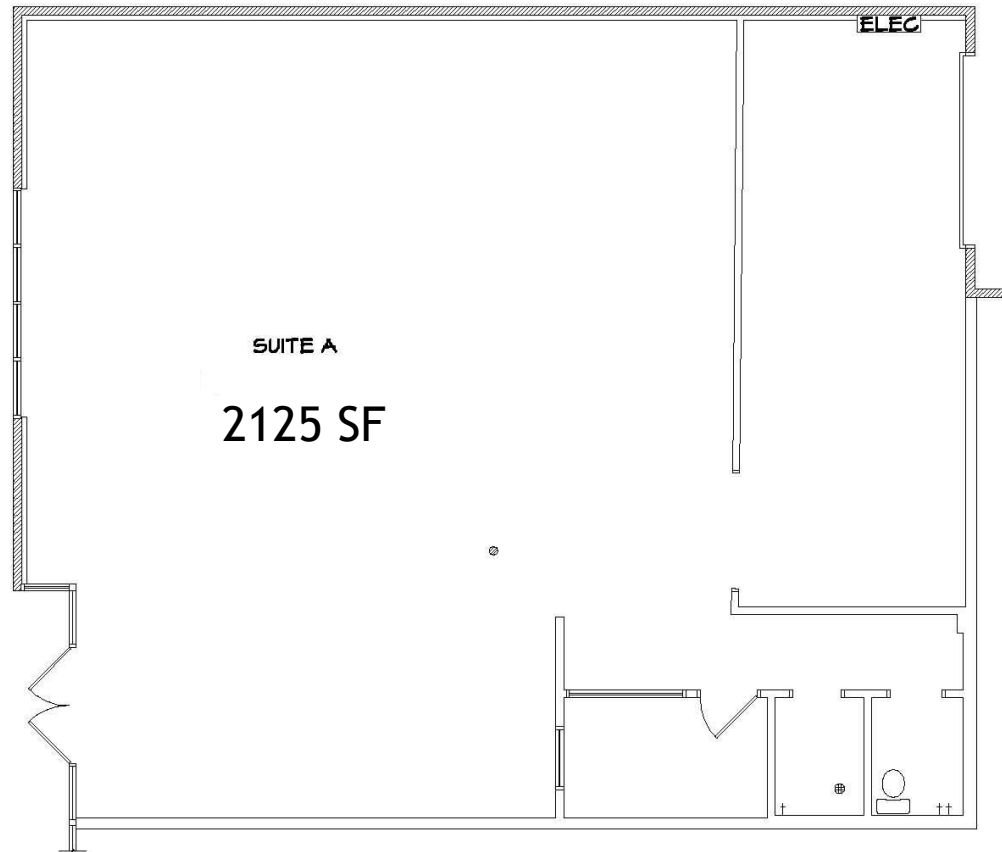

**PARK
PLACE**

4717 S. MINGO

SUITE-A

CBRE

SCALE	N.T.S.
FILE NAME	PP-AS-1
MANAGER	TT
DRAWN BY	TT
3/1/13	

AS-BUILT
PLAN
AS-1

A FLOOR PLAN 
SCALE: N.T.S. NORTH