




triad design group
Architecture | Engineering | Interior Design

Triad Design Group, P.C.
4807-C Koger Boulevard
Greensboro, NC 27407
Telephone 336-218-8282
Facsimile 336-218-8010
www.triad-designgroup.com


NC Architecture Reg. 50709
NC Engineering Lic. C-1108

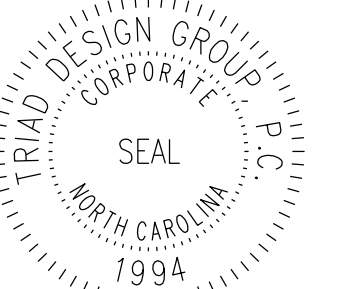

PRELIMINARY

NOT FOR CONSTRUCTION

Wingate Building
ORP Management
4900 Koger Boulevard
Greensboro, North Carolina 27407

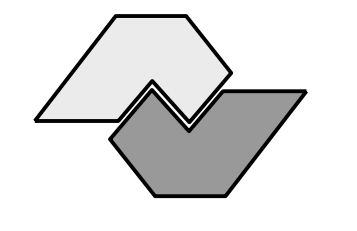

SUBMITTALS:

DATE DESCRIPTION

REVISIONS:

NO DATE DESCRIPTION

SHEET TITLE:

AS-BUILT OVERALL FIRST FLOOR


Date: FEBRUARY 18, 2021

Drawn: — Check: MTM

Job Number: 21-006

Sheet:

A101

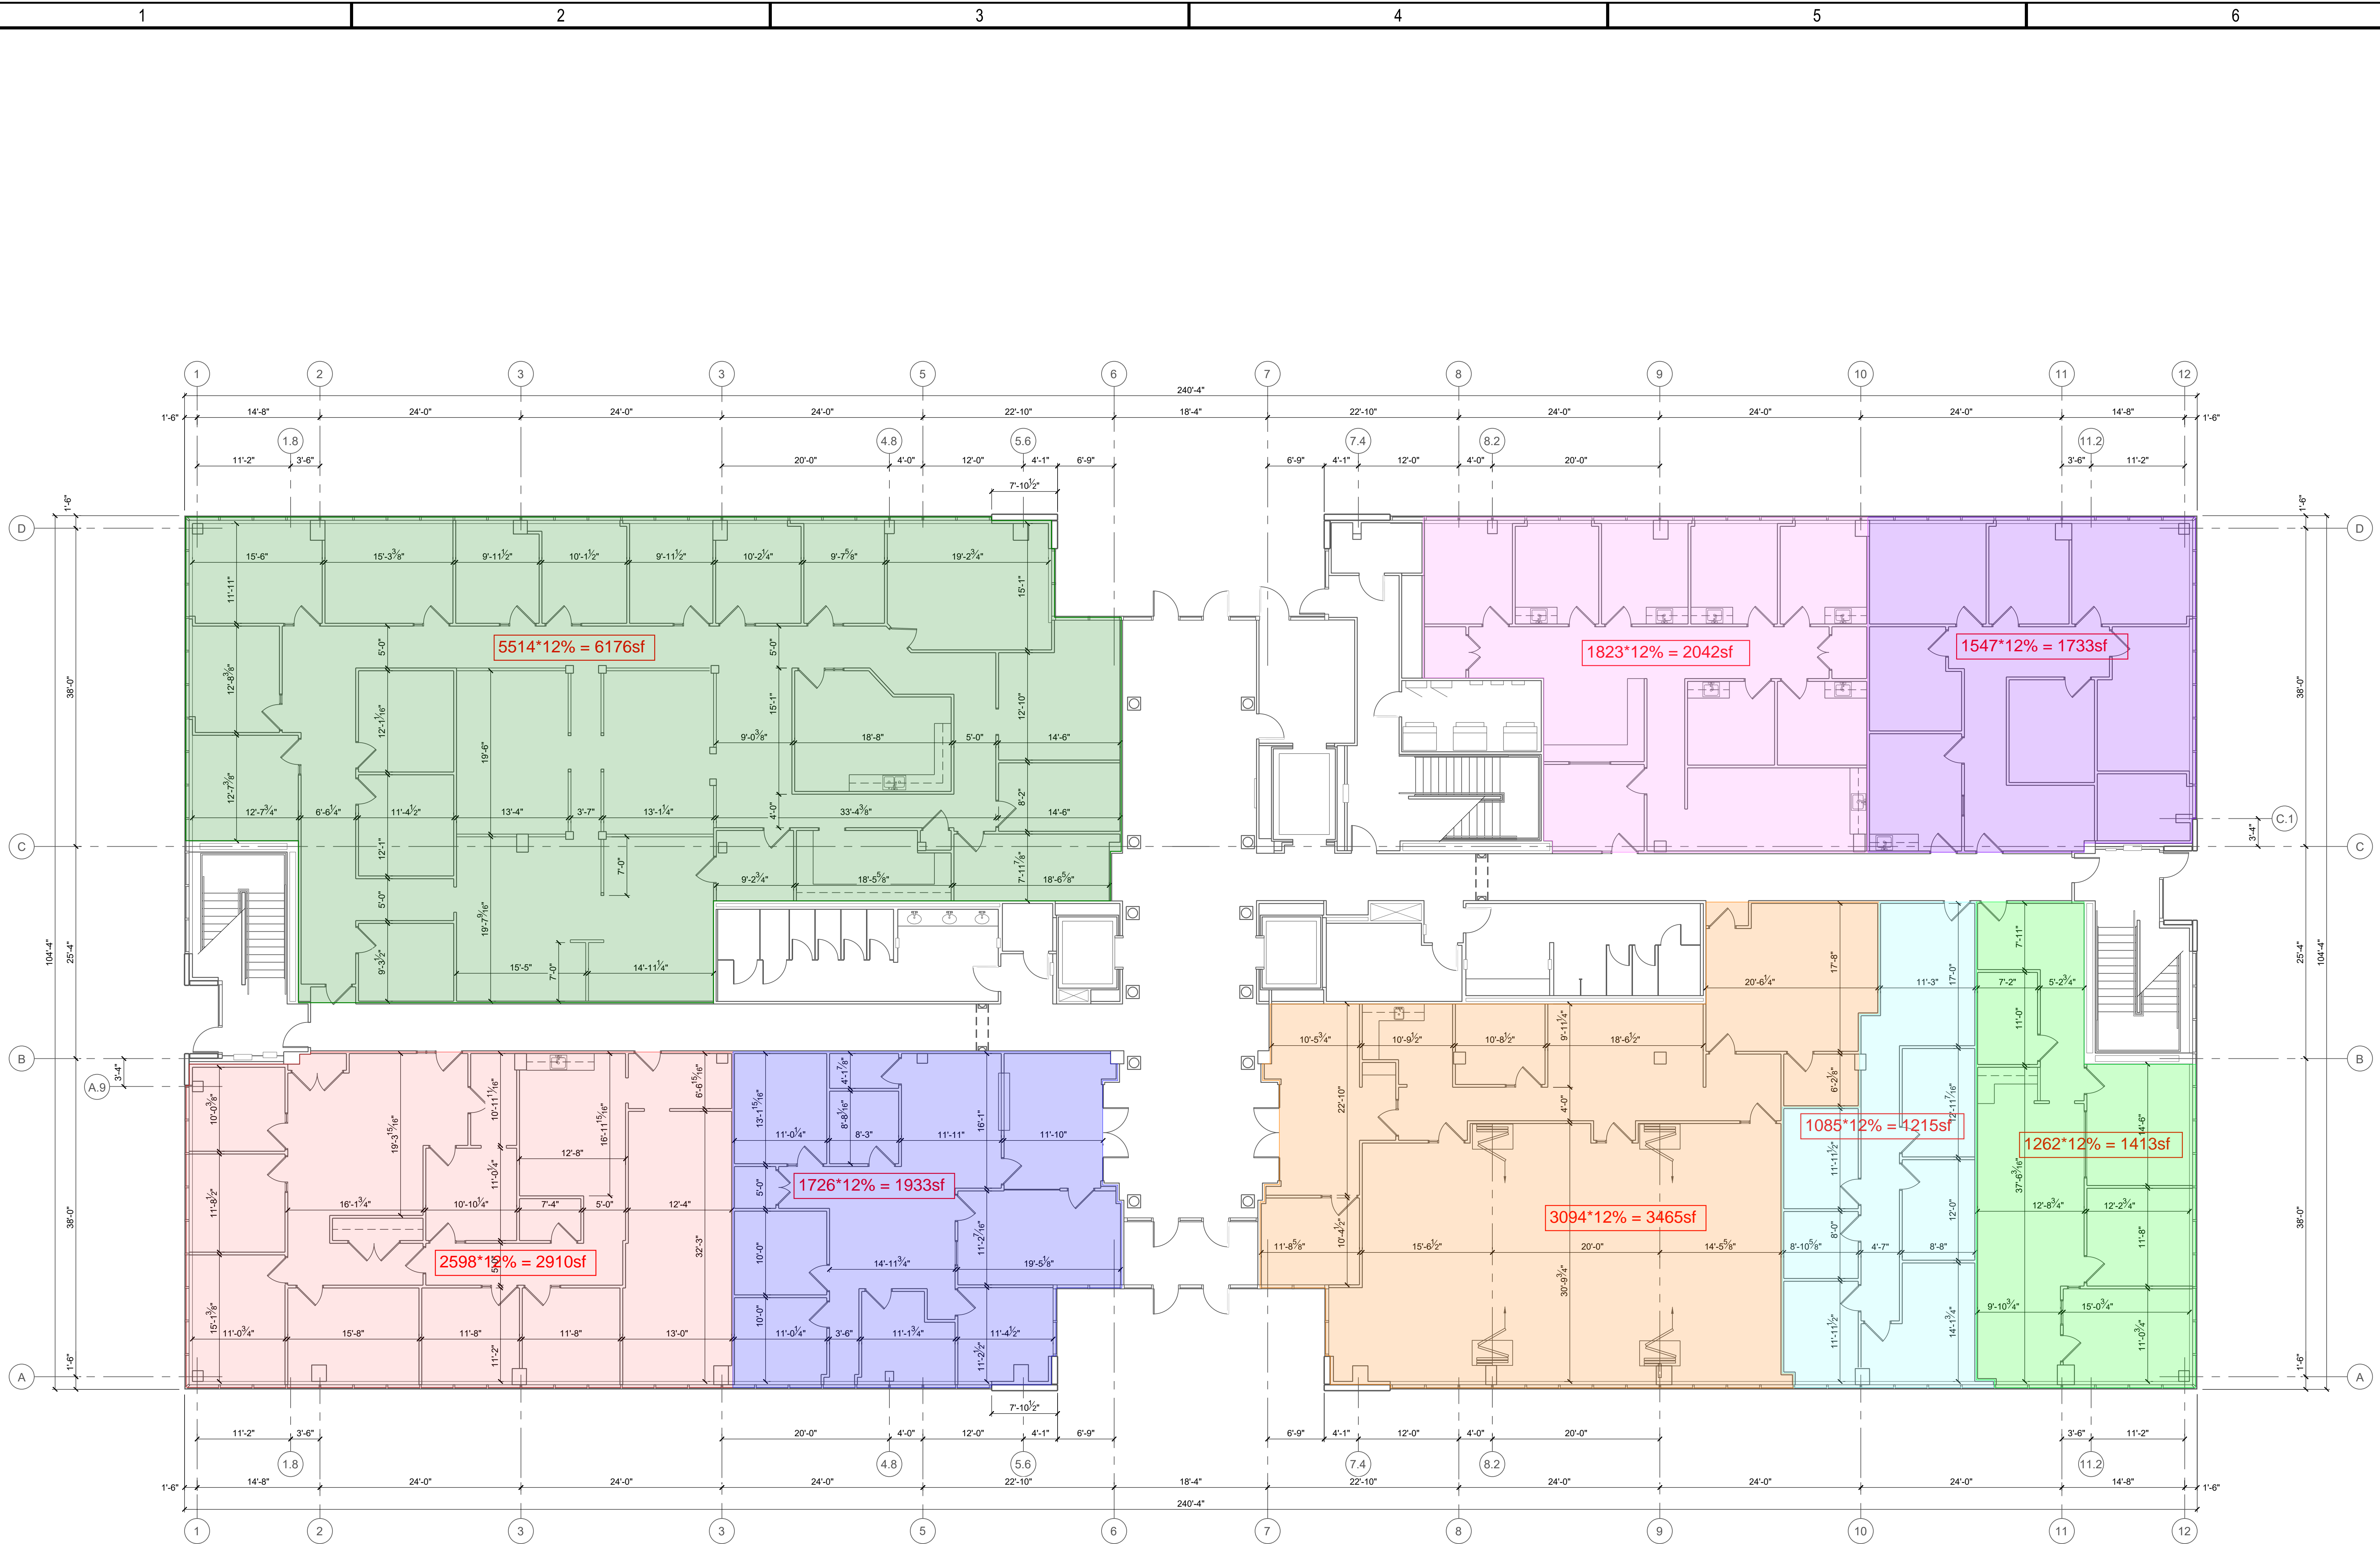

A1 EXISTING FIRST FLOOR PLAN
SCALE: 1/8"=1'-0"

DRAWING NAME: P:\2021\ORP Management 1st Floor As-Built 21-006\Arch\Wingate_Bldg_1.dwg - 30 x 42 - 2/20/2021 12:22 PM