


LEDGEROCK INDUSTRIAL CONDOMINIUM

FLOOR PLAN
IN
ACTON, MASS.
(MIDDLESEX COUNTY)

SCALE: 1/8" = 1'-0" NOV. 5, 1990

STAMSKI AND McNARY, INC.
80 HARRIS STREET ACTON, MASS.
ENGINEERING - PLANNING - SURVEYING

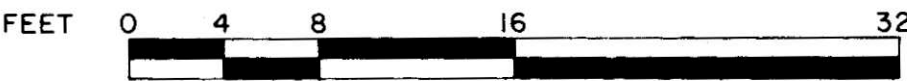



NOTE
ALL MEASUREMENTS TAKEN FROM
FACE OF CONCRETE BLOCK WALLS.


I CERTIFY THAT THIS PLAN HAS BEEN PREPARED
IN CONFORMITY WITH THE RULES AND REGULATIONS
OF THE REGISTERS OF DEEDS OF THE COMMONWEALTH
OF MASSACHUSETTS.

7 JAN 91
DATE
REG. PROFESSIONAL LAND SURVEYOR

I CERTIFY THAT THIS PLAN FULLY AND ACCURATELY
DEPICTS THE LAYOUT, LOCATION, UNIT NUMBER AND
DIMENSIONS OF UNITS AS BUILT.


7 JAN 91
DATE
REG. PROFESSIONAL LAND SURVEYOR

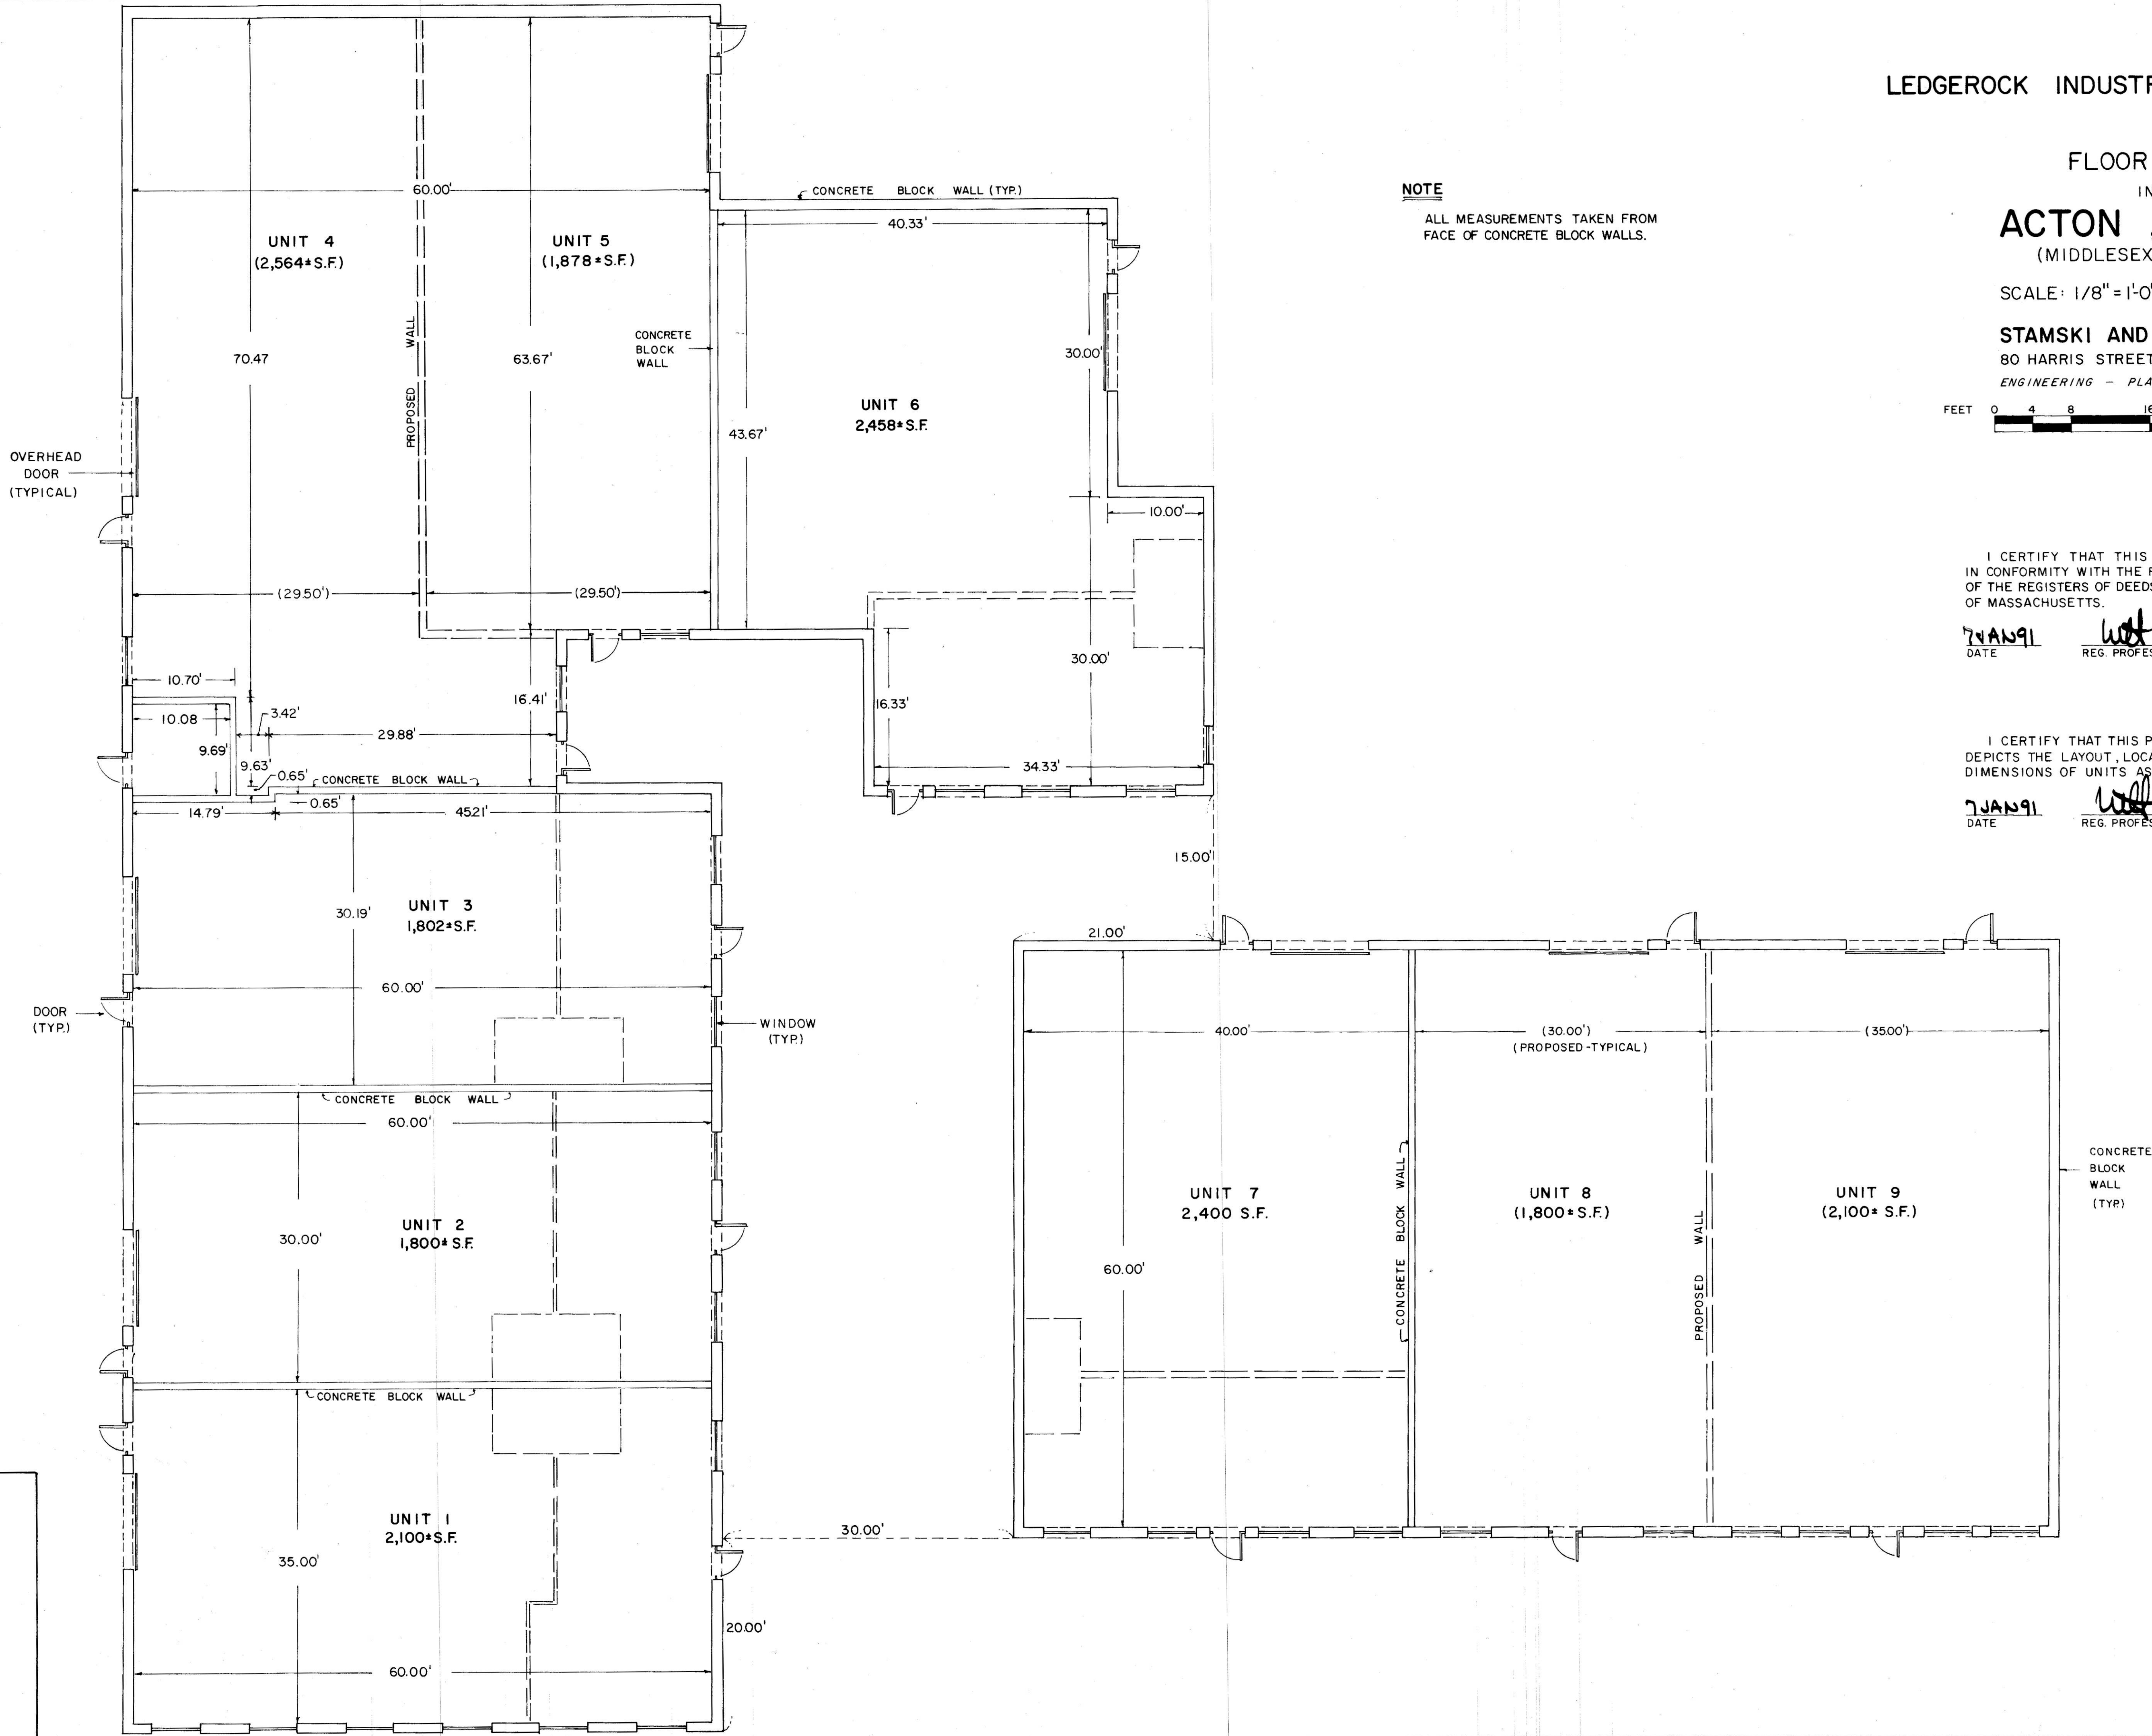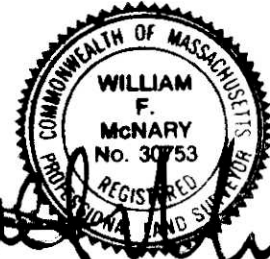

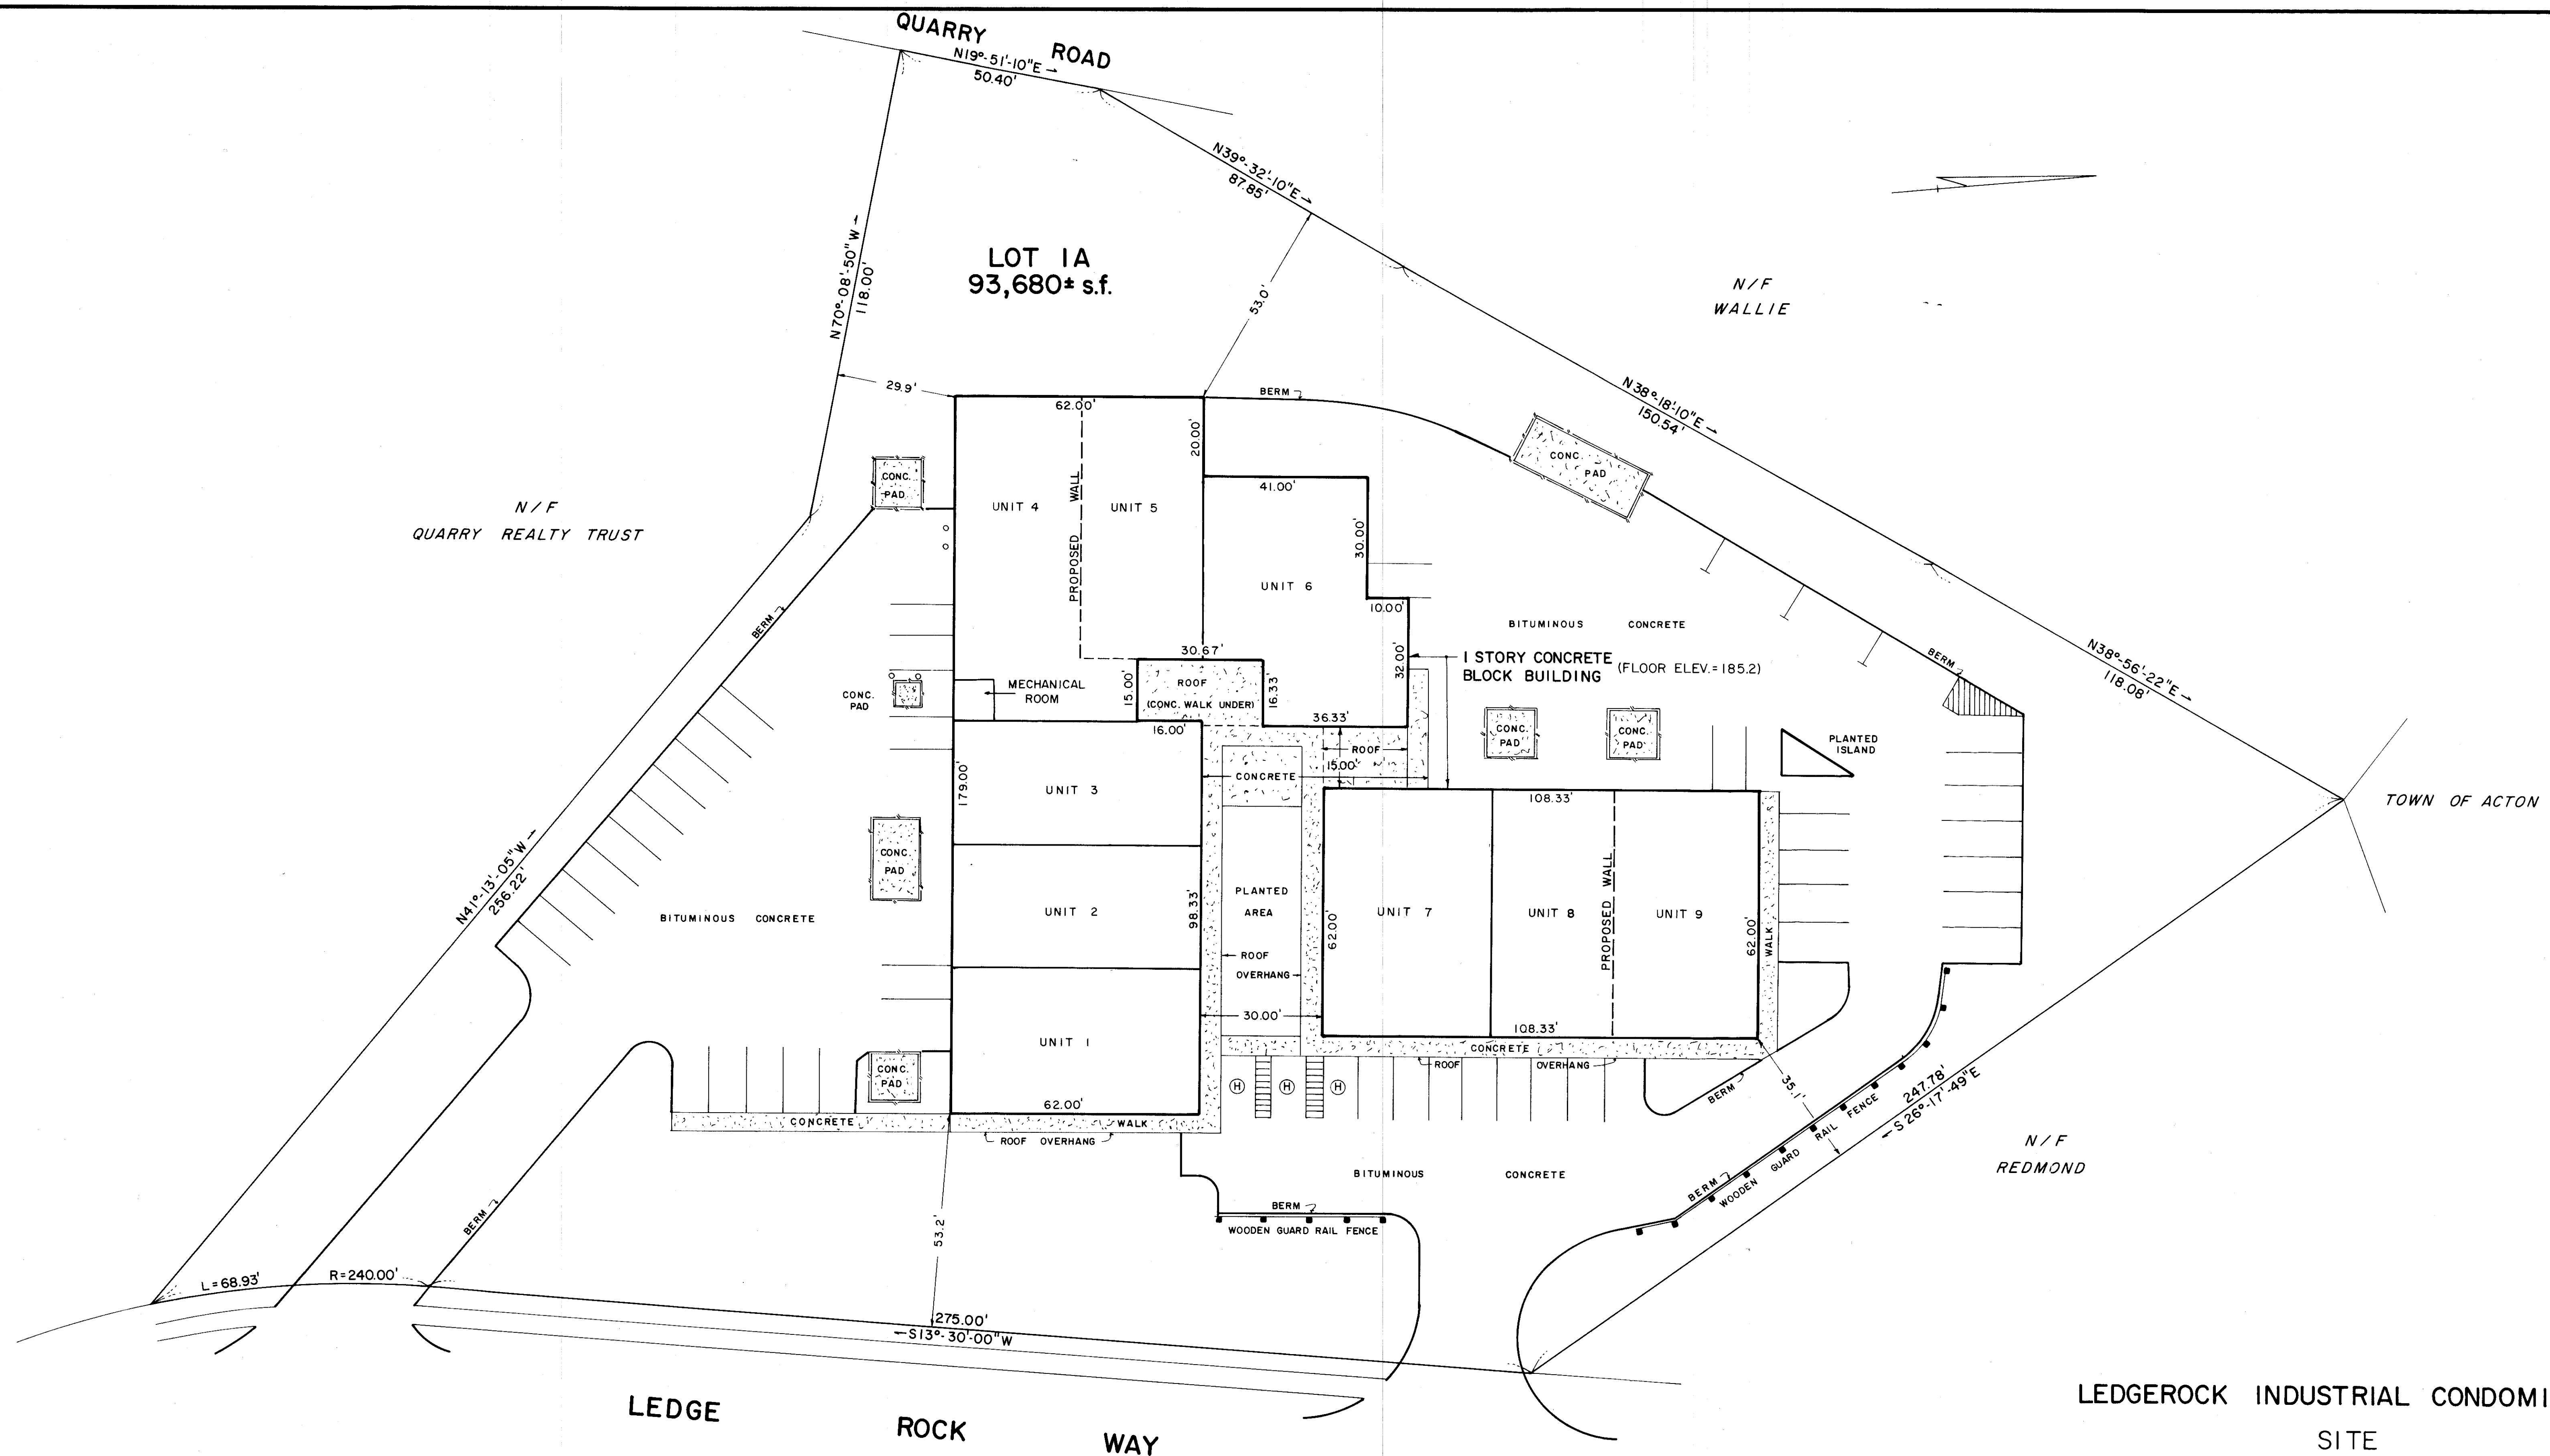

I CERTIFY THAT THIS PLAN SHOWS THE PROPERTY LINES THAT ARE THE LINES OF EXISTING OWNERSHIPS, AND THE LINES OF STREETS AND WAYS SHOWN ARE THOSE OF PUBLIC OR PRIVATE STREETS OR WAYS ALREADY ESTABLISHED, AND THAT NO NEW LINES FOR DIVISION OF OWNERSHIP OR FOR NEW WAYS ARE SHOWN, AND THAT THIS PLAN HAS BEEN PREPARED IN CONFORMITY WITH THE RULES AND REGULATIONS OF THE REGISTERS OF DEEDS OF THE COMMONWEALTH OF MASSACHUSETTS.

7 JAN 91
DATE
William F. McNary
REG. PROFESSIONAL LAND SURVEYOR

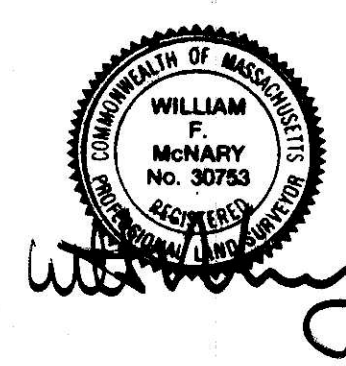

LEDGEROCK INDUSTRIAL CONDOMINIUM
SITE
PLAN OF LAND
IN
ACTON, MASS.
(MIDDLESEX COUNTY)

SCALE: 1" = 20' NOV 5, 1990

STAMSKI AND McNARY, INC.
80 HARRIS STREET ACTON, MASS.
ENGINEERING - PLANNING - SURVEYING

