



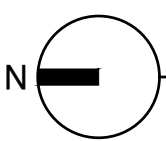


TSARK
ARCHITECTURE

Tsark Architecture, LLC
1990 W. New Haven Ave., Suite 306
Melbourne, Florida 32904

AREA CALCULATIONS
GROSS SQUARE FEET: 13,886
SUITE A SQUARE FEET: 5,772
SUITE B SQUARE FEET: 4,048
SUITE C SQUARE FEET: 1,242
CORE FACTOR SF: 1,705
NET RENTABLE SF: 12,767

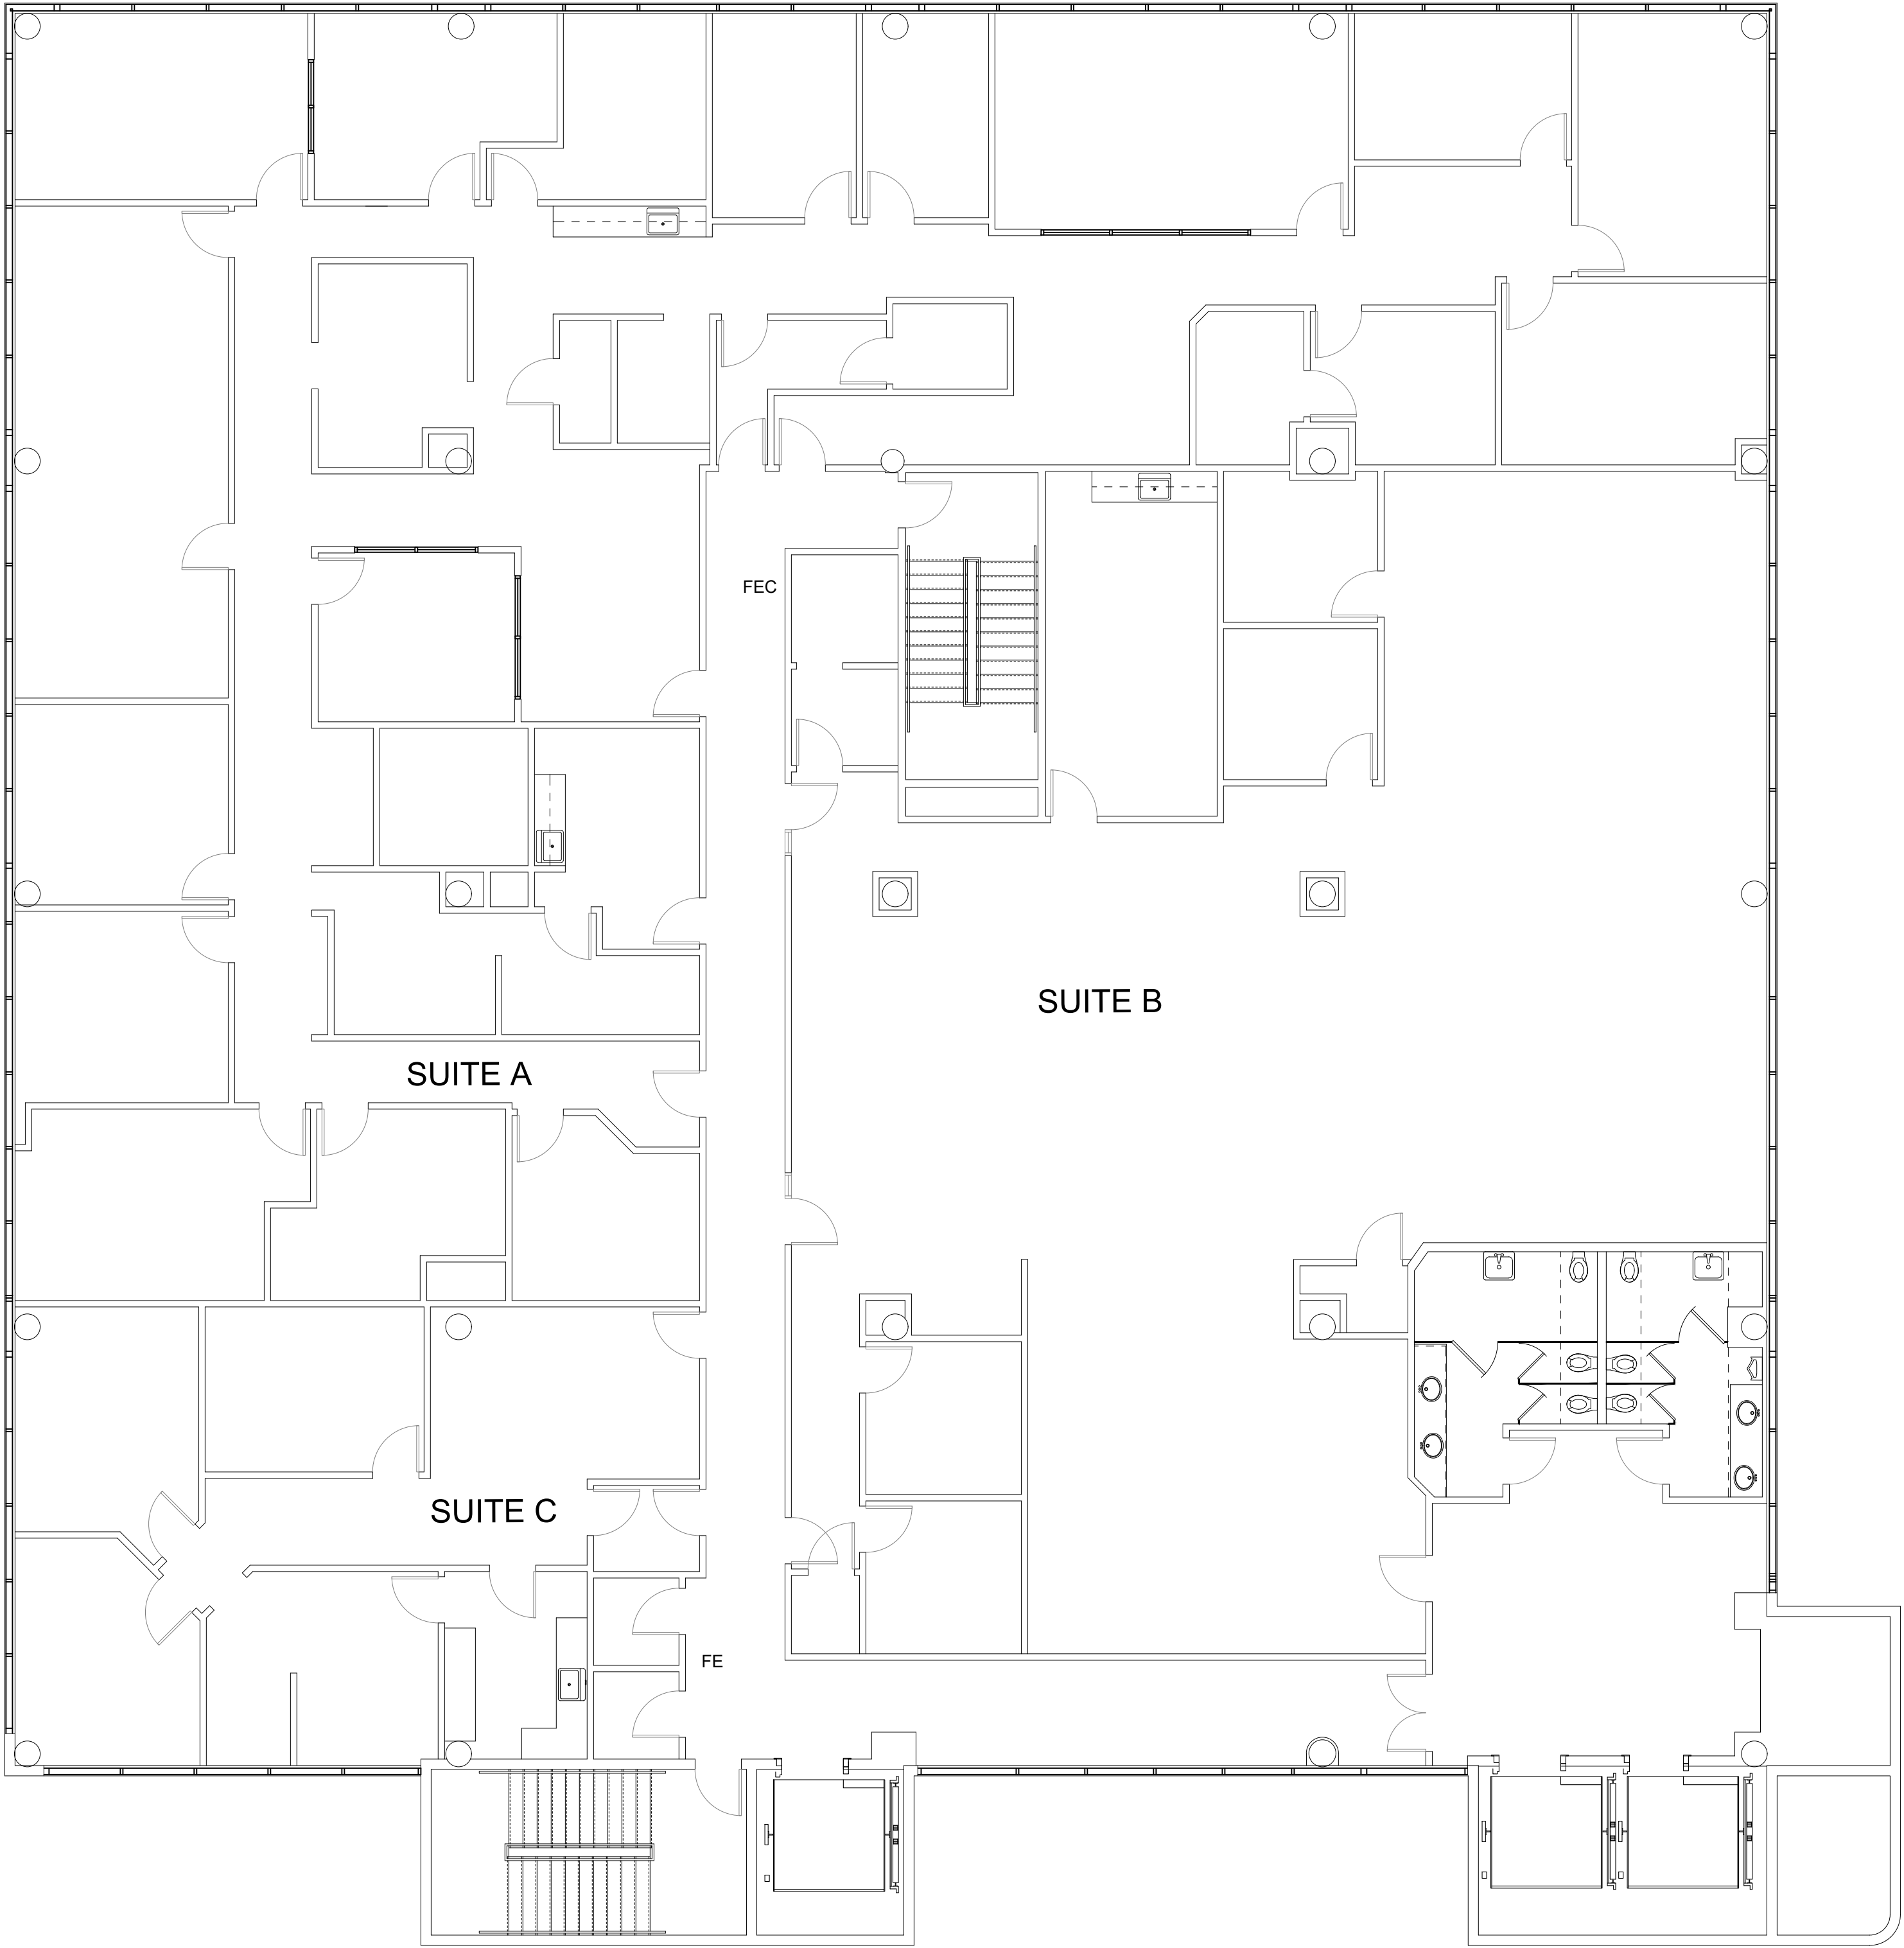

2ND FLOOR PLAN

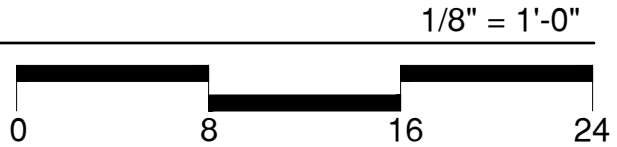

Marina Towers
As-Built drawings
709 S. Harbor City Blvd. Melbourne, FL 32901
Project No.: 20227

SHEET TITLE:
2ND FLOOR PLAN

DATE: 11/5/20
DRAWN BY: CW
REVISION:

A203


Gregory I. Tsark, Architect
AR 93669



TSARK
ARCHITECTURE

Tsark Architecture, LLC
1990 W. New Haven Ave., Suite 306
Melbourne, Florida 32904

AREA CALCULATIONS
GROSS SQUARE FEET: 13,886
SUITE A SQUARE FEET: 5,281
SUITE B SQUARE FEET: 5,764
CORE FACTOR SF: 1,714
NET RENTABLE SF: 12,759

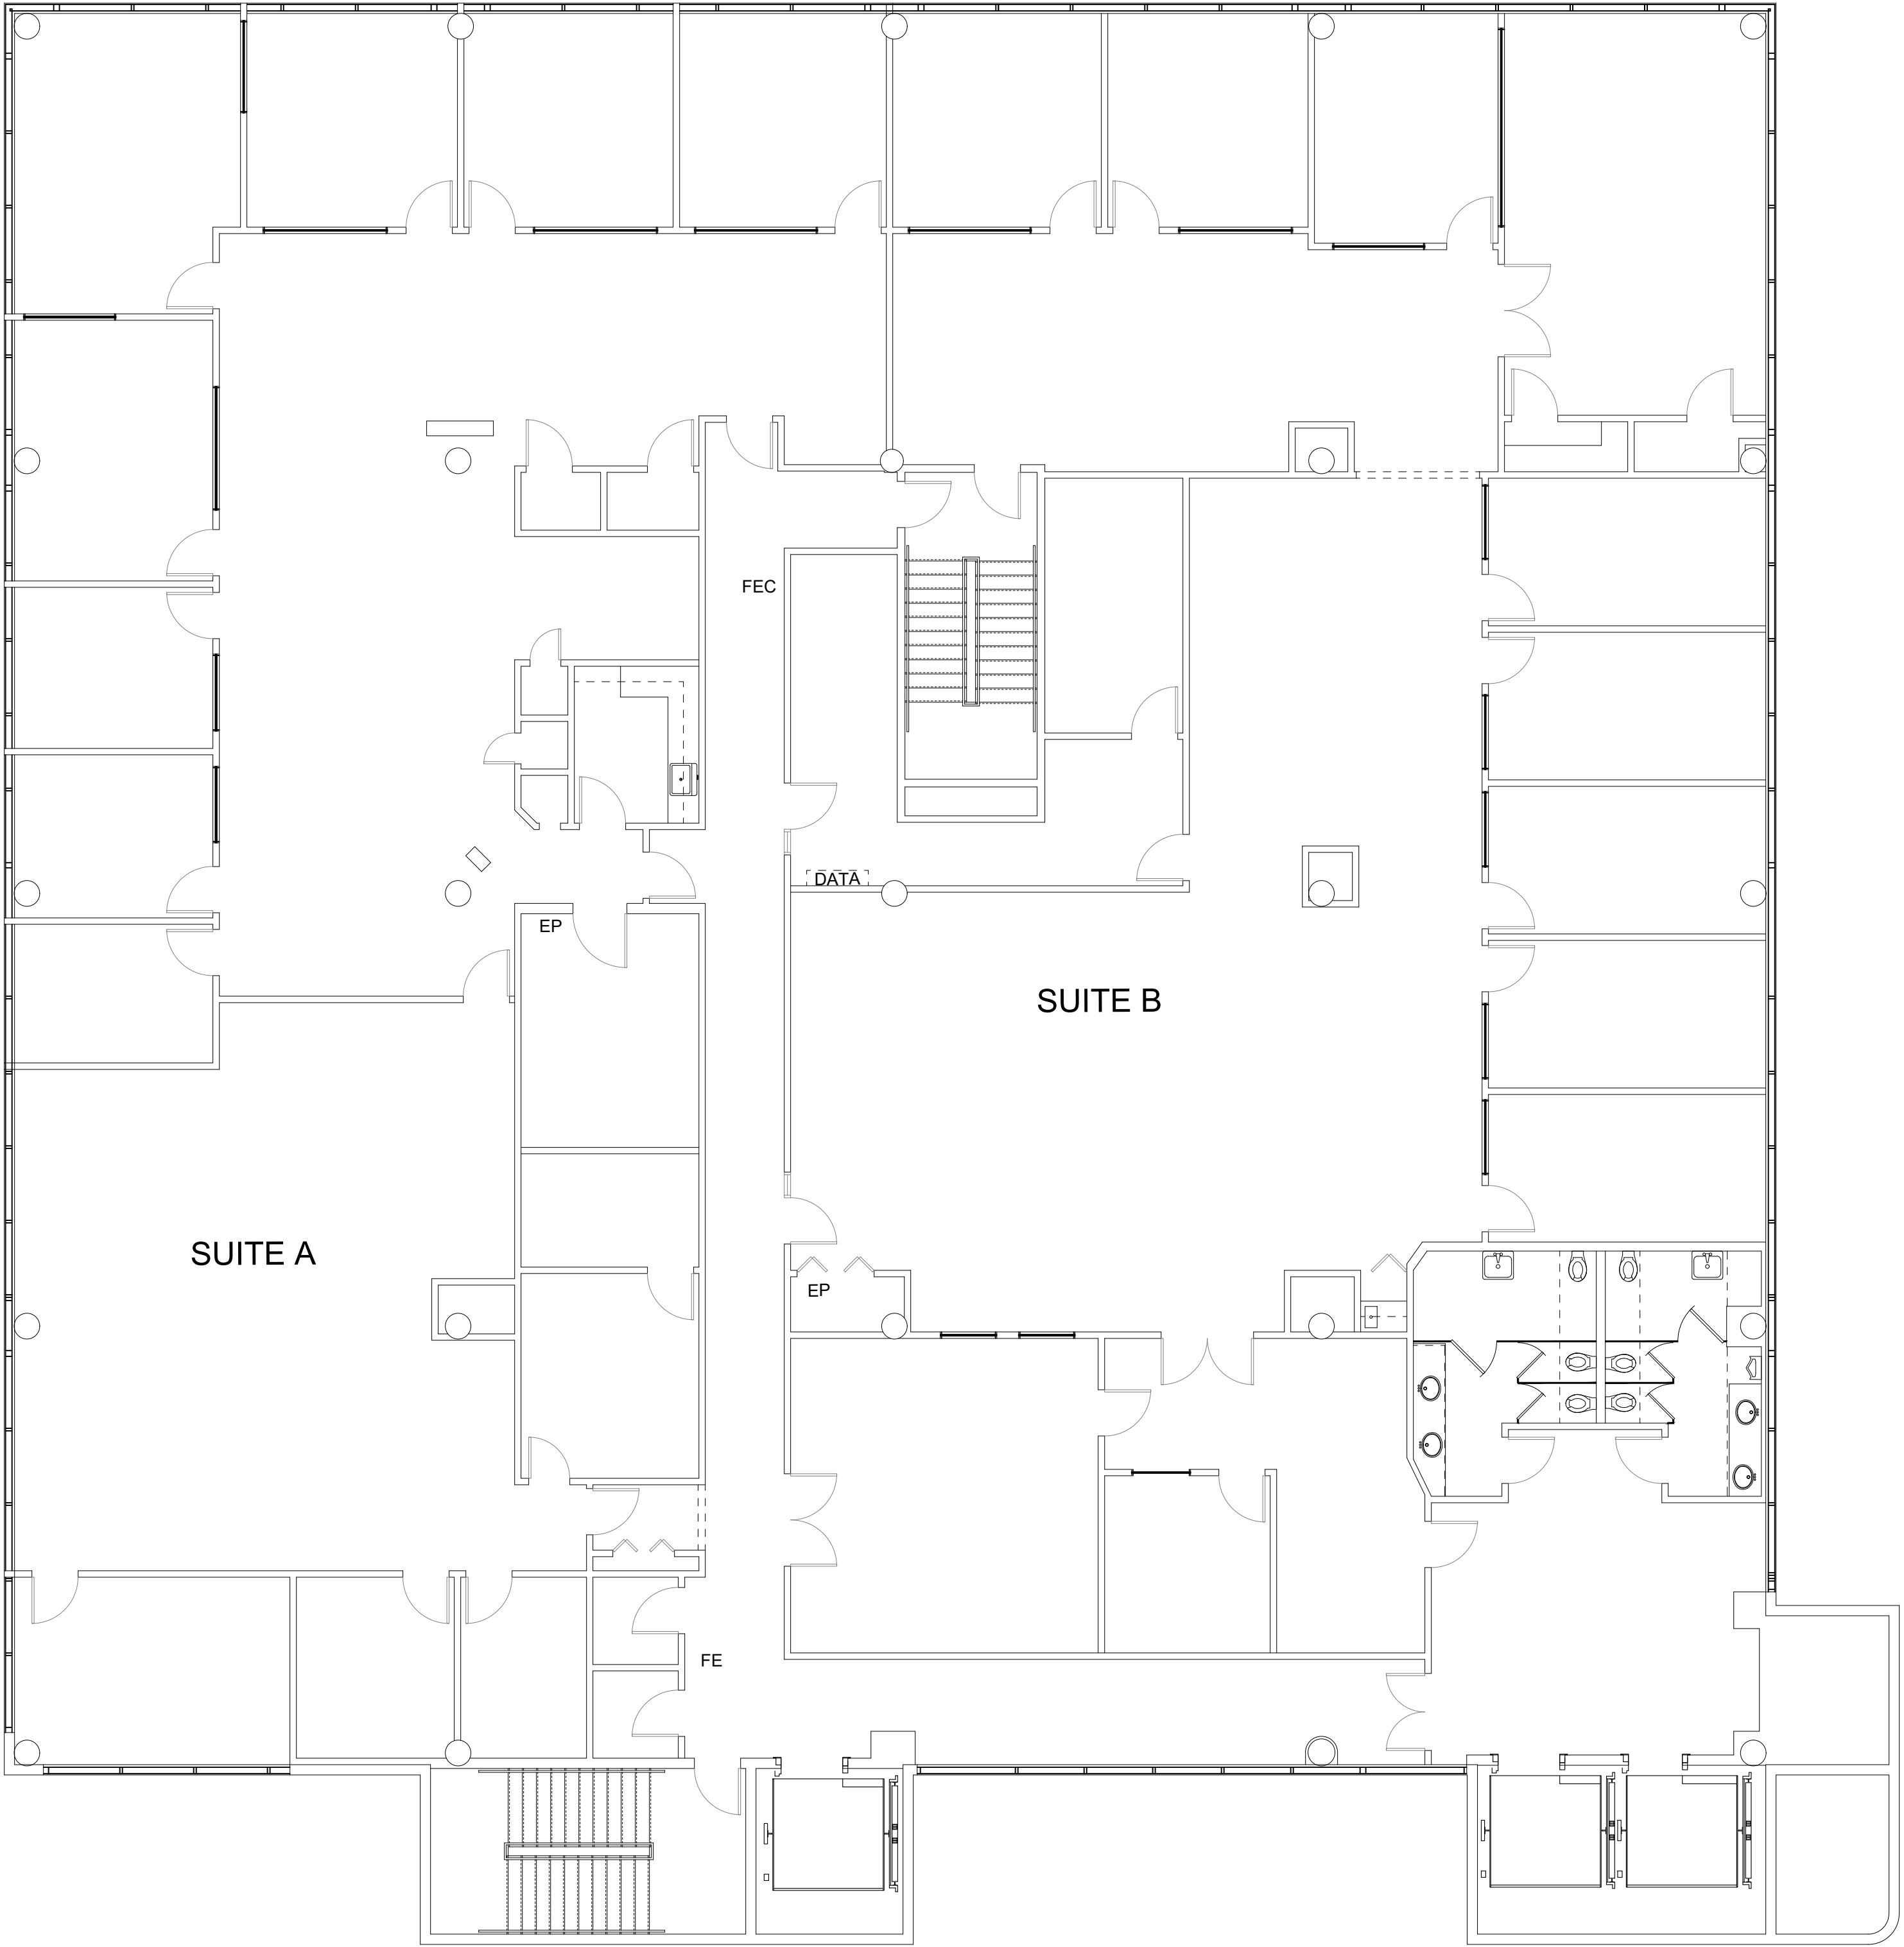

3RD FLOOR PLAN

Marina Towers
As-Built drawings
709 S. Harbor City Blvd. Melbourne, FL 32901
Project No.: 20227

SHEET TITLE:
3RD FLOOR PLAN

DATE: 11/5/20
DRAWN BY: CW
REVISION:

A204

Gregory I. Tsark, Architect
AR 93669