
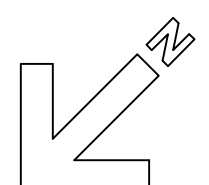


BUILDING 3 MARKETING PLAN

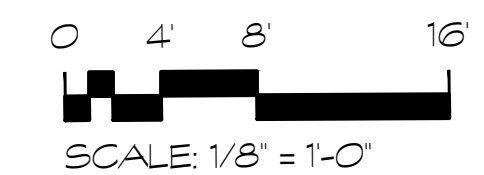

13,220 SF. BUILDING
FOR LEASE
2105 SADAU COURT, BUILDING 3
DENTON, TEXAS

Copyright © 2019
Space Planning Specialists
These drawings, or parts
thereof, may not be
reproduced in any form,
by any method, for any
purpose, without prior
written consent from
Space Planning Specialists

SPACE PLANNING SPECIALISTS
COMMERCIAL SPACE
PLANNING & INTERIOR DESIGN
Telephone: 972/414-9391
Fax: 972/414-0997

SCALE: 1/8" = 1'-0"
ON 24" X 36" SHEET
JOB:
ISSUE DATES:
10/14/2019
FOR MARKETING

As Built for Marketing
Not for Construction,
Permitting or
Regulatory Approval.
10/14/2019