


32432 DEQUINDRE

WARREN, MI


3,071 USABLE SQUARE FOOTAGE

612 OFFICE

2,459 WAREHOUSE

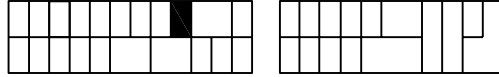

VICINITY MAP

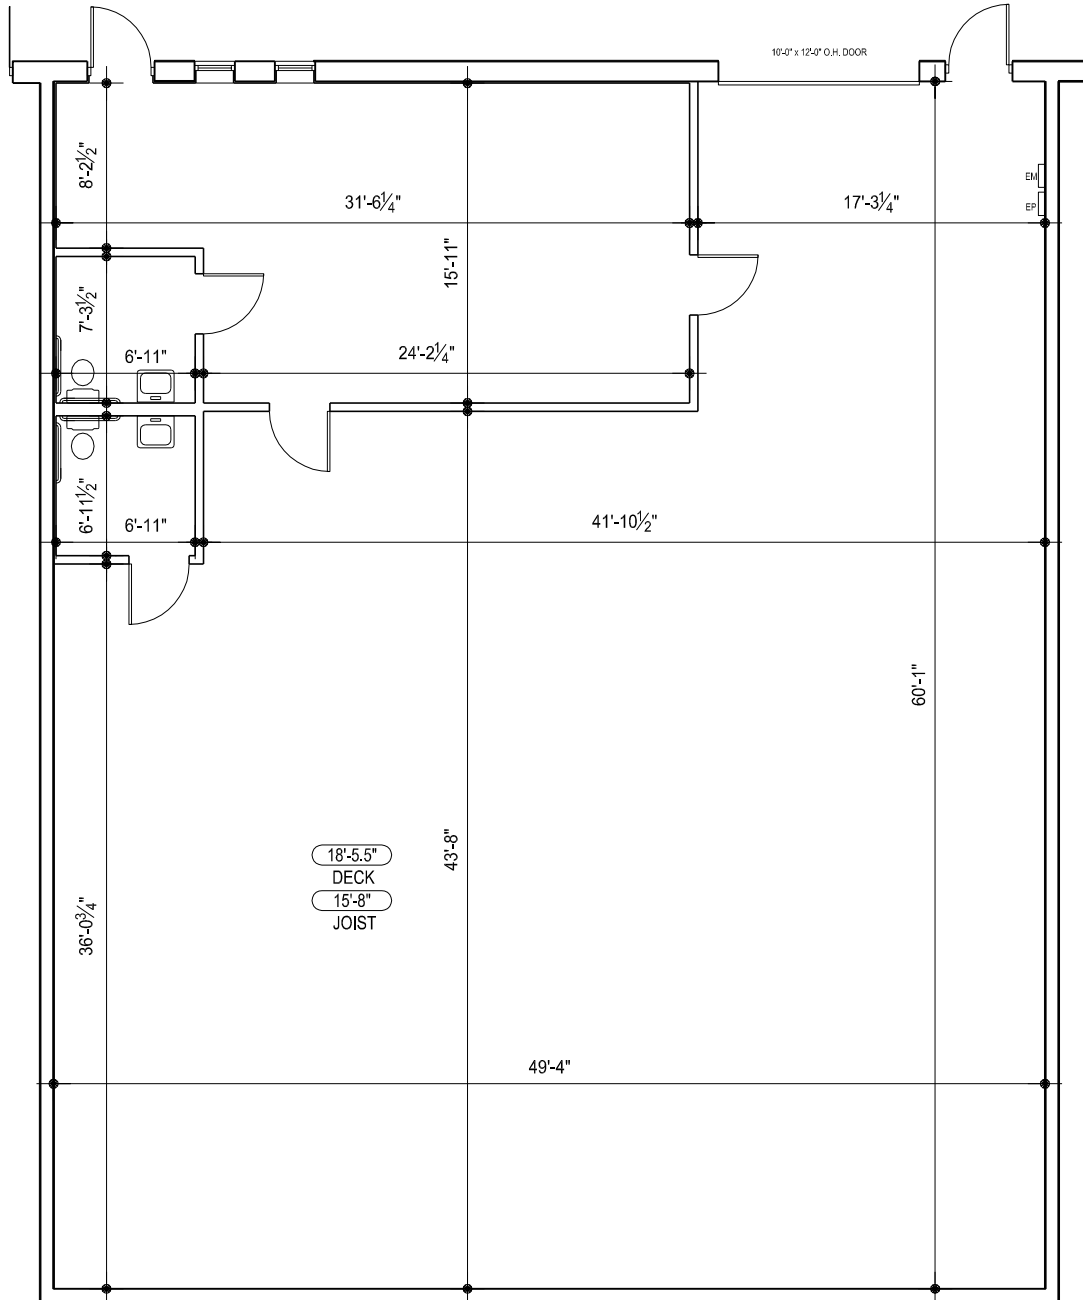

AS BUILT FLOOR PLAN