


**ROUTE 67 BAR AND GRILL**

1380 HWY 67 ALVARADO TX

AS-BUILT FLOOR PLAN

PROJECT NO:	#
ISSUE DATE:	06-02-21
REV 1:	
REV 2:	

A100

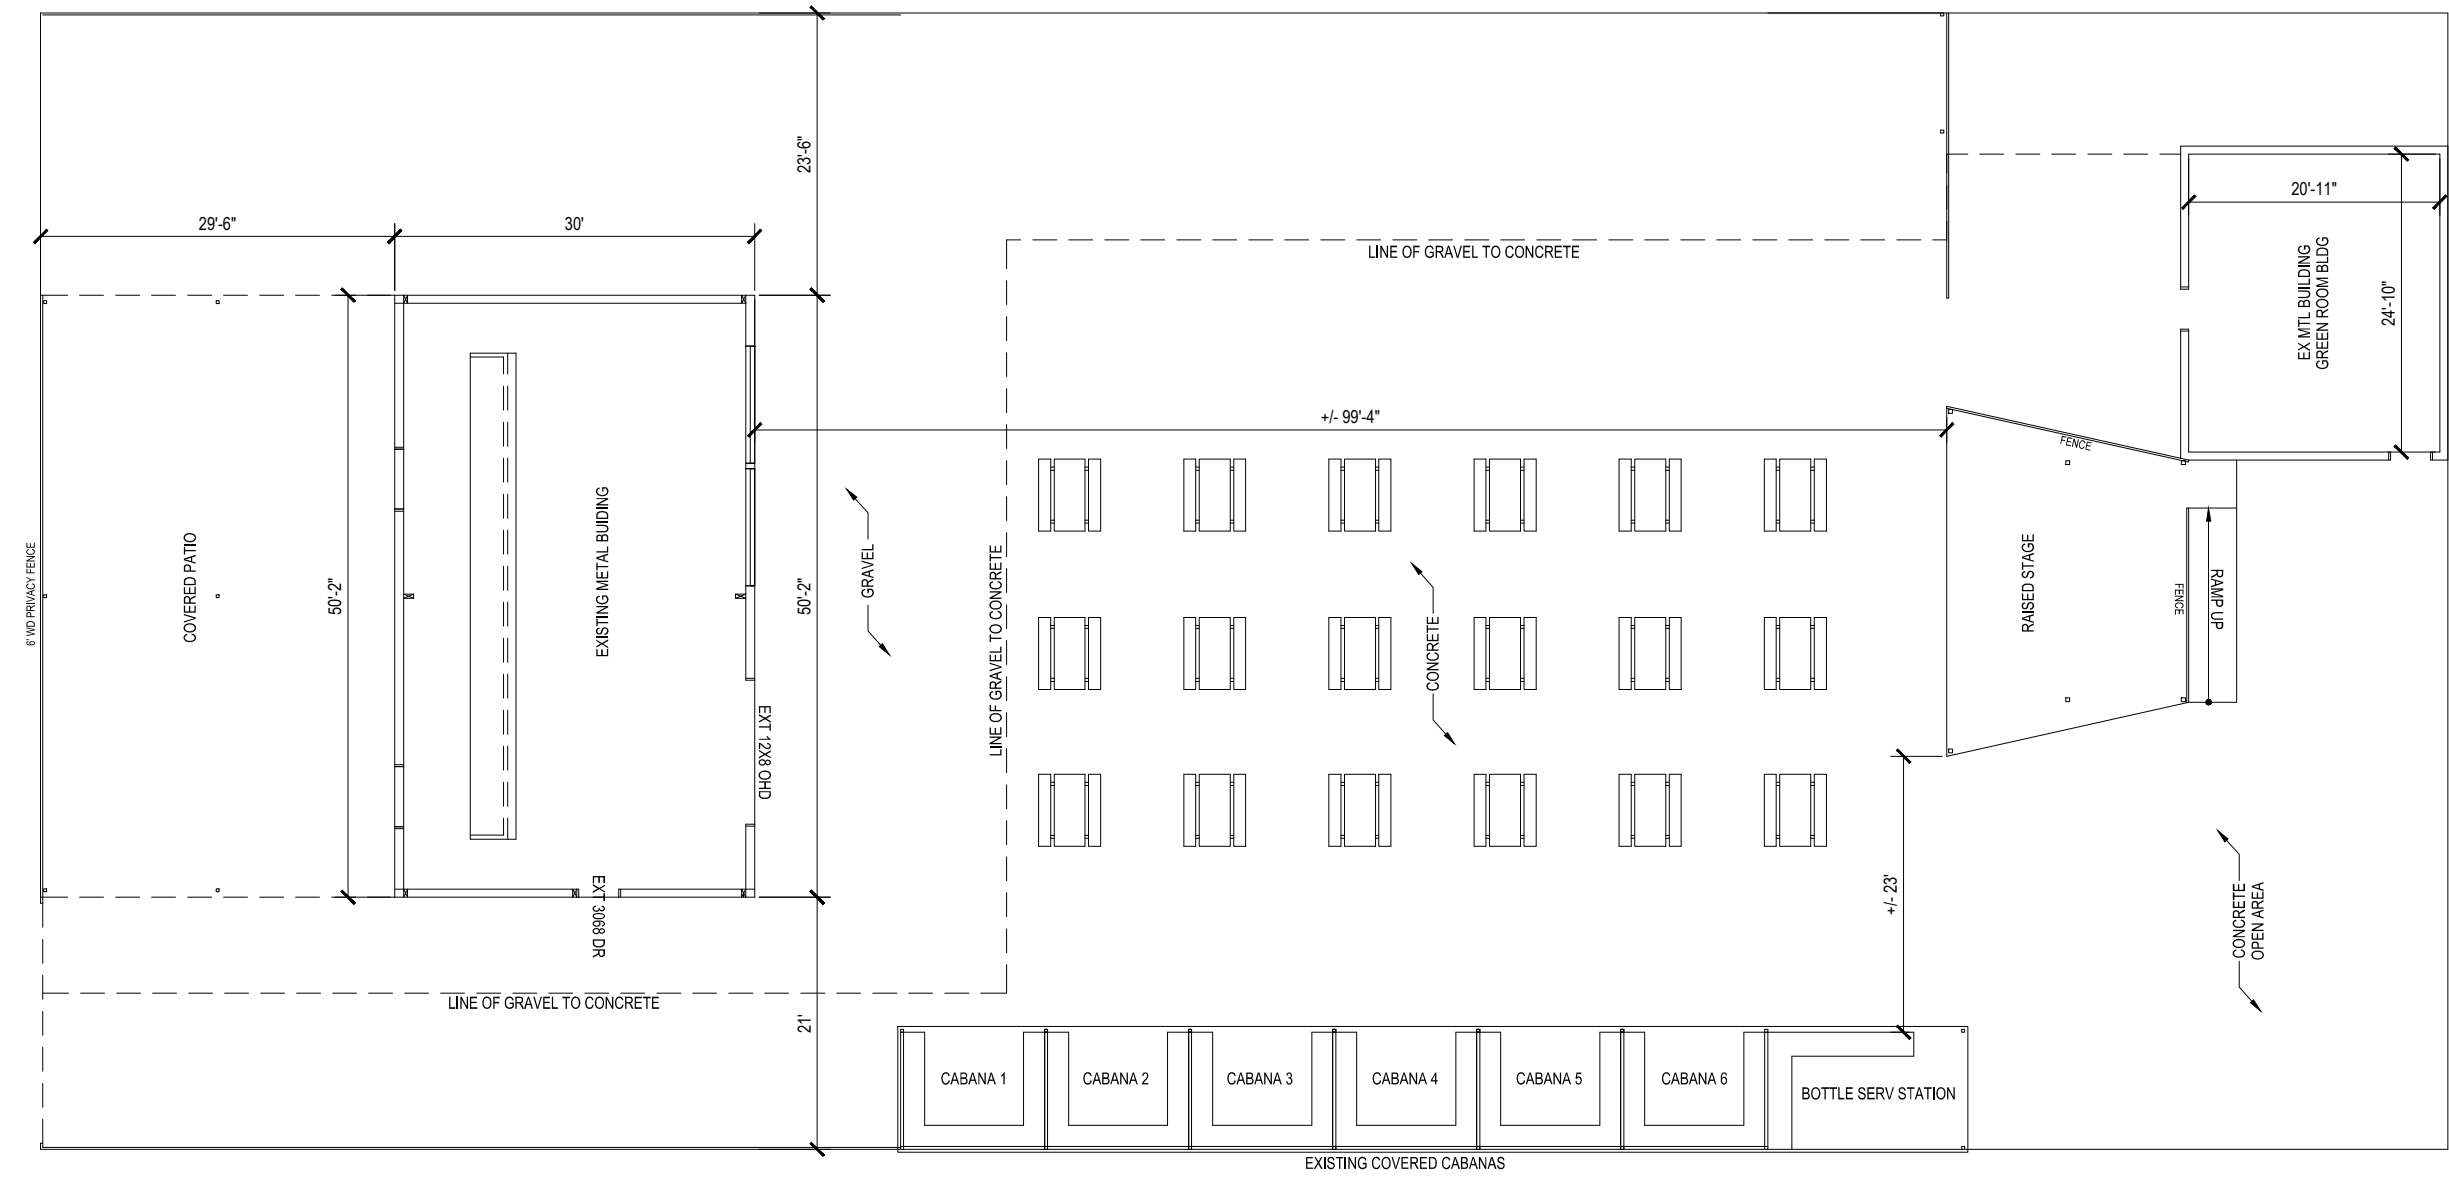

**1 AS-BUILT SITE PLAN**  
Scale: 1/16" = 1'-0"