


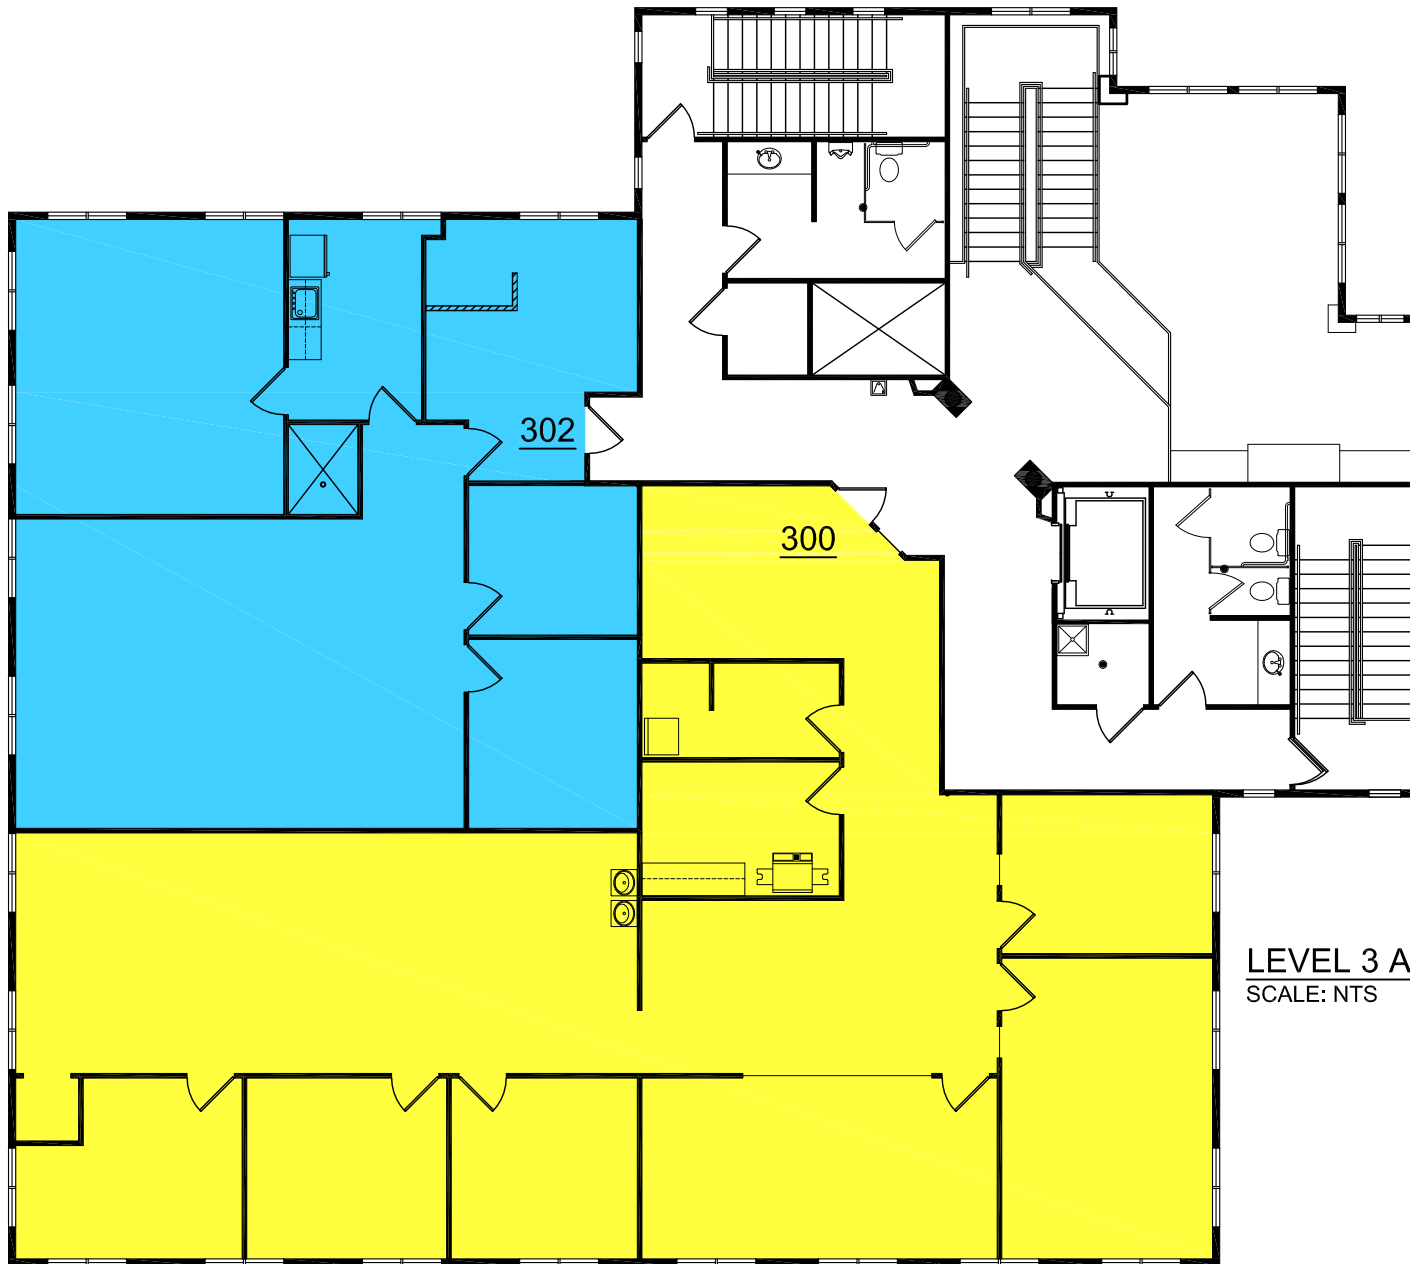

LEVEL 3 AS-BUILT PLAN
SCALE: NTS

