


1
A2.1

FLOOR PLAN - PRELIMINARY

SCALE: 1/4" = 1'-0"

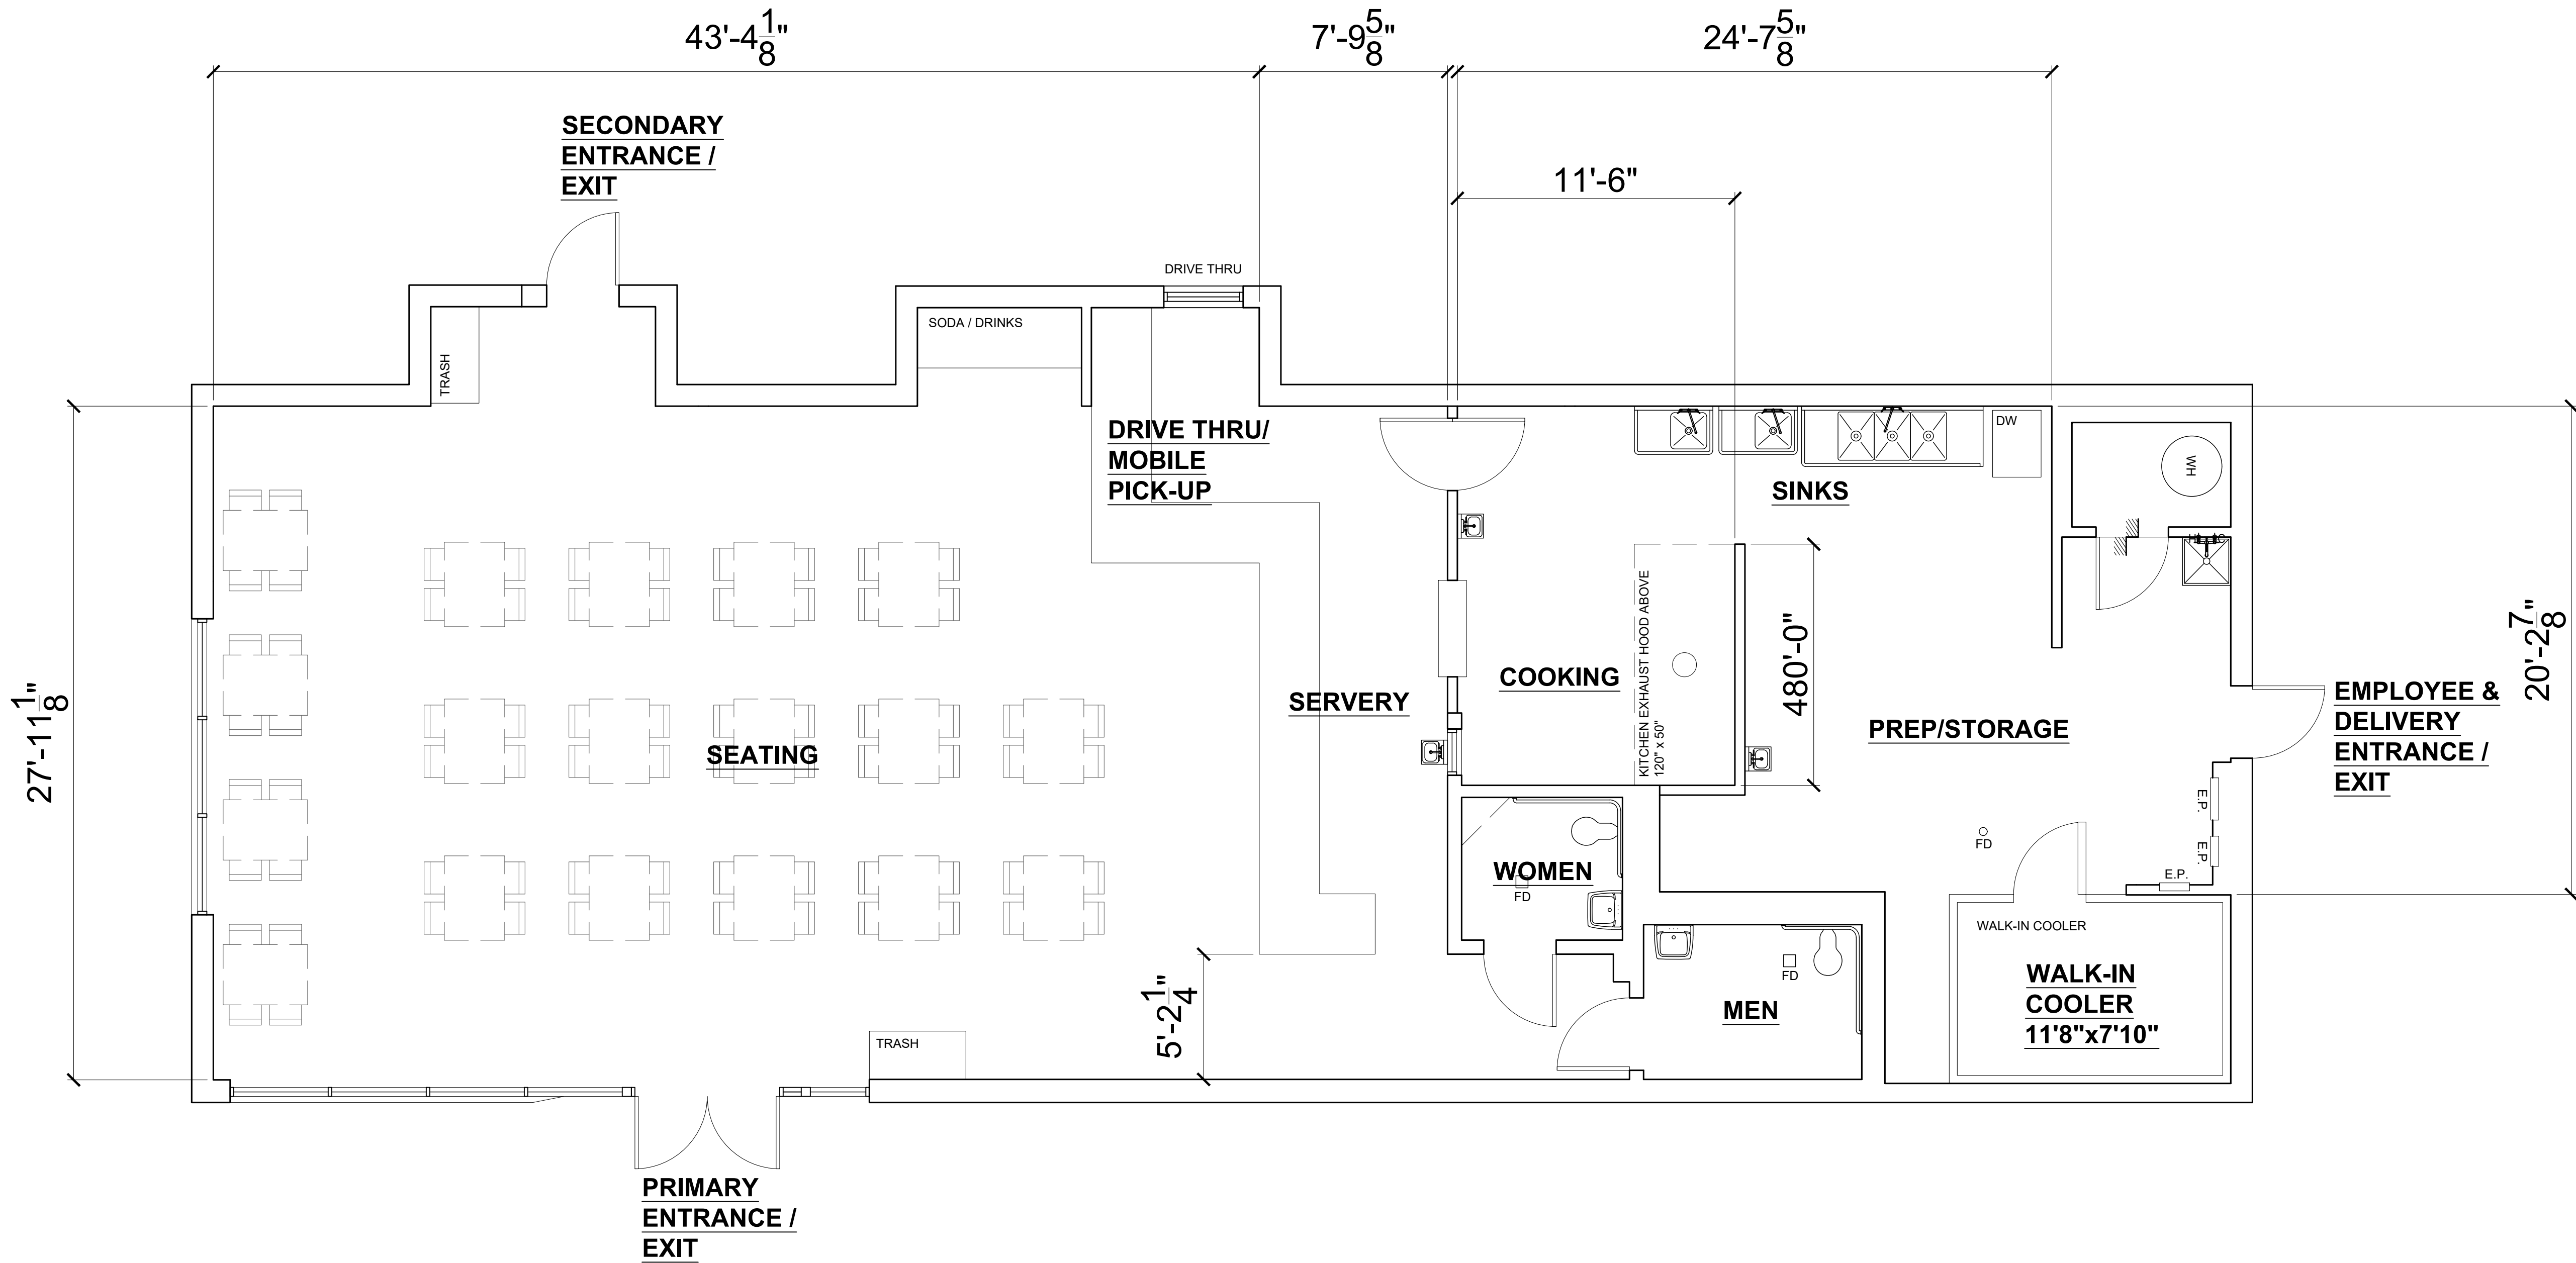

REVISIONS		DATE
NO		

COPYRIGHT
THIS DRAWING AND ALL
REPRODUCTIONS ARE
THE PROPERTY OF
ALL ARCHITECTURE, LLC AND
MAY NOT BE USED IN ANY WAY
WITHOUT THEIR PERMISSION.

PROJECT TITLE:
**4346 FULTON INDUSTRIAL BLVD
AS-BUILTS**
4346 FULTON INDUSTRIAL BLVD SW
ATLANTA, GEORGIA 30336

SEAL:

PRELIMINARY

DRAWN: JCA	CHECKED: JCA
APPROVED: JCA	ISSUE DATE: 01/25/24

CAD FILE NAME:
24001.dwg

SHEET TITLE:
**PRELIMINARY
FLOOR PLAN**

PROJECT NUMBER:
24001

SHEET NO:

A2.1
SHEET 2 OF 2

ALL Architecture, LLC
2052 CHRYSLER DRIVE NE, ATLANTA, GA 30345
TELEPHONE: (404) 316-2896
E-MAIL: INFO@ALLARCHILLC.COM