


VICINITY MAP
SCALE: 1" = 1000'

FOR REGISTRY USE ONLY

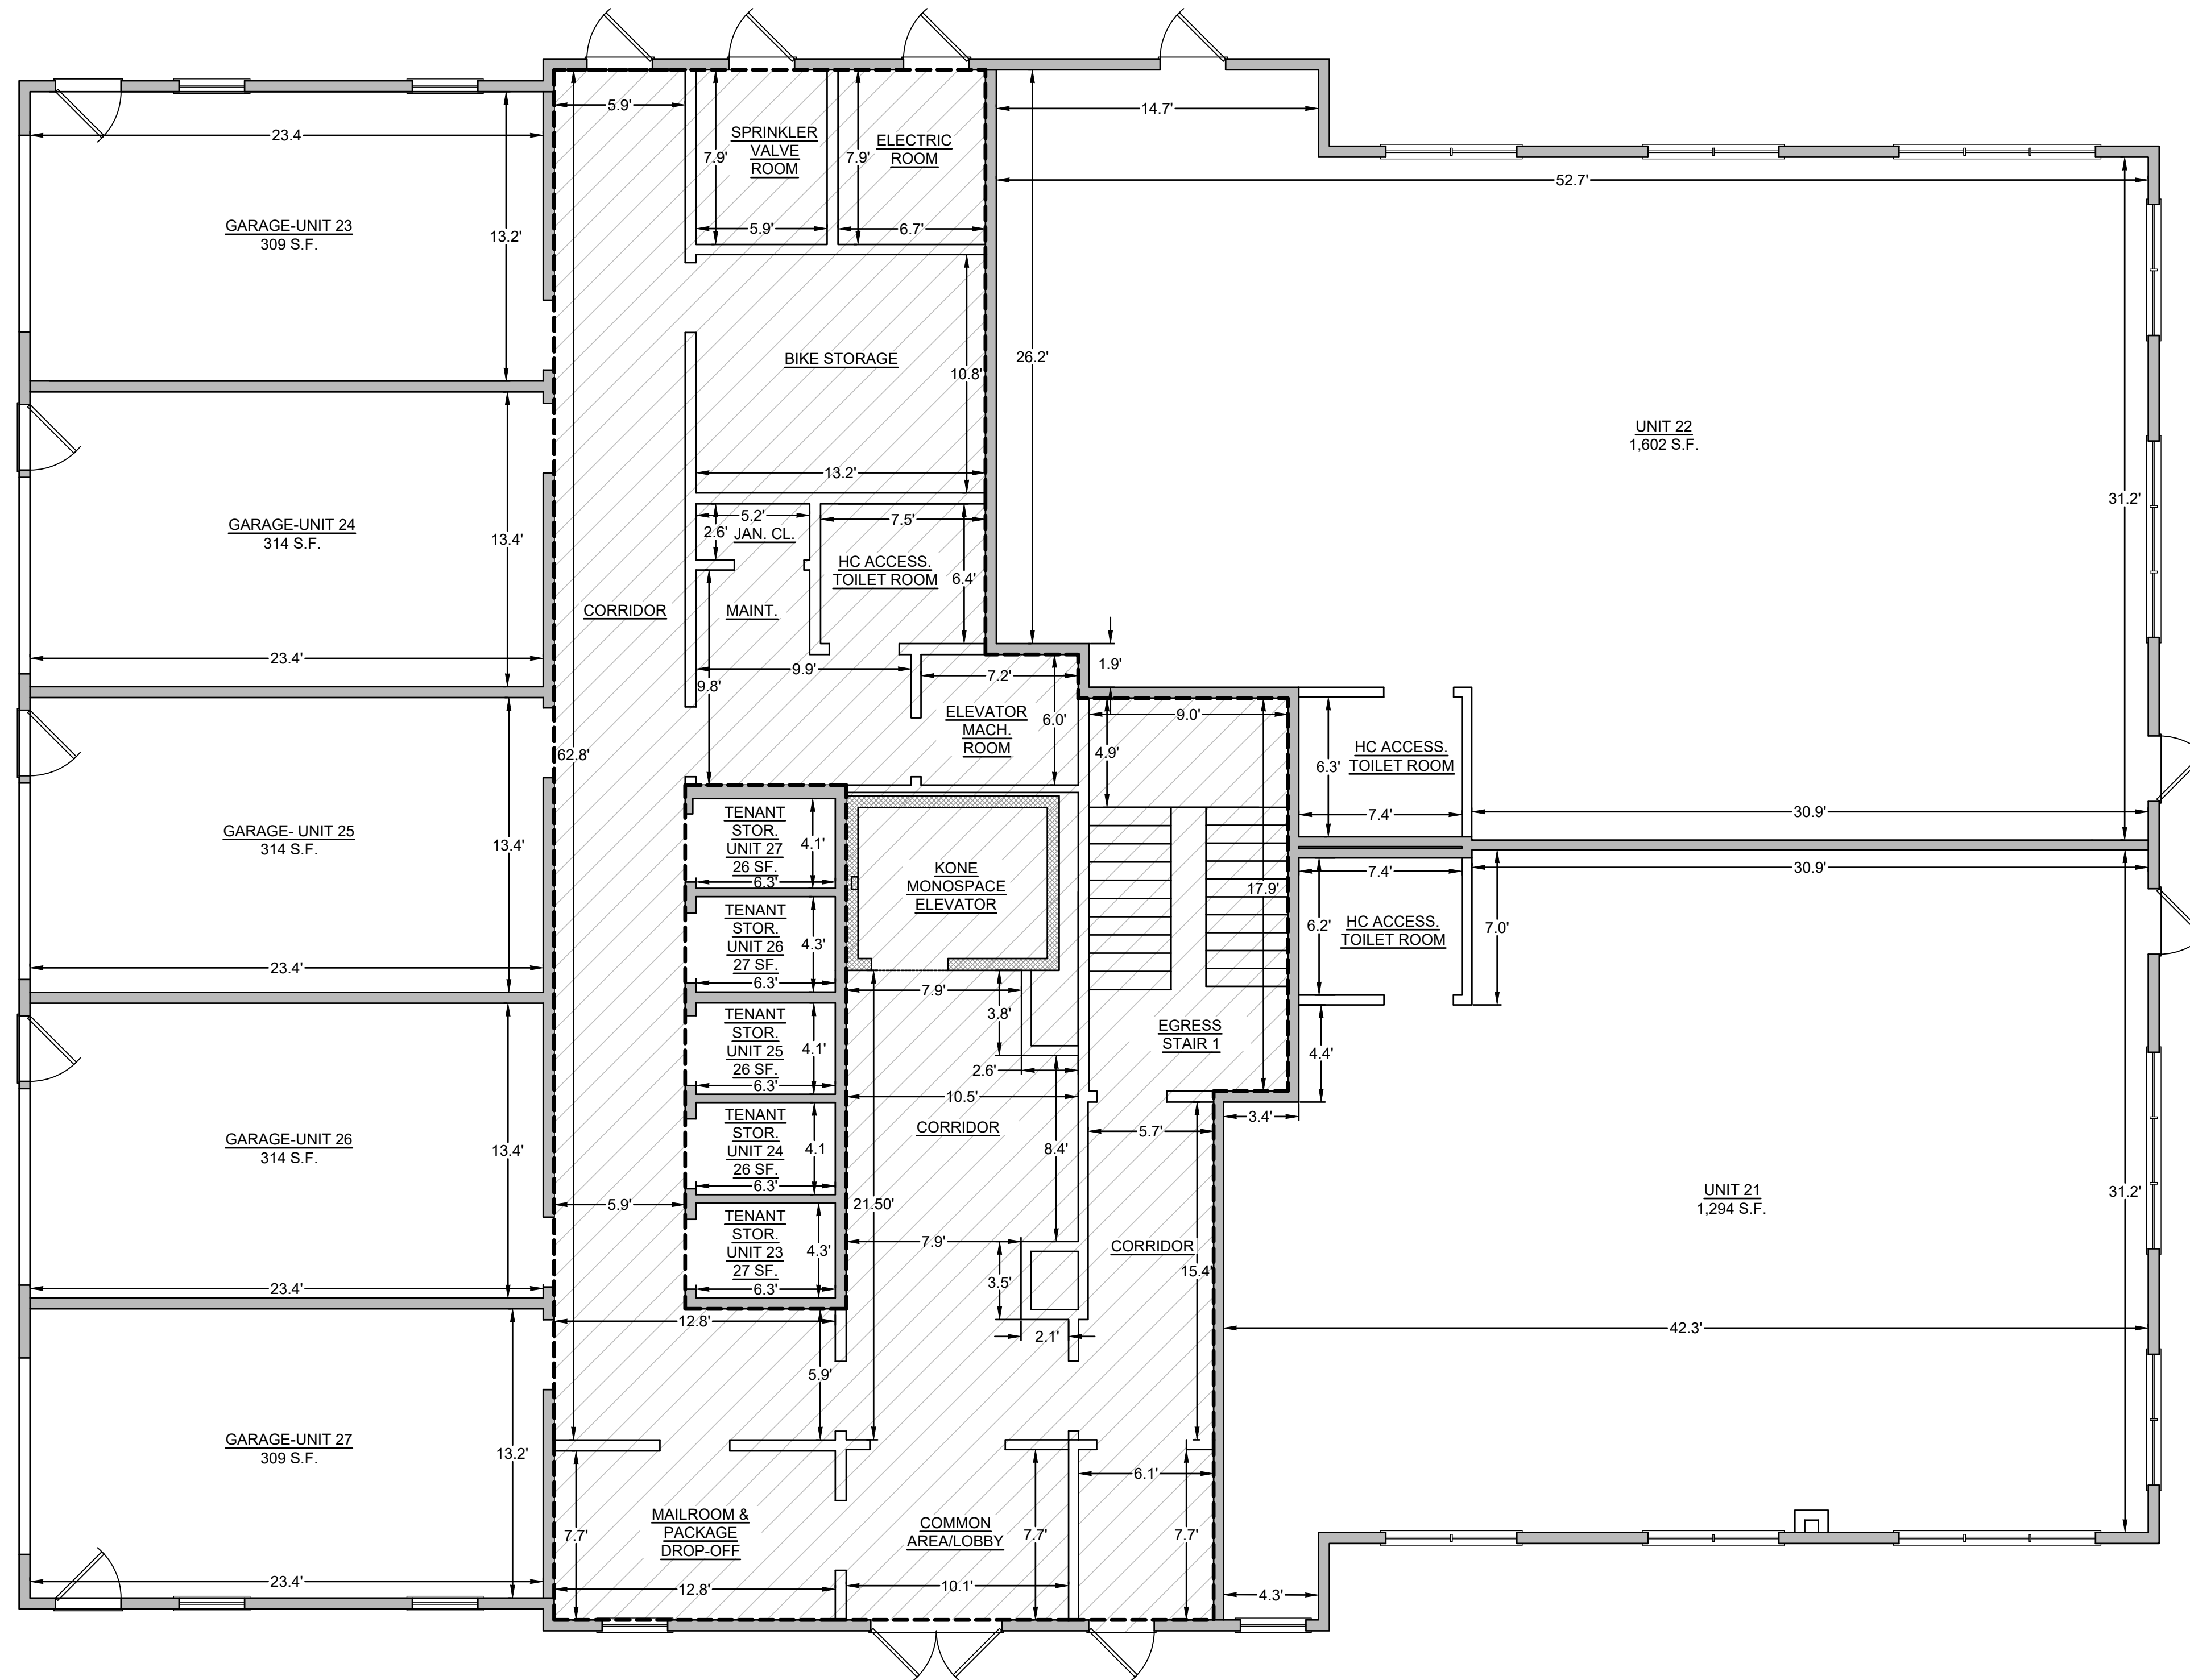

FIRST FLOOR PLAN
SCALE: 1" = 5'

ABBREVIATIONS

- W.I.C. WALK IN CLOSET
- S.F. SQUARE FEET
- LAUN. LAUNDRY
- SHOW. SHOWER
- CLOS. CLOSET
- P.D.R. POWDER ROOM
- COMMON AREA

UNIT AREA SUMMARY

	GROUND FLOOR	SECOND FLOOR	THIRD FLOOR	TOTAL
UNIT 21	1,294 S.F.	-	-	1,294 S.F.
UNIT 22	1,602 S.F.	-	-	1,602 S.F.
UNIT 23	336 S.F.	1,302 S.F.	686 S.F.	2,324 S.F.
UNIT 24	340 S.F.	1,539 S.F.	685 S.F.	2,564 S.F.
UNIT 25	340 S.F.	1,102 S.F.	1,079 S.F.	2,521 S.F.
UNIT 26	341 S.F.	1,490 S.F.	1,047 S.F.	2,878 S.F.
UNIT 27	335 S.F.	-	2,044 S.F.	2,379 S.F.

I HEREBY CERTIFY THAT THIS PLAN HAS BEEN PREPARED IN CONFORMANCE WITH THE RULES AND REGULATIONS OF THE REGISTERS OF DEEDS.

I CERTIFY THAT THIS PLAN ACCURATELY AND FULLY DEPICTS THE AS-BUILT LAYOUT, LOCATION, UNIT NUMBER, DIMENSIONS, AND APPROXIMATE AREA OF THE UNITS AND DEPICTS THE MAIN ENTRANCE AND IMMEDIATE COMMON AREA TO WHICH THEY HAVE ACCESS.

DATE _____ ROBERT S. REGO, P.E.

**MARKET PLACE II CONDOMINIUM
PHASE III AS-BUILT UNIT PLANS
UNITS 21-27**

LOCATED AT
2 PROPRIETOR'S WAY
MARSHFIELD, MASSACHUSETTS

PREPARED FOR
AW ASSOCIATES, INC.

DATE: DECEMBER 11, 2025 SCALE: 1" = 5'



PREPARED BY:




RIVER HAWK ENVIRONMENTAL, LLC.
511 WEST GROVE ST., SUITE 301, MIDDLEBOROUGH, MA 02346
(774) 213 - 5429



VICINITY MAP
SCALE: 1" = 1000'

FOR REGISTRY USE ONLY

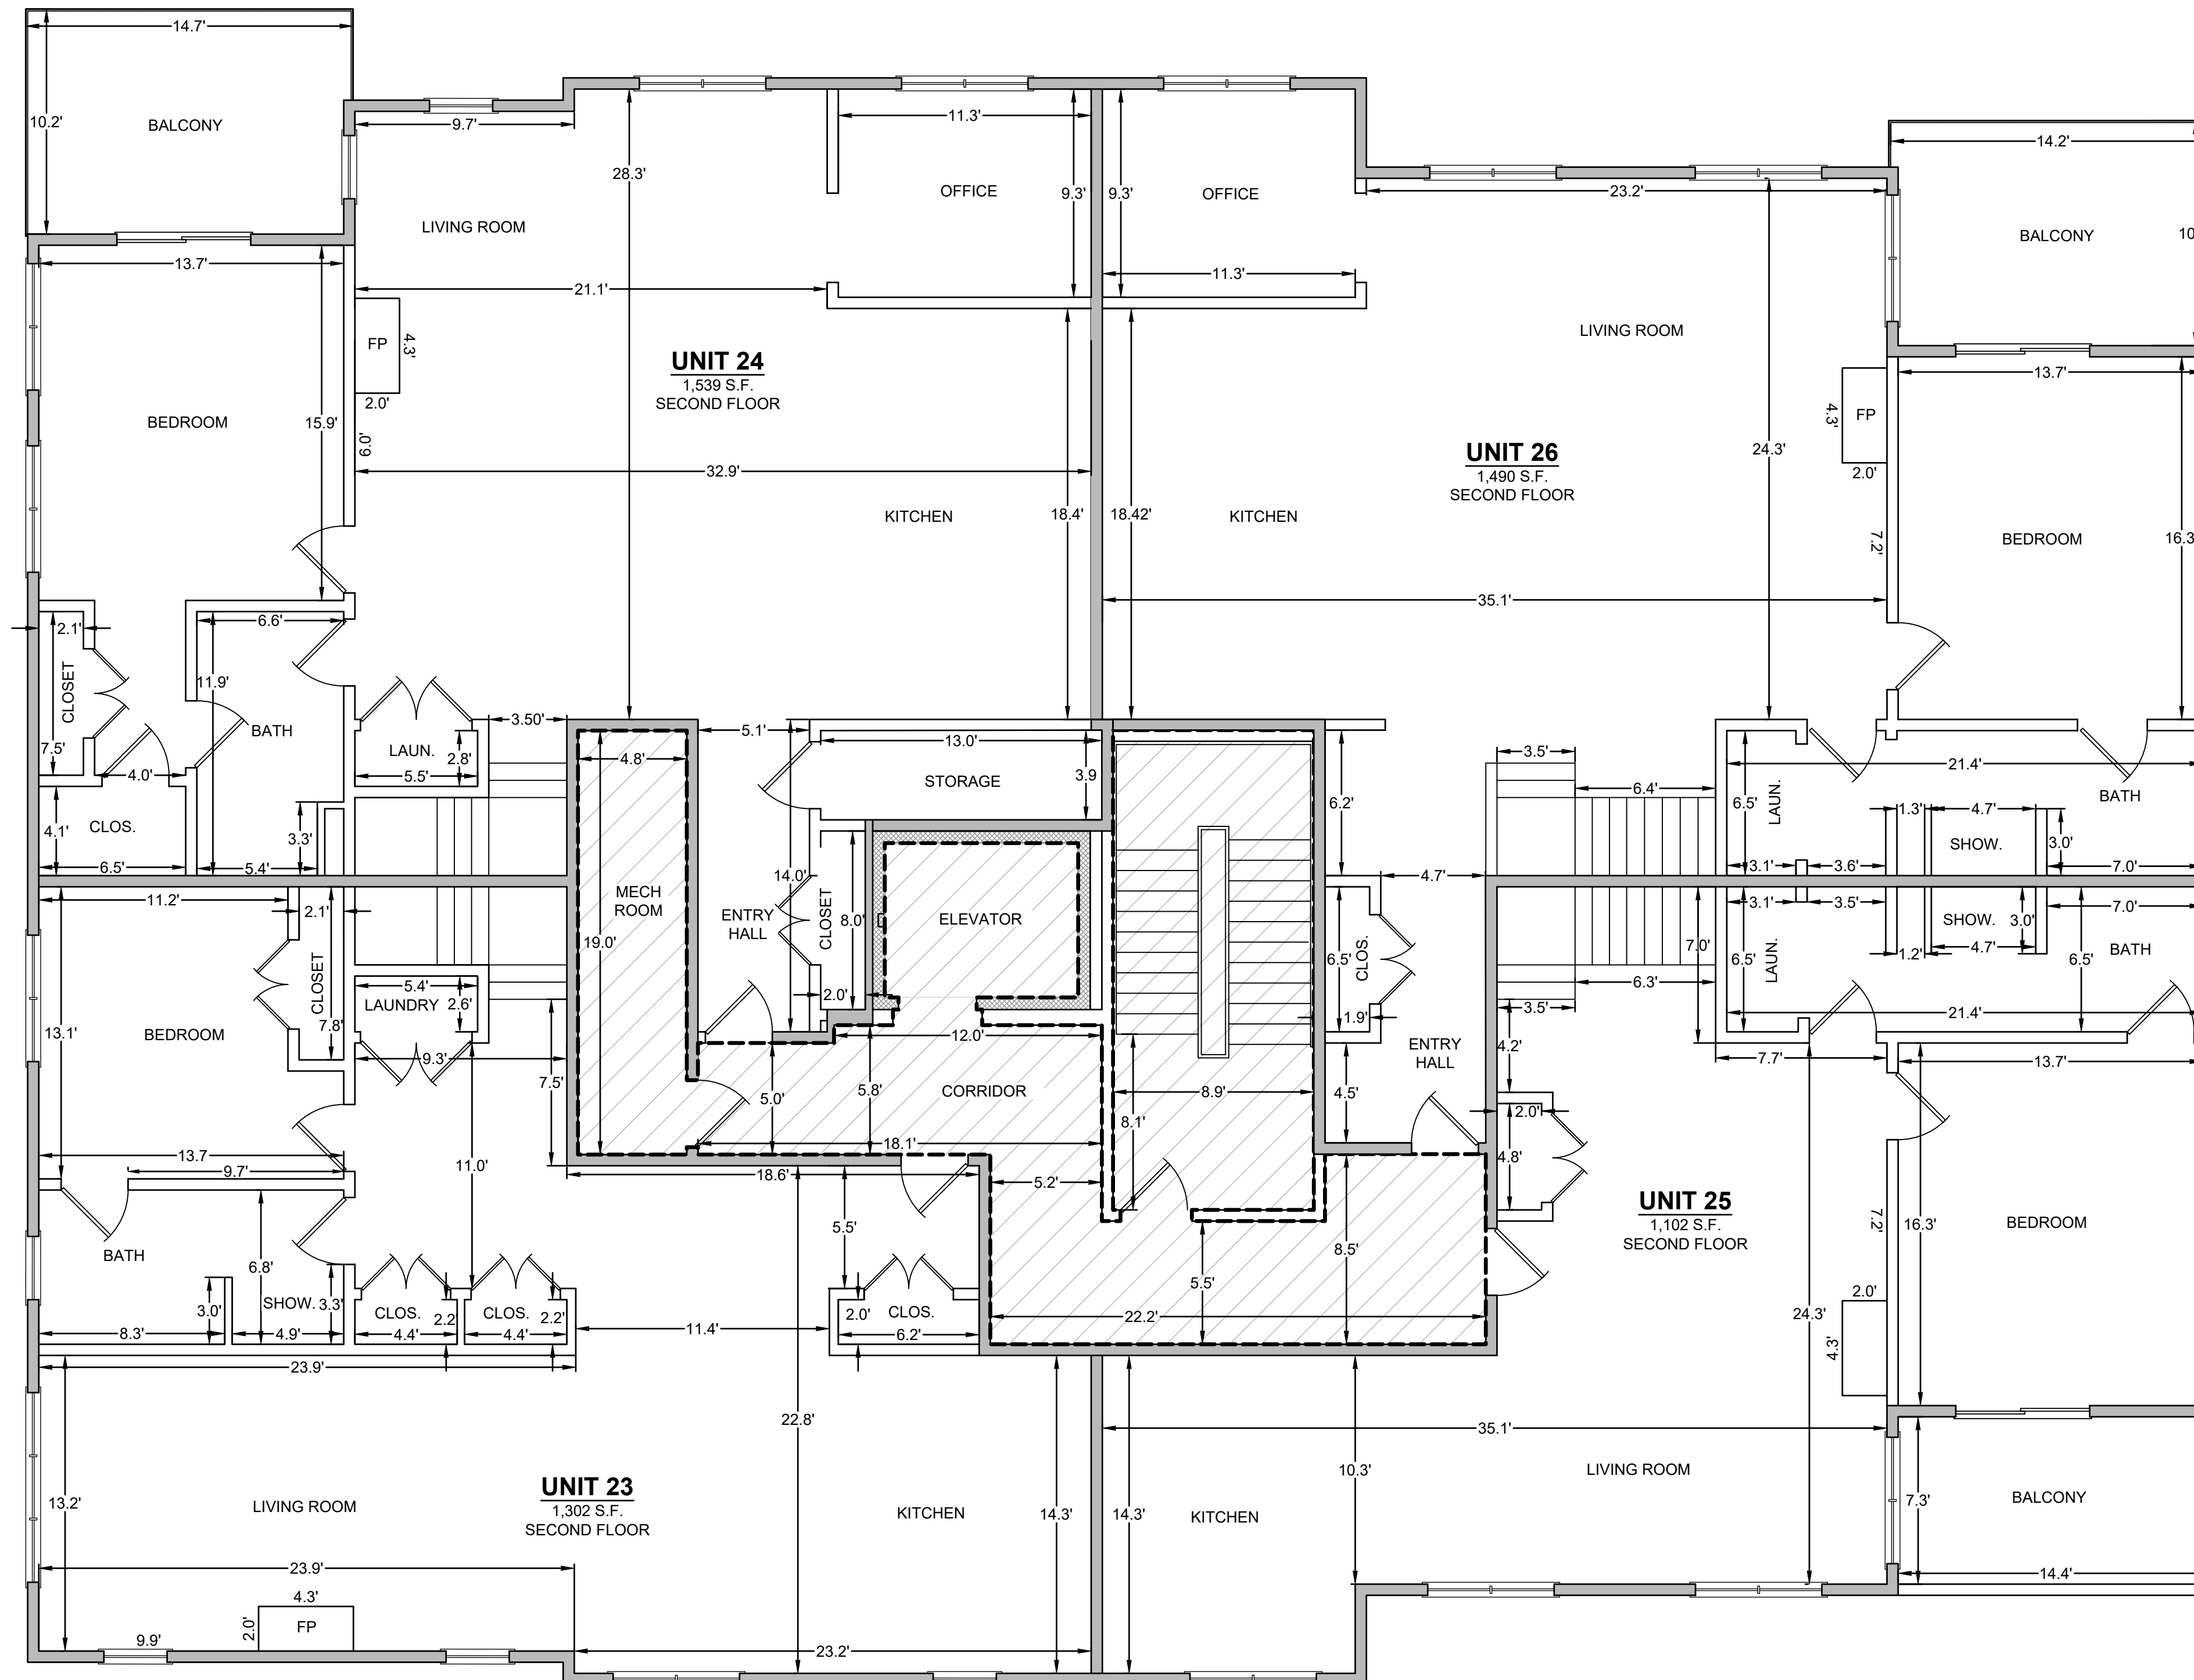

SECOND FLOOR PLAN

SCALE: 1" = 5'

ABBREVIATIONS

- W.I.C. WALK IN CLOSET
- S.F. SQUARE FEET
- LAUN. LAUNDRY
- SHOW. SHOWER
- CLOS. CLOSET
- P.D.R. POWDER ROOM
- COMMON AREA

UNIT AREA SUMMARY

	GROUND FLOOR	SECOND FLOOR	THIRD FLOOR	TOTAL
UNIT 21	1,294 S.F.	-	-	1,294 S.F.
UNIT 22	1,602 S.F.	-	-	1,602 S.F.
UNIT 23	336 S.F.	1,302 S.F.	686 S.F.	2,324 S.F.
UNIT 24	340 S.F.	1,539 S.F.	685 S.F.	2,564 S.F.
UNIT 25	340 S.F.	1,102 S.F.	1,079 S.F.	2,521 S.F.
UNIT 26	341 S.F.	1,490 S.F.	1,047 S.F.	2,878 S.F.
UNIT 27	335 S.F.	-	2,044 S.F.	2,379 S.F.

I HEREBY CERTIFY THAT THIS PLAN HAS BEEN PREPARED IN CONFORMANCE WITH THE RULES AND REGULATIONS OF THE REGISTERS OF DEEDS.

I CERTIFY THAT THIS PLAN ACCURATELY AND FULLY DEPICTS THE AS-BUILT LAYOUT, LOCATION, UNIT NUMBER, DIMENSIONS, AND APPROXIMATE AREA OF THE UNITS AND DEPICTS THE MAIN ENTRANCE AND IMMEDIATE COMMON AREA TO WHICH THEY HAVE ACCESS.

DATE _____ ROBERT S. REGO, P.E.

**MARKET PLACE II CONDOMINIUM
PHASE III AS-BUILT UNIT PLANS
UNITS 21-27**

LOCATED AT
2 PROPRIETOR'S WAY
MARSHFIELD, MASSACHUSETTS

PREPARED FOR
AW ASSOCIATES, INC.

DATE: DECEMBER 11, 2025 SCALE: 1" = 5'



PREPARED BY:




RIVER HAWK ENVIRONMENTAL, LLC.
511 WEST GROVE ST., SUITE 301, MIDDLEBOROUGH, MA 02346
(774) 213 - 5429



VICINITY MAP
SCALE: 1" = 1000'

FOR REGISTRY USE ONLY

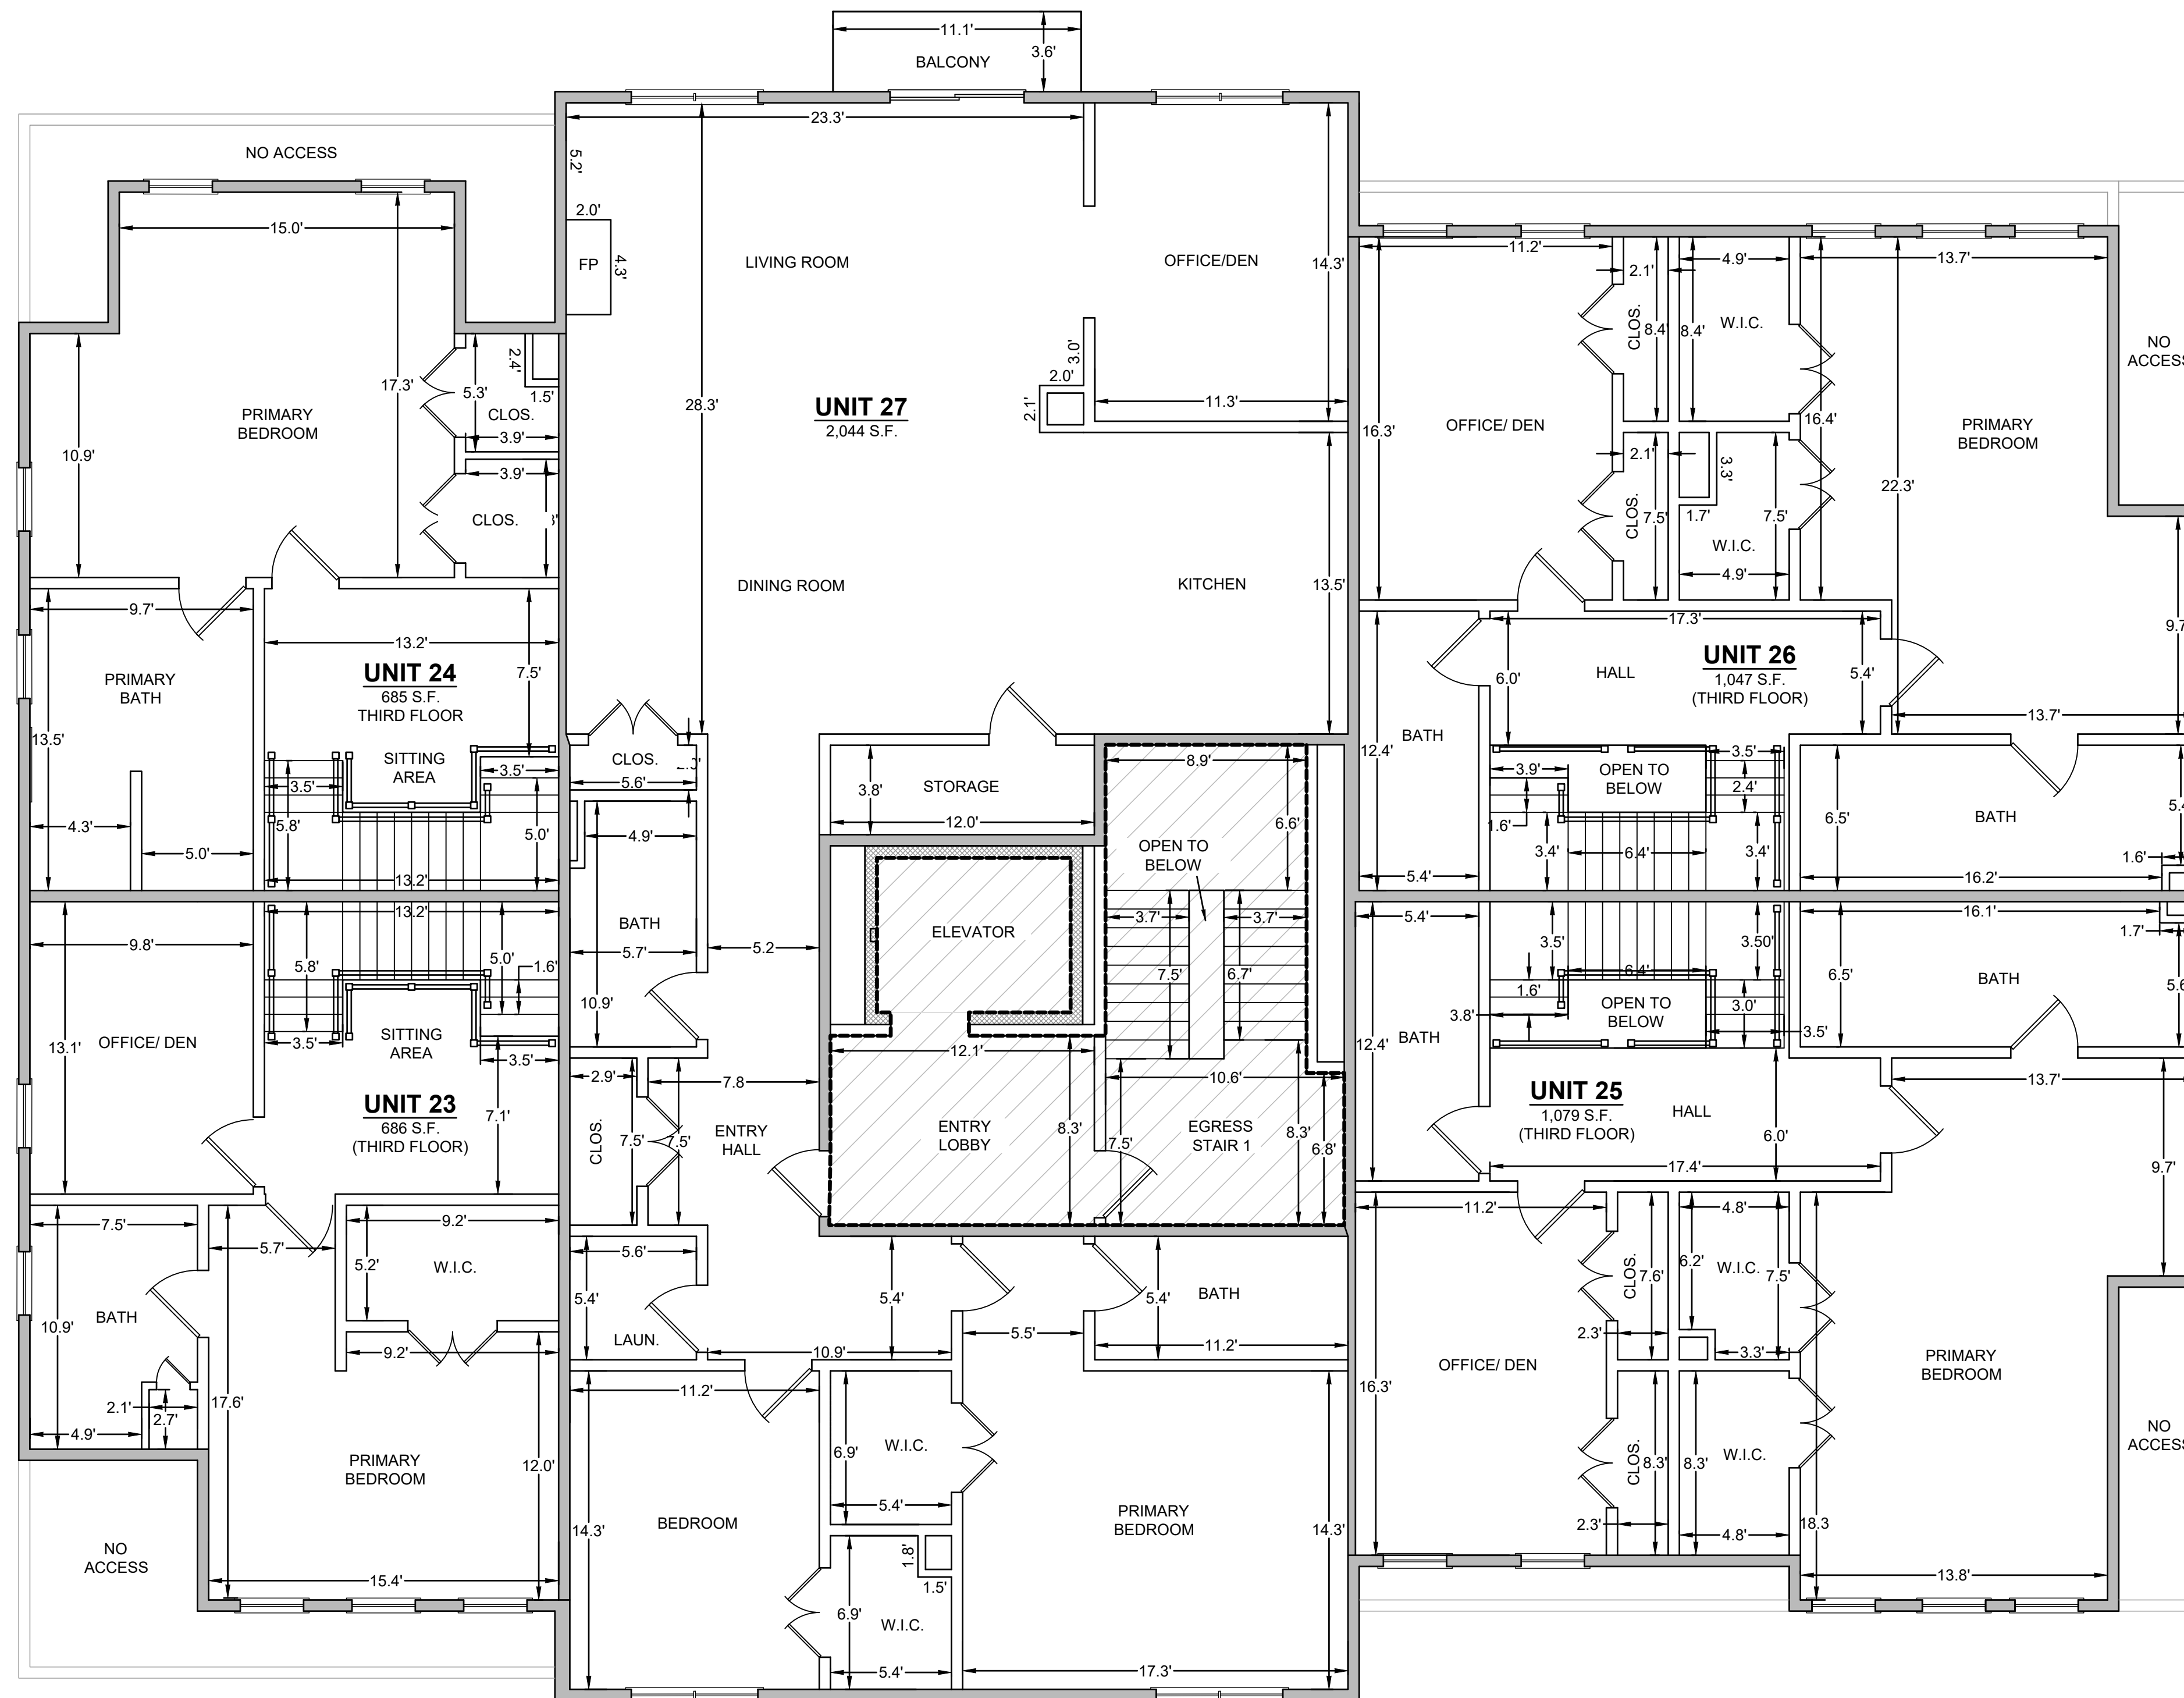

THIRD FLOOR PLAN

SCALE: 1" = 5'

ABBREVIATIONS

- W.I.C. WALK IN CLOSET
- S.F. SQUARE FEET
- LAUN. LAUNDRY
- SHOW. SHOWER
- CLOS. CLOSET
- P.D.R. POWDER ROOM
- COMMON AREA

UNIT AREA SUMMARY

	GROUND FLOOR	SECOND FLOOR	THIRD FLOOR	TOTAL
UNIT 21	1,294 S.F.	-	-	1,294 S.F.
UNIT 22	1,602 S.F.	-	-	1,602 S.F.
UNIT 23	336 S.F.	1,302 S.F.	686 S.F.	2,324 S.F.
UNIT 24	340 S.F.	1,539 S.F.	685 S.F.	2,564 S.F.
UNIT 25	340 S.F.	1,102 S.F.	1,079 S.F.	2,521 S.F.
UNIT 26	341 S.F.	1,490 S.F.	1,047 S.F.	2,878 S.F.
UNIT 27	335 S.F.	-	2,044 S.F.	2,379 S.F.

I HEREBY CERTIFY THAT THIS PLAN HAS BEEN PREPARED IN CONFORMANCE WITH THE RULES AND REGULATIONS OF THE REGISTERS OF DEEDS.

I CERTIFY THAT THIS PLAN ACCURATELY AND FULLY DEPICTS THE AS-BUILT LAYOUT, LOCATION, UNIT NUMBER, DIMENSIONS, AND APPROXIMATE AREA OF THE UNITS AND DEPICTS THE MAIN ENTRANCE AND IMMEDIATE COMMON AREA TO WHICH THEY HAVE ACCESS.

DATE _____ ROBERT S. REGO, P.E.

**MARKET PLACE II CONDOMINIUM
PHASE III AS-BUILT UNIT PLANS
UNITS 21-27**

LOCATED AT
2 PROPRIETOR'S WAY
MARSHFIELD, MASSACHUSETTS

PREPARED FOR
AW ASSOCIATES, INC.

DATE: DECEMBER 11, 2025 SCALE: 1" = 5'



PREPARED BY:

River Hawk
ENVIRONMENTAL

RIVER HAWK ENVIRONMENTAL, LLC.
511 WEST GROVE ST., SUITE 301, MIDDLEBOROUGH, MA 02346
(774) 213 - 5429