


Northwest Wastwater Solutions

1121 B Old Lakelse Lk Rd.

Filing # 0222233

As Built
Dec 3, 2010

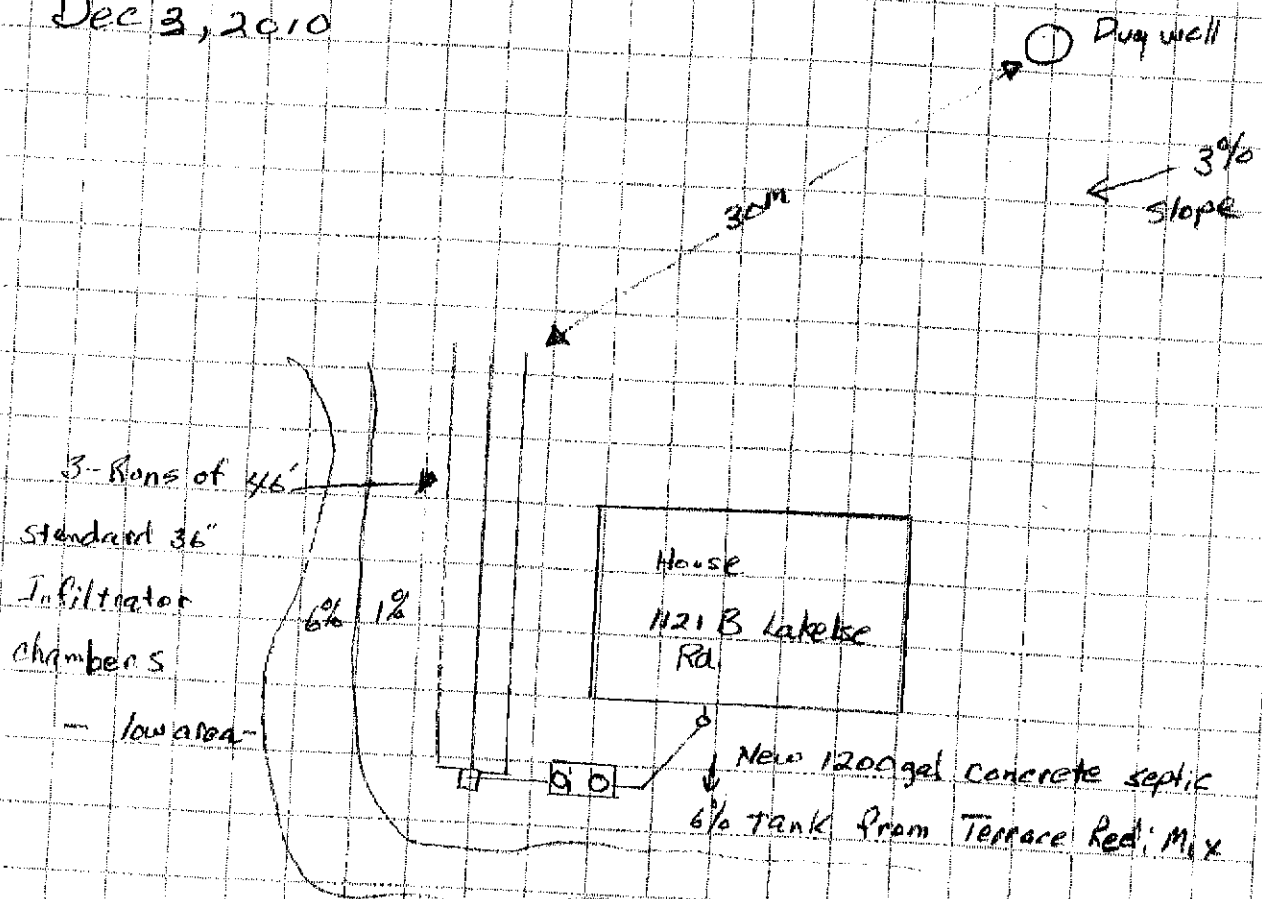

Approx 2' of imported fill over chambers
If surface is 150mm in natural soil of
gravelly sand/loam

> 1.3 meters to Seasonal High
water table