

Plan A Services Inc.
70 Gilbert St
Monroe NY 10950

718.219.4749

info@planaservices.com
planaservices.com

Project

17 Bannard St,
Freehold, NJ 07728,
United States

Drawing

 As-built
Floor Plan

A - 003.00


Area 5700 SF

Scale 3/8" = 1'-0"

Date 04/16/2022

Drawn By Author

Notes

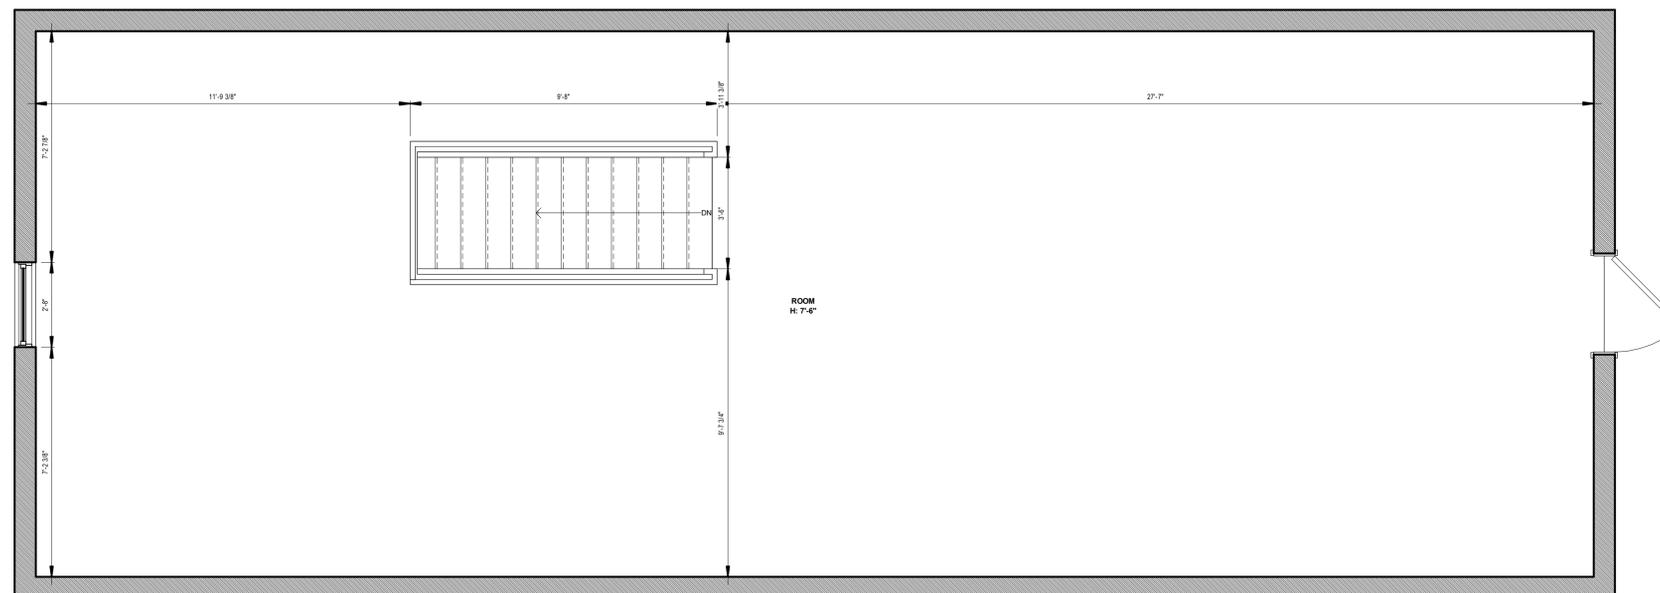

① As-built 3rd Floor
3/8" = 1'-0"

AREA - 850 SF
Building #7